

**BROOKE COUNTY COMMISSION
BROOKE COUNTY, WEST VIRGINIA**

BROOKE COUNTY EMS FACILITY

ADDENDUM #3

APRIL 4, 2023

THRASHER PROJECT #T60-11009

TO WHOM IT MAY CONCERN:

A Pre-Bid Conference was held on Tuesday, March 7, 2023, for the Brooke County EMS Facility project. The following are clarifications and responses to questions posed by contractors for the above reference project.

A. GENERAL

1. **THE BID FORM HAS BEEN REVISED. YOU MUST USE THE REVISED BID FORM WHEN PREPARING YOUR BID PACKAGE FOR THIS PROJECT.**
2. **THE BID DATE FOR THE PROJECT HAS BEEN EXTENDED TO TUESDAY APRIL 18, 2023, AT 10:00AM.**

B. SPECIFICATIONS

1. ADDED: 012300 – Alternates
2. ADDED: 066550 – Simulated Wood Trim
3. ADDED: 074633 – Plastic Siding
4. ADDED: 096119 – Interior Concrete Stain
5. REVISED: 074293 – Metal Panels, article 2.2.B. Change solid soffit, to perforated soffit. Change Basis of Design Product to Dimensional Metals, Inc. FP10.
6. OMIT: 211313 – Wet-pipe Fire suppression Sprinklers.

C. DRAWINGS

1. OMIT sheet A1.01 and REPLACE with A1.01(R)
2. OMIT sheet A1.02 and REPLACE with A1.02(R)
3. OMIT sheet A1.03 and REPLACE with A1.03(R)
4. OMIT sheet A2.01 and REPLACE with A2.01(R)

5. OMIT sheet A3.01 and REPLACE with A3.01(R)
6. OMIT sheet A3.02 and REPLACE with A3.02(R)
7. OMIT sheet A3.03 and REPLACE with A3.03(R)
8. OMIT sheet A5.01 and REPLACE with A5.01(R)
9. OMIT sheet A5.02 and REPLACE with A5.02(R)
10. OMIT sheet A5.03 and REPLACE with A5.03(R)
11. OMIT sheet A6.01 and REPLACE with A6.01(R)
12. OMIT sheet C2.01 and REPLACE with C2.01(R)
13. OMIT all structural drawings dated 2/24/2023 (S0.01 through S5.02) and REPLACE with structural drawings dated 4/4/2023 (S0.01 through S5.02)
14. NEW: sheet A1.04 Attic Plan
15. NEW: sheet A4.04 Exterior Stairs
16. NEW: sheet SK-P3.
17. NEW: sheet SK-P4

D. QUESTIONS AND RESPONSES

Q1. 7/8" Plywood is hard to locate currently. Can there be a substitution?

A1. The Ambulance Bay roof trusses are changed in this addendum. Roof sheathing for the ambulance bay is to be 5/8-inch plywood sheathing.

Q2. I see on drawing S1.02 for Redbuilt Trusses are called for on the apparatus side of the building. I see no specifications for them. Can you clarify if they are metal, and do you have a manufacture for them?

A2. The Ambulance Bay roof trusses are changed in this addendum. See attached drawings.

Q3. Structural drawings mention alternate bids, but bid form is for one lump sum. Please advise.

A3. The Ambulance Bay roof trusses are changed in this addendum. There are no alternates required for the structure.

Q4. Are the Red Built "S" trusses alternates – Bid Alternate note says provide 2 bid alternates, what is the base bid?

A4. The Ambulance Bay roof trusses are changed in this addendum. There are no alternates required for the structure.

Q5. Can you verify the 7/8 roof sheathing. Lumber supplier cannot locate.

A5. See A1. This addendum.

Q6. Would a nailbase roof sheathing be acceptable?

A6. Roof insulation is changed per this addendum. See attached drawings: A3.01(R) and A5.03(R).

Q7. P1.01 – cold water line is sized as 3/4" in kitchen (111), then appears to change to 1-1/2" in mechanical room (108) and then goes back down to 3/4" for sink in ADA restroom (105). Is this correct?

A7. See SK-P3 this addendum.

Q8. Another item is A7.01R in addendum 2 calls for alternate #1 for resinous floor but no line item on bid form for any alternates?

A8. See Revised Bid Form in this addendum.

Q9. The room finish has RB for base in the bathrooms, but the specs mention both bullnose base cap and Schluter Dilex-AHK. Which should we use in our estimate?

A9. Bathrooms will have ceramic wall and floor tile. Use Schluter Dilex-AHK

Q10. Drawing C2.01 shows incoming power from transformer under front entrance and the meter is on the north wall of bays. Please clarify.

A10. Power will feed from the nearest pole to the location of meter on the north wall. See attached C2.01R.

Q11. Will Duralife Lockers and Tufftech Bench by Scranton Products be considered as an acceptable substitution for Lockers and benches specified in Section 105113?

A11. Yes.

Q12. Do you intend for the gas line to be above or below ground for the natural gas powered generator added in addendum #2?

A12. Gas line will be below ground.

Q13. Sheet S1.01 notes 1/2 inch plywood sheathing for the walls, Sheet A5.02 notes 5/8 inch plywood sheathing. Which is correct?

A13. Plywood wall sheathing should be 1/2 inch as noted on structural drawings.

Q14. Is the Flagpole on C2.01 under our scope? Is there more information or specification available?

A14. Yes. See specification Section 107516 Ground-set Flagpoles.

Q15. I see that the FP drawing calls out a WET fire sprinkler system for the building, however, there appears to be an attic area for both sections to be framed with wooden trusses. This requires fire sprinkler protection as well, please advise if these attic areas will be conditioned with adequate heat to prevent the WET sprinkler from freezing or should this be protected with a DRY fire sprinkler system?

A15. A Dry-Pipe Sprinkler System is required. Omit wet pipe sprinkler system and replace with dry-pipe sprinkler system. Provide dry-pipe valve trim complete with air compressor and all accessories for a complete system. Provide designated 20-amp 120v/1Ø circuit for air compressor. Connect pressure switch to fire alarm system.

Q16. In the specs. for the Metal Wall Panels, there is a sub section for Metal Liner Panels. You have MBCI listed as a Manufacturer, however, based on the specs. provided (36" width, 1/2" height, flat panel, 29g) - MBCI does not have have a match to that. Could you please advise which option you would prefer:

(1. PBD – this panel is 32" width, 5/8" height, ribbed, 26g)

(2. PBU – this panel is 36" width, 3/4" height, ribbed, 26g)

(3. Artisan – This panel is 12" width, 1" height, flat, 24g)

A16. PBD - MBCI 32" W, 5/8" H is acceptable.

Q17. Door schedule calls for 1 3/8" door, but Door Specs. say 2" - please confirm.

A17. Overhead Sectional Doors should be 2" as described in the specifications.

Q18. R Value: 18.0deg F x h x sq. ft. / BTU?

A18. Overhead Sectional Doors should have an R-Value of R-18 as described in the specifications.

Q19. I have attached information for Haas Door Model 2014 and 616. Would it be possible to have them confirmed as an approved manufacturer?

A19. Haas Door Model CHT-2010 is acceptable.

Q20. The drawings call for a back-flow preventer on the 6" waterline, can a detail be provided for the vault that this needs to be installed in?

A20. Provide precast concrete vault with min. inside dimensions of 5' wide, 8' long, and 5' deep with an 48"x48" access hatch.

Q21. Is 2" SDR21 or 2" SDR9 pipe acceptable for the exterior 2" waterline? C900 is listed in the specification but to our knowledge this does not exist.

A21. 2" SDR21 or 2" SDR9 is acceptable for the exterior 2" waterline.

E. CLARIFICATIONS

1. Sealed, stained concrete flooring is limited to room #'s: 101, 102, 103, 104, 106, 107, 108, 109, 110, 111, 116, 117, 118, 119. Room #'s: 112, 113, 114, 115 are to receive Ceramic Tile as shown on drawing A7.01/A7.01R.
2. Plywood Roof Sheathing is to be 5/8 inch thick.
3. Rigid Insulation located above the roof deck has been removed and Batt Insulation has added at the bottom chord of the roof trusses.
4. Attic Lighting: ADD (5) L30 fixtures approximately 16'-0" o.c. Circuit to spare 1p/20a circuit breaker A-28, switch at door and (2) occupancy sensors to cover area. Add X1 fixture above door with remote emergency egress fixture R1 to illuminate stairs. Attic Convenience Outlets: ADD a duplex receptacle below switch at door and at opposite end of attic space. Circuit to same circuit as lights A-28.
5. Ambulance Bay: Provide (4) occupancy sensors to provide coverage for the ambulance bays. Coordinate spacing with sensor supplier to insure coverage. Provide means to override in (on) position so that if work is being done inside vehicles lights will not time off.
6. Power for Exterior Signage on Rear Wall: Provide junction box and conduit on exterior rear wall for owner provided signage. Coordinate location with owner prior to rough-in. Circuit to spare 1p/20a circuit breaker A-30.
7. Conduit and Boxes for CCTV: Provide 3/4" conduit and exterior rated junction boxes at all 5 exterior corners of building for owner supplied cameras. Coordinate mounting height and location of boxes prior to rough-in.

If you have any questions or comments, please feel free to contact me at your earliest convenience. As a reminder, bids will be received until 10:00 a.m. on Tuesday, April 18, 2023, at the Brooke County Courthouse, located at 632 Main Street, Wellsburg, WV. 26070. Good luck to everyone and thank you for your interest in the project.

Sincerely,

THE THRASHER GROUP, INC.



Philip M Freeman, AIA, NCARB, LEED Green Associate
Project Architect

BID FORM FOR CONSTRUCTION CONTRACT

The terms used in this Bid with initial capital letters have the meanings stated in the Instructions to Bidders, the General Conditions, and the Supplementary Conditions.

ARTICLE 1—OWNER AND BIDDER

1.01 This Bid is submitted to:

*Brooke County Commission
632 Main St.
Wellsburg, WV 26070*

1.02 The undersigned Bidder proposes and agrees, if this Bid is accepted, to enter into an Agreement with Owner in the form included in the Bidding Documents to perform all Work as specified or indicated in the Bidding Documents for the prices and within the times indicated in this Bid and in accordance with the other terms and conditions of the Bidding Documents.

ARTICLE 2—ATTACHMENTS TO THIS BID

2.01 The following documents are submitted with and made a condition of this Bid:

A. Bid Opening Requirements

ARTICLE 3—BASIS OF BID—LUMP SUM BID AND UNIT PRICES

GENERAL

The Bidder shall take notice of and shall be responsible for any local or state taxes levied and applicable, and the cost for the same shall be included as part of the submitted Bid.

The total Bid cost stated includes a complete operating installation including furnishing and installation of any and all changes or additions in plans, piping, mechanical work, additional electrical work, accessories, controls, etc. necessary to accommodate alternative equipment systems or materials used in construction.

BID PROPOSAL

The Bidder agrees to perform all required Work described in the detailed Specifications and as shown on the Plans for the complete construction and placing in satisfactory operation for the Brooke County EMS Facility. The Project "Sequence of Construction" has been detailed in the Drawings and Specification Division 1, Project Summary, Section 011000. The Bidder agrees to perform all the Work proposed for the total of the following Bid prices.

3.01 *Lump Sum Bids*

A. Bidder will complete the Work in accordance with the Contract Documents for the lump sum (stipulated) price(s), shown in the bid schedule.

B. Lump Sum Bids may be one of the following:

1. Lump Sum Price (Single Lump Sum)

2. Lump Sum Price (Base Bid and Alternates)
 3. Lump Sum Price (Sectional Lump Sum Bids)
- C. All specified cash allowance(s) are included in the price(s) set forth in the bid schedule, and have been computed in accordance with Paragraph 3.8 of the General Conditions.
- D. All specified contingency allowances are included in the price(s) set forth in the bid schedule, and have been computed in accordance with Paragraph 3.8 of the General Conditions.

BID SCHEDULE

**PROPOSED
 BROOKE COUNTY COMMISSION
 FOR THE**

**BROOKE COUNTY EMS FACILITY
 BROOKE COUNTY, WEST VIRGINIA**

3.02 Total Bid Price Lump Sum

NOTE: Bid PRICE amounts are to be shown in both words and figures. In case of discrepancy, the amount shown in words will govern. Bids shall include sales tax and all other applicable taxes and fees.

| Item # | Qty. | UNIT | DESCRIPTION | TOTAL PRICE |
|--------|------|------|---|-------------|
| 1 | 1 | LS | <i>Provide all labor, materials, equipment, fees, bonds, insurance and taxes to perform the work as detailed in the plans and specifications and addenda.</i> | |

TOTAL BID: _____
 (Written in Words)

(Amounts are to be shown in both words and figures. In case of discrepancy, the amount shown in words will govern.)

ADDITIVE ALTERNATE #1

| Item # | Qty. | UNIT | DESCRIPTION | TOTAL PRICE |
|--------|------|------|--|-------------|
| 1 | 1 | LS | Resinous Flooring – in Room #'s 101, 102, 103, 104, 106, 107, 108, 109, 110, 111, 116, 117, 118, 119 as indicated on Drawing A7.01R Floor Finish Plan – Revision 2 and as specified in Section 096723 Resinous Flooring. | |

TOTAL ADD ALTERNATE #1: _____
 (Written in Words)

3.02 *Method of Award*

Method of Award = Lowest Qualified Bidder (Regular)

If at the time this contract is to be awarded, the lowest total bid submitted by a qualified, responsive, responsible Bidder does not exceed the amount of funds then estimated by the Owner, as available to finance the contract, the construction contract will be awarded. If such bids exceeds such amount, the owner may reject all bids.

- A. Unit prices have been computed in accordance with paragraph 13.03.A of the General Conditions.
- B. Bidder acknowledges that estimated quantities are not guaranteed and are solely for the purpose of comparison of Bids, and final payment for all Unit Price Bid items will be based on actual quantities, determined as provided in the Contract Documents.

~~**ARTICLE 4—BASIS OF BID—COST PLUS FEE**~~

~~Deleted~~

~~**ARTICLE 5—PRICE PLUS TIME BID**~~

~~Deleted~~

ARTICLE 6—TIME OF COMPLETION

- 6.01 Bidder agrees that the Work will be substantially complete and will be completed and ready for final payment in accordance with Article 8 of the General Conditions on or before the dates or within the number of calendar days indicated in the Agreement.
- 6.02 Bidder accepts the provisions of the Agreement as to liquidated damages.

**ARTICLE 7—BIDDER'S ACKNOWLEDGEMENTS: ACCEPTANCE PERIOD,
INSTRUCTIONS, AND RECEIPT OF ADDENDA**

7.01 *Bid Acceptance Period*

- A. This Bid will remain subject to acceptance for 90 days after the Bid opening, or for such longer period of time that Bidder may agree to in writing upon request of Owner.

7.02 *Instructions to Bidders*

- A. Bidder accepts all of the terms and conditions of the Instructions to Bidders, including without limitation those dealing with the disposition of Bid security.

7.03 *Receipt of Addenda*

- A. Bidder hereby acknowledges receipt of the following Addenda:

| Addendum Number | Addendum Date |
|-----------------|---------------|
| | |
| | |
| | |

ARTICLE 8—BIDDER’S REPRESENTATIONS AND CERTIFICATIONS

8.01 *Bidder’s Representations*

A. In submitting this Bid, Bidder represents the following:

1. Bidder has examined and carefully studied the Bidding Documents, including Addenda.
2. Bidder has visited the Site, conducted a thorough visual examination of the Site and adjacent areas, and become familiar with the general, local, and Site conditions that may affect cost, progress, and performance of the Work.
3. Bidder is familiar with all Laws and Regulations that may affect cost, progress, and performance of the Work.
4. Bidder has carefully studied the reports of explorations and tests of subsurface conditions at or adjacent to the Site and the drawings of physical conditions relating to existing surface or subsurface structures at the Site that have been identified in the Supplementary Conditions, with respect to the Technical Data in such reports and drawings.
5. Bidder has carefully studied the reports and drawings relating to Hazardous Environmental Conditions, if any, at or adjacent to the Site that have been identified in the Supplementary Conditions, with respect to Technical Data in such reports and drawings.
6. Bidder has considered the information known to Bidder itself; information commonly known to contractors doing business in the locality of the Site; information and observations obtained from visits to the Site; the Bidding Documents; and the Technical Data identified in the Supplementary Conditions or by definition, with respect to the effect of such information, observations, and Technical Data on (a) the cost, progress, and performance of the Work; (b) the means, methods, techniques, sequences, and procedures of construction to be employed by Bidder, if selected as Contractor; and (c) Bidder’s (Contractor’s) safety precautions and programs.
7. Based on the information and observations referred to in the preceding paragraph, Bidder agrees that no further examinations, investigations, explorations, tests, studies, or data are necessary for the performance of the Work at the Contract Price, within the Contract Times, and in accordance with the other terms and conditions of the Contract.
8. Bidder is aware of the general nature of work to be performed by Owner and others at the Site that relates to the Work as indicated in the Bidding Documents.
9. Bidder has given Engineer written notice of all conflicts, errors, ambiguities, or discrepancies that Bidder has discovered in the Bidding Documents, and of discrepancies between Site conditions and the Contract Documents, and the written resolution thereof by Engineer is acceptable to Contractor.
10. The Bidding Documents are generally sufficient to indicate and convey understanding of all terms and conditions for performance and furnishing of the Work.
11. The submission of this Bid constitutes an incontrovertible representation by Bidder that without exception the Bid and all prices in the Bid are premised upon performing and furnishing the Work required by the Bidding Documents.

8.02 *Bidder's Certifications*

A. The Bidder certifies the following:

1. This Bid is genuine and not made in the interest of or on behalf of any undisclosed individual or entity and is not submitted in conformity with any collusive agreement or rules of any group, association, organization, or corporation.
2. Bidder has not directly or indirectly induced or solicited any other Bidder to submit a false or sham Bid.
3. Bidder has not solicited or induced any individual or entity to refrain from bidding.
4. Bidder has not engaged in corrupt, fraudulent, collusive, or coercive practices in competing for the Contract. For the purposes of this Paragraph 8.02.A:
 - a. Corrupt practice means the offering, giving, receiving, or soliciting of anything of value likely to influence the action of a public official in the bidding process.
 - b. Fraudulent practice means an intentional misrepresentation of facts made (a) to influence the bidding process to the detriment of Owner, (b) to establish bid prices at artificial non-competitive levels, or (c) to deprive Owner of the benefits of free and open competition.
 - c. Collusive practice means a scheme or arrangement between two or more Bidders, with or without the knowledge of Owner, a purpose of which is to establish bid prices at artificial, non-competitive levels.
 - d. Coercive practice means harming or threatening to harm, directly or indirectly, persons or their property to influence their participation in the bidding process or affect the execution of the Contract.

BIDDER hereby submits this Bid as set forth above:

Bidder:

(typed or printed name of organization)

By: _____
(individual's signature)

Name: _____
(typed or printed)

Title: _____
(typed or printed)

Date: _____
(typed or printed)

If Bidder is a corporation, a partnership, or a joint venture, attach evidence of authority to sign.

Attest: _____
(individual's signature)

Name: _____
(typed or printed)

Title: _____
(typed or printed)

Date: _____
(typed or printed)

Address for giving notices:

Bidder's Contact:

Name: _____
(typed or printed)

Title: _____
(typed or printed)

Phone: _____

Email: _____

Address: _____

Bidder's Contractor License No.: (if applicable) _____

SECTION 012300 - ALTERNATES

PART 1 - GENERAL

1.1 SUMMARY

- A. Section includes administrative and procedural requirements for alternates.

1.2 DEFINITIONS

- A. Alternate: An amount proposed by bidders and stated on the Bid Form for certain work defined in the bidding requirements that may be added to or deducted from the base bid amount if the Owner decides to accept a corresponding change either in the amount of construction to be completed or in the products, materials, equipment, systems, or installation methods described in the Contract Documents.
 - 1. Alternates described in this Section are part of the Work only if enumerated in the Agreement.
 - 2. The cost or credit for each alternate is the net addition to or deduction from the Contract Sum to incorporate alternates into the Work. No other adjustments are made to the Contract Sum.

1.3 PROCEDURES

- A. Coordination: Revise or adjust affected adjacent work as necessary to completely integrate work of the alternate into Project.
 - 1. Include as part of each alternate, miscellaneous devices, accessory objects, and similar items incidental to or required for a complete installation whether or not indicated as part of alternate.
- B. Execute accepted alternates under the same conditions as other work of the Contract.
- C. Schedule: A schedule of alternates is included at the end of this Section. Specification Sections referenced in schedule contain requirements for materials necessary to achieve the work described under each alternate.

PART 2 - PRODUCTS (Not Used)

PART 3 - EXECUTION

3.1 SCHEDULE OF ALTERNATES

A. Alternate No. 1: Resinous Flooring.

1. Base Bid: Sealed, Stained Concrete Floor in Room #'s: 101, 102, 103, 104, 106, 107, 108, 109, 110, 111, 116, 117, 118, 119 as indicated on Drawing A7.01R Floor Finish Plan and as specified in Section 096119 "Interior Stained Concrete."
2. Alternate: Resinous Flooring in Room #'s: 101, 102, 103, 104, 106, 107, 108, 109, 110, 111, 116, 117, 118, 119 as indicated on Drawing A7.01R Floor Finish Plan – Revision 2 and as specified in Section 096723 "Resinous Flooring."

END OF SECTION 012300

SECTION 066550 – SIMULATED WOOD TRIM

PART 1 - GENERAL

1.1 SUMMARY

A. Section Includes

1. Simulated Wood Trimboards.

1.2 RELATED SECTIONS

- A. Section 061100 - Wood Framing.
- B. Section 07910 - Joint Sealants.

1.3 REFERENCES

- A. ASTM D 792 – Density and Specific Gravity of Plastics by Displacement.
- B. ASTM D 570 – Water Absorption of Plastics.
- C. ASTM D 638 – Tensile Property of Plastics.
- D. ASTM D 790 – Flexural Properties of Unreinforced and Reinforced Plastics and Electrical Insulating Materials.
- E. ASTM D 792 - Standard Test Methods for Density and Specific Gravity (Relative Density) of Plastics by Displacement.
- F. ASTM D 1761- Mechanical Fasteners in Wood.
- G. ASTM D 5420 – Standard Test Method for Impact Resistance of Flat, Rigid Plastic Specimen by means of a Striker Impacted by Falling Weight.
- H. ASTM D 256 – Determining the Pendulum Impact Resistance of Plastics.
- I. ASTM D 696 – Coefficient of Linear Thermal Expansion of Plastics Between -30 deg C and 30 deg C with a Vitreous Silica Dilatometer.
- J. ASTM D 635 - Rate of Burning and/or Extent and Time of Burning of Plastics in a Horizontal Position.
- K. ASTM E 84 – Surface Burning Characteristics of Building Materials
- L. ASTM D 648 – Deflection Temperature of Plastics Under Flexural Load in Edgewise Position.
- M. ASTM 3679 – Standard Specification for Rigid Poly Vinyl Chloride (PVC) Siding.

1.4 SUBMITTALS

- A. Submit under provisions of Section 013000.
- B. Product Data: Manufacturer's data sheets on each product to be used, including:
 - 1. Preparation instructions and recommendations.
 - 2. Storage and handling requirements and recommendations.
 - 3. Installation methods, including nailing patterns.
- C. Verification Samples: For each finish profile specified, two samples, minimum size 6 inches long, representing actual product color and patterns finish.
- D. Manufacturer's Certificates: Certify products meet or exceed specified requirements.

1.5 QUALITY ASSURANCE

- A. Manufacturer Qualifications: A minimum of 10 years in the manufacture of PVC products.
- B. Installer Qualifications: A minimum of 3 years in the installation of PVC products.

1.6 DELIVERY, STORAGE, AND HANDLING

- A. Store products in manufacturer's unopened packaging until ready for installation.
- B. Protect materials from exposure to moisture. Do not deliver until after wet work is complete and dry.

1.7 PROJECT CONDITIONS

- A. Maintain environmental conditions (temperature, humidity, and ventilation) within limits recommended by manufacturer for optimum results. Do not install products under environmental conditions outside manufacturer's absolute limits.

1.8 WARRANTY

- A. Warranted to the original Owner under normal and proper use to be free of manufacturing defects for not less than a period of 25 years.

1.9 COORDINATION

- A. Coordinate Work with other operations and installation of trim to avoid damage to installed materials.

PART 2 PRODUCTS

2.1 MANUFACTURERS

- A. Manufacturers: Subject to compliance with requirements, provide products by one of the following:
 - 1. The Azek Company
 - 2. CertainTeed Corporation
- B. Requests for substitutions will be considered in accordance with provisions of Section 016000.

2.2 MATERIAL

- A. General: Free foam Cellular PVC that is homogenous and free of voids, holes, cracks, and foreign inclusions and other defects. Edges must be square and top and bottom surfaces shall be flat with no convex or concave deviation.
- B. Physical Properties: Free foam cellular PVC material with a small-cell microstructure of 0.60 grams/cm³ in accordance with ASTM D 792 with the following physical and performance properties:
 - 1. Mechanical:
 - a. Tensile Strength: ≥ 1250 psi when tested in accordance with ASTM D 638.
 - b. Tensile Modulus: $\geq 79,450$ psi when tested in accordance with ASTM D 638.
 - c. Flexural Strength: ≥ 3325 psi when tested in accordance with ASTM D 790.
 - d. Nail Hold: 35 lbf/in of penetration when tested in accordance with ASTM D 1761.
 - e. Screw Hold: 590 lbf/in of penetration when tested in accordance with ASTM D 1761.
 - f. Gardner Impact: 16 in-lbs when tested in accordance with ASTM D 4226.
 - g. Charpy Impact (23 deg C): 4.5 ft-lbs/in when tested in accordance with ASTM D 256.
 - 2. Thermal:

- a. Coefficient of Linear Expansion: 3.2×10^{-5} in/in/deg F when tested in accordance with ASTM D 696.
 - b. Burning Rate: No burn when flame removed when tested in accordance with ASTM D 635.
 - c. Flame Spread Index: ≥ 25 when tested in accordance with ASTM E 84.
3. Manufacturing Tolerances:
- a. Variation in component length: minus 0.00 plus 1.00 inch.
 - b. Variation in component width: plus or minus 1/16 inch.
 - c. Variation in component edge cut: plus or minus 2 degrees.
 - d. Variation in Density: minus 0 percent to plus 10 percent.

2.3 SIMULATED WOOD TRIM

A. General:

Provide paintable simulated wood trim to the following profiles and to the configurations indicated on the Drawings.

B. Trim Boards:

1. Nominal Thickness: 1 inch (3/4" actual).
2. Nominal Width:
 - a. 4 inches.
 - b. 6 inches.
3. Finish: Woodgrain Natural White.

C. One-Piece Corner Trim:

1. Nominal Thickness: 5/4 inches.
Nominal Size:
 - a. 6 inches (152 mm) by 6 inches (152 mm) by 10 feet (3.05 m) long.
2. Finish:
 - a. Woodgrain Natural White.

2.4 ACCESSORIES

A. Fasteners:

1. Use fasteners designed for wood trim and siding (thinner shank, blunt point, full round head).
2. Use a highly durable fastener such as stainless steel or hot dipped galvanized steel.
3. Staples, small brads and wire nails must not be used as fastening members.
4. Fasteners should be long enough to penetrate a solid wood substrate a minimum of 1-1/2 inch (38 mm).
5. The use of standard nail guns is acceptable.
6. Use two fasteners per every framing member for trimboard applications. Use additional fasteners for trimboards 12 inches (305 mm) or wider, as well as sheets.
7. Install fasteners no more than 2 inches (51 mm) from the end of the board.
8. Fasten trim into a flat, solid substrate. Fastening trim into hollow or uneven areas must be avoided.
9. Pre-drilling is typically not required unless a large fastener is used or product is being installed in low temperatures.

B. Adhesives:

1. Glue all trim joints (scarf or miter) with a cellular PVC cement/adhesive such as TrimTight or Extreme PVC TrimWelder.
2. Glue joints should be secured with a fastener and/or fastened on each side of the joint to allow adequate bonding time.
3. Surfaces to be glued should be smooth, clean and in complete contact with each other.
4. Various adhesives may be used. Consult adhesive manufacturer to determine suitability.

C. Sealants:

1. Use sealants recommended by the manufacturer.

PART 3 EXECUTION

3.1 EXAMINATION

- A. Do not begin installation until substrates have been properly prepared.
- B. Prior to installation, verify governing dimensions of and condition of substrate.

- C. If substrate preparation is the responsibility of another installer, notify Architect of unsatisfactory preparation before proceeding.

3.2 PREPARATION

- A. Clean surfaces thoroughly prior to installation.
- B. Examine, clean, and repair as necessary any substrate conditions that would be detrimental to proper installation.
- C. Prepare surfaces using the methods recommended by the manufacturer for achieving the best result for the substrate under the project conditions.

3.3 INSTALLATION

- A. Install in accordance with manufacturer's instructions.
1. Comply with all terms necessary to maintain warranty coverage.
 2. Use trim details indicated on Drawings.
 3. Touch up all field cut edges before installing.
- B. Cutting:
1. Use carbide tipped blades designed to cut wood. Do not use fine-tooth metal-cutting blades or plywood blades.
 2. Avoid rough edges from cutting caused by: excessive friction, poor board support, worn saw blades or badly aligned tools.
- C. Drilling:
1. Drill with standard woodworking drill bits.
 2. Do not use bits made for rigid PVC.
 3. Avoid frictional heat build-up and remove shavings from the drill hole frequently.
- D. Milling:
1. Mill using standard milling machines used to mill lumber.
 2. Relief angle 20 to 30 degrees.
 3. Cutting speed to be optimized with the number of knives and feed rate.
- E. Routing:

1. Use sharp carbide tipped router bits.

F. Edge Finishing:

1. Use machine edging, sanding, grinding, or filling to finish edges.

G. Nail Location:

1. Refer to fastening schedule and diagrams in the most current version of the manufacturer's installation manual for recommended fastener spacing.
2. Install fasteners no more than 3/4 inches (19 mm) from the end of each board.

H. Thermal Expansion and Contraction:

1. Expansion and contraction will occur with changes in temperature.
2. When properly fastened, allow 1/4 inch (6 mm) per 18 foot (5.49 m) for expansion and contraction.
3. Joints between pieces should be glued to eliminate joint separation. When gaps are glued on a long run, allow for expansion and contraction at the end of the runs.

I. Finishing.

1. Correct dents and gouges before applying final coating.
2. Prepare surfaces and paint materials as recommended by the molding manufacturer.
3. If moldings get dirty during installation, clean with a soft bristle brush and a bucket of soapy water. For stubborn stains, mold or mildew, use a cleaner suitable for PVC products.

3.4 PROTECTION

A. Protect installed products until completion of project.

B. Touch-up, repair or replace damaged products before Substantial Completion.

END OF SECTION

Brooke County Commission
Brooke County EMS Facility

T60-11009
ADDED: ADDENDUM 3
April 4, 2023

This page is intentionally left blank.

SECTION 074633 - PLASTIC SIDING

PART 1 - GENERAL

1.1 SUMMARY

- A. Section includes vinyl siding.

1.2 ACTION SUBMITTALS

- A. Product Data: For each type of product.
 - 1. For vinyl siding, include VSI's official certification logo printed on Product Data.
- B. Samples: For vinyl siding including related accessories.

1.3 INFORMATIONAL SUBMITTALS

- A. Qualification Data: For vinyl siding Installer.
- B. Product certificates.
- C. Research/evaluation reports.
- D. Sample warranty.

1.4 CLOSEOUT SUBMITTALS

- A. Maintenance data.

1.5 QUALITY ASSURANCE

- A. Vinyl Siding Installer Qualifications: A qualified installer who employs a VSI-certified Installer on Project.

1.6 WARRANTY

- A. Special Warranty: Manufacturer agrees to repair or replace products that fail in materials or workmanship within specified warranty period.
 - 1. Warranty Period: 20 years from date of Substantial Completion.

PART 2 - PRODUCTS

2.1 POLYPROPYLENE SIDING

- A. Polypropylene Siding: Integrally colored product complying with ASTM D3679.
 - 1. Manufacturers: Subject to compliance with requirements, provide products by one of the following:
 - a. Alside Exterior Building Products.
 - b. Azek Building Products
 - c. CertainTeed; SAINT-GOBAIN.
 - d. Gentek Building Products, Inc.
 - e. ProVia.
- B. Shingle Pattern: 48-inch- wide, straight-edge notched with 5 inch exposure
- C. Texture: Wood grain.
- D. Minimum Profile Depth (Butt Thickness): 1/2 inch.
- E. Nailing Hem: Double thickness.
- F. Finish: Wood-grain print with clear protective coating containing not less than 70 percent PVDF.
 - 1. Colors: As selected by Architect from manufacturer's full range of colors.

2.2 ACCESSORIES

- A. Siding Accessories, General: Provide starter strips, edge trim, outside and inside corner caps, and other items as recommended by siding manufacturer for building configuration.
 - 1. Provide accessories made from same material as matching color and texture of adjacent siding unless otherwise indicated.
- B. Vinyl Accessories: Integrally colored vinyl accessories complying with ASTM D3679 except for wind-load resistance.
 - 1. Texture: Wood grain.
- C. Colors for Decorative Accessories: Match adjacent siding.
- D. Flashing: Provide aluminum flashing at window and door heads and where indicated.
 - 1. Finish for Aluminum Flashing: High-performance organic finish, same color as siding.
- E. Fasteners:
 - 1. For fastening to wood, use siding nails of sufficient length to penetrate a minimum of 1 inch into substrate.

2. For fastening vinyl, use hot-dip galvanized fasteners. Where fasteners are exposed to view, use prefinished aluminum fasteners in color to match item being fastened.

PART 3 - EXECUTION

3.1 INSTALLATION

- A. General: Comply with manufacturer's written installation instructions applicable to products and applications indicated unless more stringent requirements apply.
 1. Center nails in elongated nailing slots without binding siding to allow for thermal movement.
- B. Install PVC siding and related accessories according to ASTM D4756.
 1. Install fasteners for horizontal vinyl siding no more than 16 inches o.c.
 2. Install fasteners for vertical vinyl siding no more than 12 inches o.c.
- C. Install joint sealants as specified in Section 079200 "Joint Sealants" and to produce a weathertight installation.

3.2 ADJUSTING AND CLEANING

- A. Remove damaged, improperly installed, or otherwise defective materials and replace with new materials complying with specified requirements.
- B. Clean finished surfaces according to manufacturer's written instructions and maintain in a clean condition during construction.

END OF SECTION 074633

Brooke County Commission
Brooke County EMS Facility

T60-11009
ADDED: ADDENDUM 3
April 4, 2023

This page is intentionally left blank.

SECTION 096119 – INTERIOR STAINED CONCRETE

PART 1 - GENERAL

1.1 SUMMARY

A. Section includes:

1. Water-based reactive stained concrete floor finish.

B. Related Sections:

1. Section 033000 “Cast-In-Place Concrete” for general concrete applications.
2. Section 079200 “Joint Sealants” for colored sealant installed in paving joints.

1.2 PREINSTALLATION MEETINGS

- A. Preinstallation Conference: Conduct conference at Project site.

1.3 REFERENCES

A. ASTM International (ASTM):

1. ASTM C 171: Standard Specification for Sheet Materials for Curing Concrete.
2. ASTM C 309: Standard Specification for Liquid Membrane-Forming Compounds for Curing Concrete.

B. International Concrete Repair Institute (ICRI):

1. ICRI Technical Guidelines: Series 300 - Concrete, Designation 310 - Surface Preparation.

1.4 SUBMITTALS

- A. Product Data: Manufacturer’s technical data, including Safety Data Sheet (SDS) and installation instructions, for each product specified.

- B. Samples for Initial Selection: Manufacturer’s color charts showing full range of colors available.

- C. Qualification Data: For manufacturer and Installer.

1.5 QUALITY ASSURANCE

- A. Manufacturer Qualifications: Minimum 10 years of documented experience in the production, sales, and technical support of the specified products.
- B. Installer Qualifications: Minimum 3 years of documented experience with work of similar scope and complexity required by this Project and acceptable to, or certified by, concrete stain manufacturer.
- C. Material Source Limitations: Obtain each specified material from the same source.
- D. Notification: Give a minimum 7 calendar days' notice to manufacturer's authorized field representative before date established for commencement of concrete stain work.
- E. Concrete Stain Mockups:
 - 1. Construct a 6 foot by 6 foot mockup at location selected by Architect.
 - 2. Provide individual mockups for each color required.
 - 3. Construct mockup using materials, processes, and techniques required for the work, including curing procedures. Incorporate representative control, construction, and expansion joints according to Project requirements. Installer for the work to construct mockup.
 - 4. Mockup to be stained and sealed by the Installer who will actually perform the work for the Project. Record the amount of chemical stain needed per square foot of application to establish coverage rates for the work.
 - 5. Notify Architect and Owner a minimum of seven calendar days in advance of the date scheduled for each mockup construction.
 - 6. Obtain the Architect's and Owner's acceptance of each mockup prior to commencement of the work.
 - 7. Each mockup to remain until completion of the work to serve as a quality control standard for the work. Provide suitable protections to preclude damage to mockup.
 - 8. Approved mockup area must be refinished as required to become part of the completed work

1.6 DELIVERY, STORAGE, AND HANDLING

- A. Deliver products in original factory unopened, undamaged packaging bearing identification of product, manufacturer, batch number, and expiration date as applicable.
- B. Store products in a location protected from damage, construction activity, and adverse environmental conditions, and away from combustible materials and sources of heat, according to manufacturer's printed instructions and current recommendations.
- C. Handle products according to manufacturer's printed instructions.

1.7 PROJECT CONDITIONS

- A. Environmental Conditions: Maintain an ambient temperature between 50 deg F and 90 deg F during application and at least 48 hours after application.

PART 2 - PRODUCTS

2.1 WATER BASED INTERIOR CONCRETE STAIN

- A. Basis of Design Product
 - 1. H & C Decorative Concrete Products
 - a. Infusion – Water Based Semi-Transparent Stain
- B. Manufacturers: Subject to compliance with requirements, provide products by one of the following:
 - 1. Sika Corporation
 - 2. SureCrete LLC
 - 3. Americrete, LLC

2.2 MATERIALS

- 1. Color(s): As selected by Architect from manufacturer's full range.
- 2. UV Resistant
- 3. VOC: > 50 g/L

PART 3 - EXECUTION

3.1 EXAMINATION

- A. Examine areas and conditions under which the concrete stain work will be performed and identify conditions detrimental to the proper and timely completion of the work. Do not proceed until unsatisfactory conditions have been corrected.

3.2 PREPARATION

- A. New Concrete: Comply with the following:
 - 1. Concrete shall be as specified in Section 033000. Minimum cure time is 28 days.
 - 2. Clean surfaces thoroughly, in accordance with manufacturer's instructions.
 - 3. Prepare concrete surface in accordance with manufacturer's instructions.
 - 4. Protection:
 - a. Protect walls and surrounding surfaces not to receive concrete floor stain.
 - b. Do not allow stain to come in contact with wood or metal surfaces.

3.3 CONCRETE STAIN APPLICATION

- A. Apply concrete stains at the coverage rate recommended by the manufacturer and use application equipment according to the concrete stain manufacturer's instructions.
- B. Control depth of color by adjusting volume of stain applied

- C. Apply 2 coats of stain. Do not scrub clean between coats.
- D. Allow to completely dry prior to sealing.

3.4 SEALER APPLICATION

- A. After the final penetrating stain application has dried sufficiently, normally 8 to 24 hours at 75 degrees F and 50 percent relative humidity, remove all contaminants from surfaces by dry mopping if required.
- B. Conduct a moisture vapor emission test prior to applying any coating. Refer to the specific sealers Technical Data Bulletin for acceptable MVER.
- C. Apply sealer according the sealer manufacturer's printed instructions at a rate of 300 to 400 square feet per gallon per coat, maintaining a wet edge at all times. Two coats are required. Maintain a wet edge at all times.
- D. Allow sealer to completely dry before applying additional coats.
- E. Apply second coat of sealer at 90 degrees to the direction of the first coat using the same application method and rates.
- F. Seal horizontal joints in areas subject to pedestrian.

3.5 PROTECTION

- B. The General Contractor is responsible for using Temporary Floor Protection throughout the project to safeguard the surface quality of concrete slabs before and after application of decorative finishes or installations of other materials.
- C. All concrete floors that will be not be covered by other materials will be protected throughout the project. The concrete slab must be treated as a finished floor at all times during construction.
- D. Temporary Floor Protection will be removed only while finish work to the concrete is being performed and will be replaced after the final finish has cured sufficiently.
- E. Do not apply the heavy duty seaming tape to bare or finished floors or wall surfaces at any time.

3.6 MAINTENANCE

- A. Maintain water-based reactive stained and sealed floors by sweeping. Clean spills when they occur and rinse dirt off with water. Wet-clean heavily soiled areas by mopping or by scrubbing with a rotary floor machine equipped with a scrubbing brush and a suitable, high quality commercial detergent. Maintain interior floors that require polishing by using a compatible, premium-grade, emulsion-type, commercial floor polish, according to manufacturer's printed instructions and safety requirements.

END OF SECTION 033619

SECTION 074293 - SOFFIT PANELS (R)

PART 1 - GENERAL

1.1 SUMMARY

A. Section Includes:

1. Metal soffit panels.

1.2 PREINSTALLATION MEETINGS

- A. Preinstallation Conference: Conduct conference at Project site.

1.3 ACTION SUBMITTALS

- A. Product Data: For each type of product.
- B. Shop Drawings: Include fabrication and installation layouts of metal panels; details of edge conditions, joints, panel profiles, corners, anchorages, attachment system, trim, flashings, closures, and accessories; and special details.
- C. Samples: For each type of metal panel indicated.

1.4 INFORMATIONAL SUBMITTALS

- A. Product test reports.
- B. Warranties: Samples of special warranties.

1.5 CLOSEOUT SUBMITTALS

- A. Maintenance data.

1.6 WARRANTY

- A. Special Warranty: Manufacturer's standard form in which manufacturer agrees to repair or replace components of metal panel systems that fail in materials or workmanship within specified warranty period.
1. Warranty Period: Two years from date of Substantial Completion.

- B. Special Warranty on Panel Finishes: Manufacturer's standard form in which manufacturer agrees to repair finish or replace metal panels that show evidence of deterioration of factory-applied finishes within specified warranty period.
 - 1. Finish Warranty Period: 20 years from date of Substantial Completion.

PART 2 - PRODUCTS

2.1 PERFORMANCE REQUIREMENTS

- A. Structural Performance: Provide metal panel systems capable of withstanding the effects of the following loads, based on testing according to ASTM E1592:
 - 1. Wind Loads: As indicated on Drawings.
 - 2. Other Design Loads: As indicated on Drawings.
 - 3. Deflection Limits: For wind loads, no greater than 1/240 of the span.
- B. Air Infiltration: Air leakage of not more than 0.06 cfm/sq. ft. when tested according to ASTM E283 at the following test-pressure difference:
 - 1. Test-Pressure Difference: 1.57 lbf/sq. ft..
- C. Water Penetration under Static Pressure: No water penetration when tested according to ASTM E331 at the following test-pressure difference:
 - 1. Test-Pressure Difference: 2.86 lbf/sq. ft..
- D. Thermal Movements: Allow for thermal movements from ambient and surface temperature changes by preventing buckling, opening of joints, overstressing of components, failure of joint sealants, failure of connections, and other detrimental effects. Base calculations on surface temperatures of materials due to both solar heat gain and nighttime-sky heat loss.
 - 1. Temperature Change (Range): 120 deg F, ambient; 180 deg F, material surfaces.

2.2 METAL SOFFIT PANELS

- A. Provide metal soffit panels designed to be installed by lapping and interconnecting side edges of adjacent panels and mechanically attaching through panel to supports using concealed fasteners in side laps. Include accessories required for weathertight installation.
- B. Flush-Profile Metal Soffit Panels: Perforated panels formed with vertical panel edges and a flat pan between panel edges; with flush joint between panels.
 - 1. Basis of Design Product:
 - a. Dimensional Metals, Inc.,
 - 1) FP10

2. Manufacturers: Subject to compliance with requirements, provide products by one of the following:
 - a. Dimensional Metals, Inc.
 - b. Englert, Inc.
 - c. MBCI, Cornerstone Building Brands, Inc.
 - d. McElroy Metal, Inc.
 - e. Metal Sales Manufacturing Corporation.
 - f. PAC-CLAD; Petersen Aluminum Corporation; a Carlisle company.
3. Material: Same material, finish, and color as metal roof panels.
4. Metallic-Coated Steel Sheet: Zinc-coated (galvanized) steel sheet complying with ASTM A653/A653M, G90 coating designation, or aluminum-zinc alloy-coated steel sheet complying with ASTM A792/A792M, Class AZ50 coating designation; structural quality. Prepainted by the coil-coating process to comply with ASTM A755/A755M.
 - a. Nominal Thickness: 24 gauge.
 - b. Exterior Finish: Two-coat fluoropolymer.
 - c. Color: As selected by Architect from manufacturer's full range.
5. Panel Coverage: 12 inches.
6. Panel Height: 1 inch.

2.3 MISCELLANEOUS MATERIALS

- A. Panel Accessories: Provide components required for a complete, weathertight panel system including trim, clips, flashings, sealants, gaskets, fillers, closure strips, and similar items. Match material and finish of metal panels unless otherwise indicated.
 1. Closure Strips: Closed-cell, expanded, cellular, rubber or crosslinked, polyolefin-foam or closed-cell laminated polyethylene; minimum 1-inch-thick, flexible closure strips; cut or premolded to match metal panel profile. Provide closure strips where indicated or necessary to ensure weathertight construction.
- B. Flashing and Trim: Provide flashing and trim formed from same material as metal panels as required to seal against weather and to provide finished appearance. Finish flashing and trim with same finish system as adjacent metal panels.
- C. Panel Fasteners: Self-tapping screws designed to withstand design loads. Provide exposed fasteners with heads matching color of metal panels by means of plastic caps or factory-applied coating. Provide EPDM or PVC sealing washers for exposed fasteners.
- D. Panel Sealants: Provide sealant types recommended by manufacturer that are compatible with panel materials, are nonstaining, and do not damage panel finish.
 1. Sealant Tape: Pressure-sensitive, 100 percent solids, gray polyisobutylene compound sealant tape with release-paper backing; 1/8 inch thick.
 2. Joint Sealant: ASTM C920; as recommended in writing by metal panel manufacturer.
 3. Butyl-Rubber-Based, Solvent-Release Sealant: ASTM C1311.

2.4 FABRICATION

- A. Fabricate and finish metal panels and accessories at the factory, by manufacturer's standard procedures and processes, as necessary to fulfill indicated performance requirements demonstrated by laboratory testing. Comply with indicated profiles and with dimensional and structural requirements.
- B. Provide panel profile, including major ribs and intermediate stiffening ribs, if any, for full length of panel.
- C. Fabricate metal panel joints with factory-installed captive gaskets or separator strips that provide a weathertight seal and prevent metal-to-metal contact, and that minimize noise from movements.
- D. Sheet Metal Flashing and Trim: Fabricate flashing and trim to comply with manufacturer's recommendations and recommendations in SMACNA's "Architectural Sheet Metal Manual" that apply to design, dimensions, metal, and other characteristics of item indicated.

2.5 FINISHES

- A. Panels and Accessories:
 - 1. Two-Coat Fluoropolymer: AAMA 621. Fluoropolymer finish containing not less than 70 percent polyvinylidene fluoride (PVDF) resin by weight in color coat. Prepare, pretreat, and apply coating to exposed metal surfaces to comply with coating and resin manufacturers' written instructions.
 - 2. Concealed Finish: White or light-colored acrylic or polyester backer finish.

PART 3 - EXECUTION

3.1 PREPARATION

- A. Miscellaneous Supports: Install subframing, furring, and other miscellaneous panel support members and anchorages according to ASTM C754 and metal panel manufacturer's written recommendations.

3.2 INSTALLATION

- A. Metal Soffit Panels: Fasten metal panels to supports with fasteners at each lapped joint at location and spacing recommended by manufacturer.
 - 1. Apply panels and associated items true to line for neat and weathertight enclosure.
 - 2. Provide metal-backed washers under heads of exposed fasteners bearing on weather side of metal panels.

3. Locate and space exposed fasteners in uniform vertical and horizontal alignment. Use proper tools to obtain controlled uniform compression for positive seal without rupture of washer.
4. Install screw fasteners with power tools having controlled torque adjusted to compress washer tightly without damage to washer, screw threads, or panels. Install screws in predrilled holes.

B. Watertight Installation:

1. Apply a continuous ribbon of sealant or tape to seal lapped joints of metal panels, using sealant or tape as recommend by manufacturer on side laps of nesting-type panels and elsewhere as needed to make panels watertight.
2. Provide sealant or tape between panels and protruding equipment, vents, and accessories.
3. At panel splices, nest panels with minimum 6-inch end lap, sealed with sealant and fastened together by interlocking clamping plates.

C. Accessory Installation: Install accessories with positive anchorage to building and weathertight mounting, and provide for thermal expansion. Coordinate installation with flashings and other components.

D. Flashing and Trim: Comply with performance requirements, manufacturer's written installation instructions, and SMACNA's "Architectural Sheet Metal Manual." Provide concealed fasteners where possible, and set units true to line and level as indicated. Install work with laps, joints, and seams that are permanently watertight.

3.3 CLEANING

- A. Remove temporary protective coverings and strippable films, if any, as metal panels are installed unless otherwise indicated in manufacturer's written installation instructions. On completion of metal panel installation, clean finished surfaces as recommended by metal panel manufacturer. Maintain in a clean condition during construction.

END OF SECTION 074293


This page is intentionally blank.

GENERAL NOTES:


1. INTERIOR DIMENSIONS SHOWN ON THESE PLANS ARE FROM FACE OF FINISHED WALL TO FACE OF FINISHED WALL UNLESS NOTED OTHERWISE.
2. EXTERIOR DIMENSIONS ARE FROM FACE OF SHEATHING TO FACE OF SHEATHING, AND FROM FACE OF MASONRY TO FACE OF MASONRY.
3. INTERIOR PARTITIONS ARE TYPE A.1 UNLESS NOTED OTHERWISE. SEE A4.01 FOR PARTITION TYPES.
4. INSTALL WOOD BLOCKING IN NEW WALLS TO RECEIVE WALL-MOUNTED ITEMS. WOOD BLOCKING SHALL BE FIRE RETARDANT TREATED.

LIFE SAFETY LEGEND

- 2 HOUR FR
- COMMON PATH OF TRAVEL
- TRAVEL DISTANCE
- FIRE EXTINGUISHER - CABINET
- FIRE EXTINGUISHER - WALL MOUNT
- EXIT SIGN LOCATION
- FIRE RATED DOOR TAG

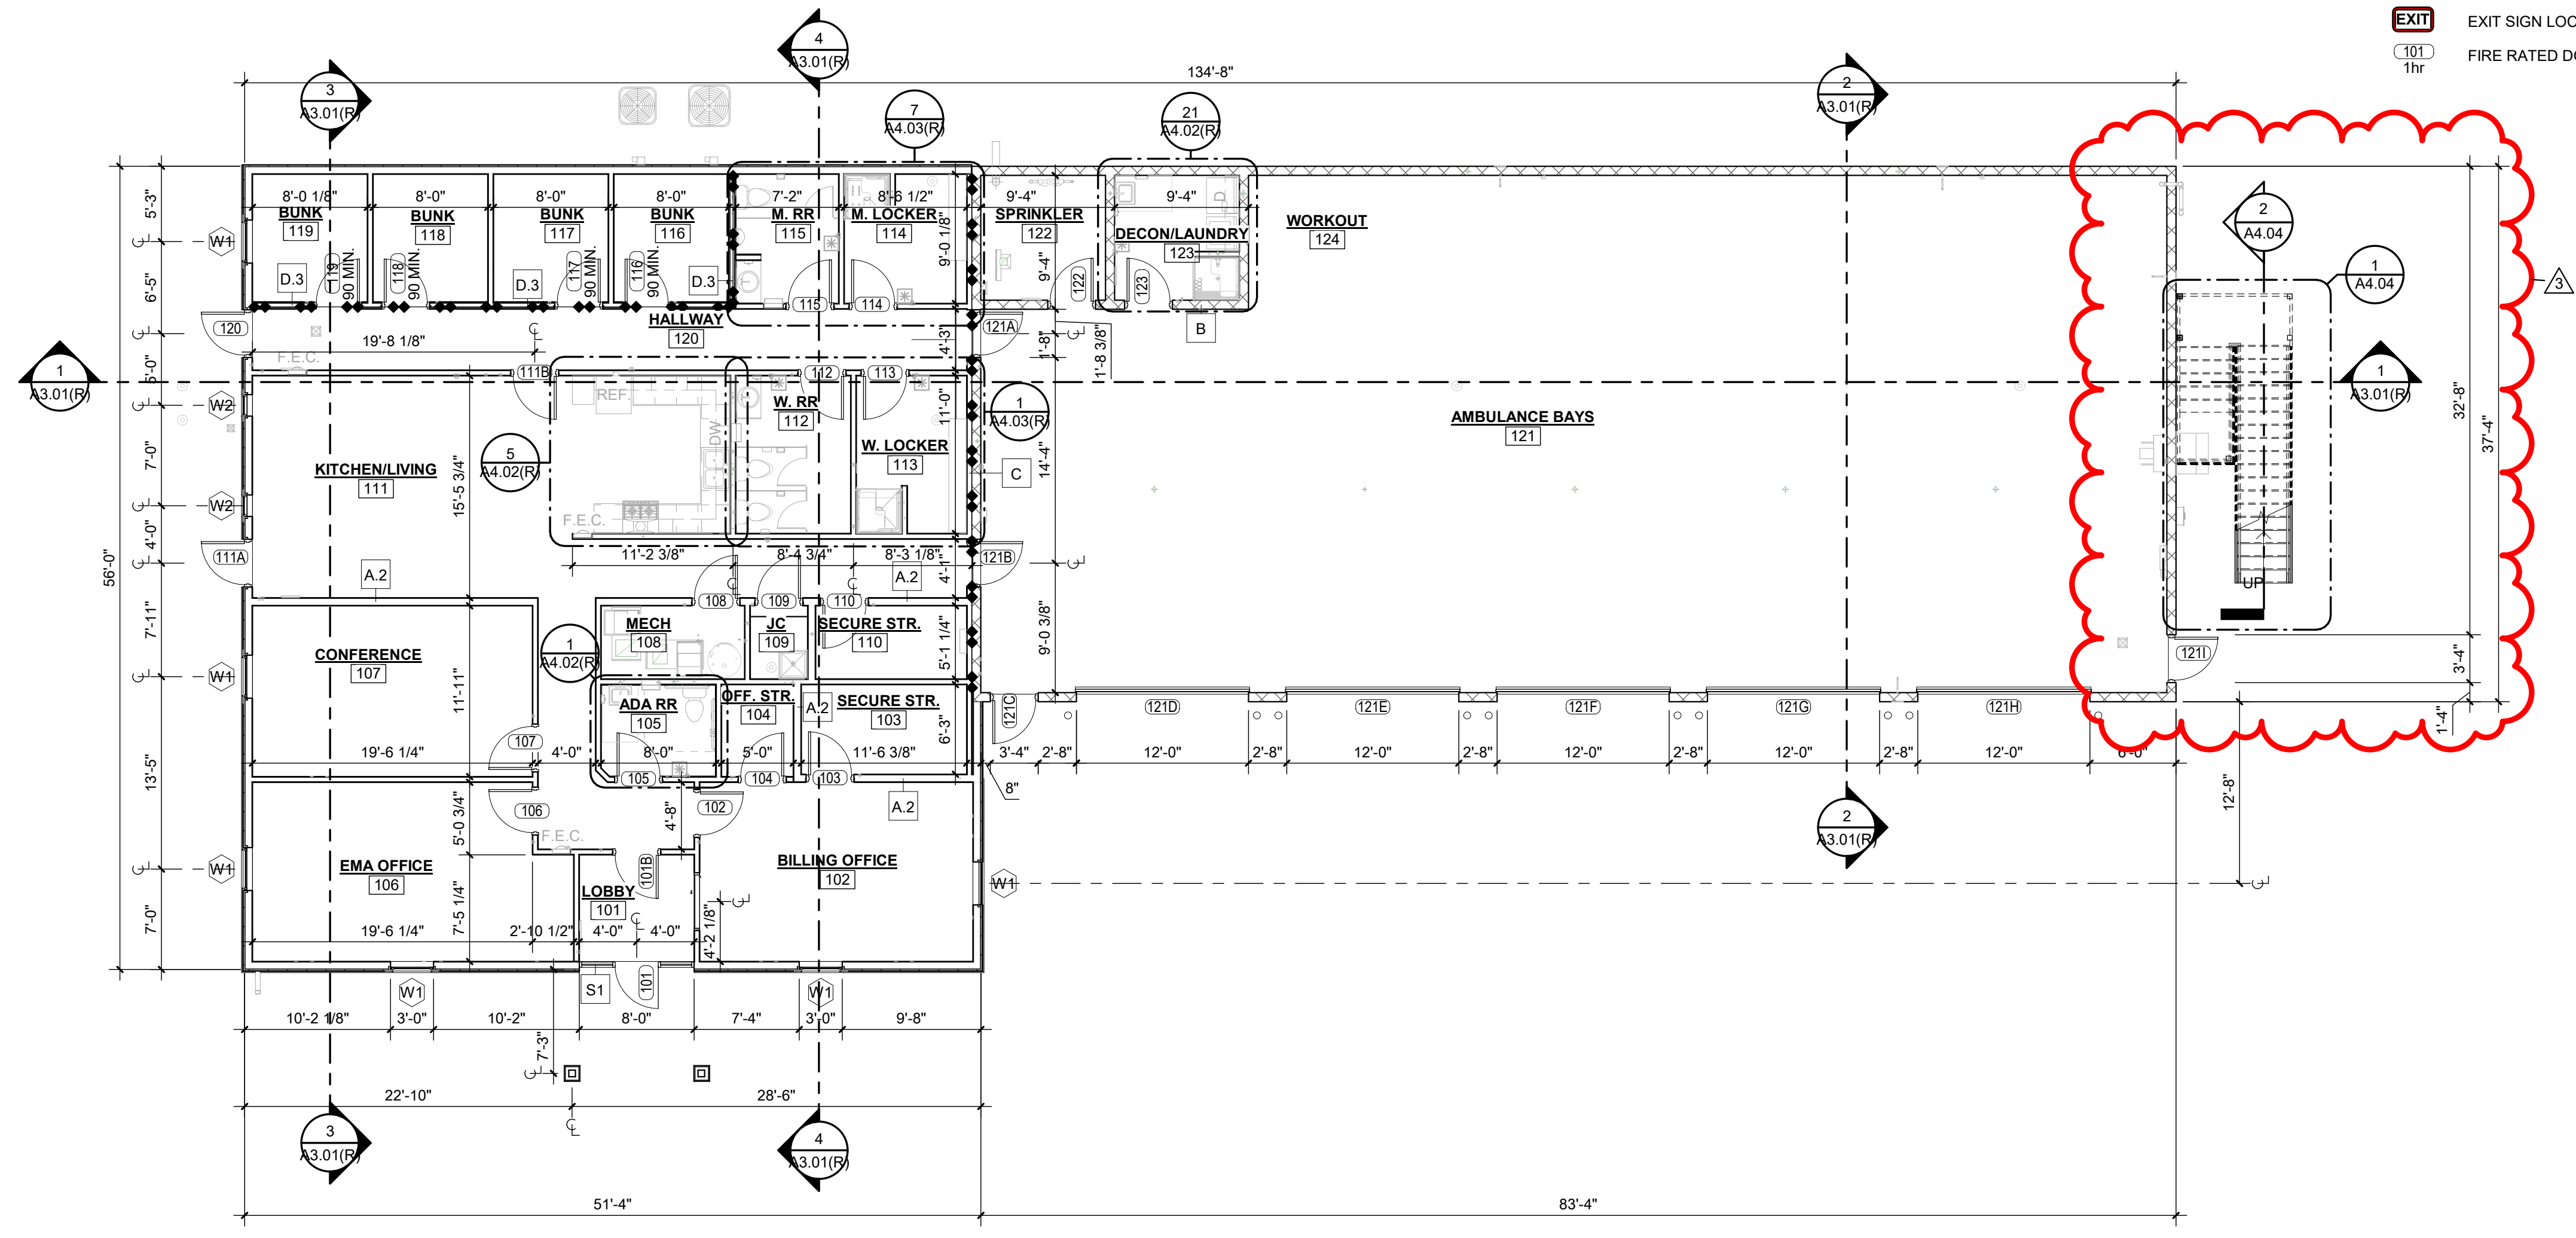

1 FIRST FLOOR PLAN
1/8" = 1'-0"

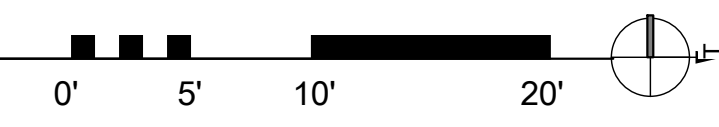

2 HOUR FR

| NO. | BY | DATE | DESCRIPTION |
|-----|----|------|-------------|
| 3 | | | |

BROOKE COUNTY EMS
BROOKE COUNTY COMMISSION
3031 PLEASANT AVE, WELLSBURG WV 26070
FEBRUARY 24, 2023
CONSTRUCTION DOCUMENTS

DRAWN: MS/OS DATE: 02/24/2022
CHECKED: PMF DATE: 02/24/2022

PROJECT No. T60-11009.00

FLOOR PLAN


SHEET No.

A1.01(R)


REFLECTED CEILING PLAN LEGEND

NOTE: CONTRACTOR TO COORDINATE RCP BETWEEN ARCHITECTURAL AND MEP DRAWINGS


- 2'x2' LAY-IN CEILING TILE
- 2'x4' LAY-IN CEILING TILE
- 2'x2' LAY-IN CEILING TILE - TYPE 2
- 2'x4' LIGHT FIXTURE
- 2'x2' LIGHT FIXTURE
- 2'x4' EMERGENCY LIGHT FIXTURE
- 2'x2' EMERGENCY LIGHT FIXTURE
- EXIT SIGN
- SMOKE DETECTOR
- GYPSUM BOARD CEILING
- DIFFUSERS
- RETURN GRILL
- EXHAUST GRILL
- BULK HEAD
- WALLS BELOW
- RECESSED DOWN LIGHT
- O.T.A. OPEN TO ABOVE
- SPEAKER

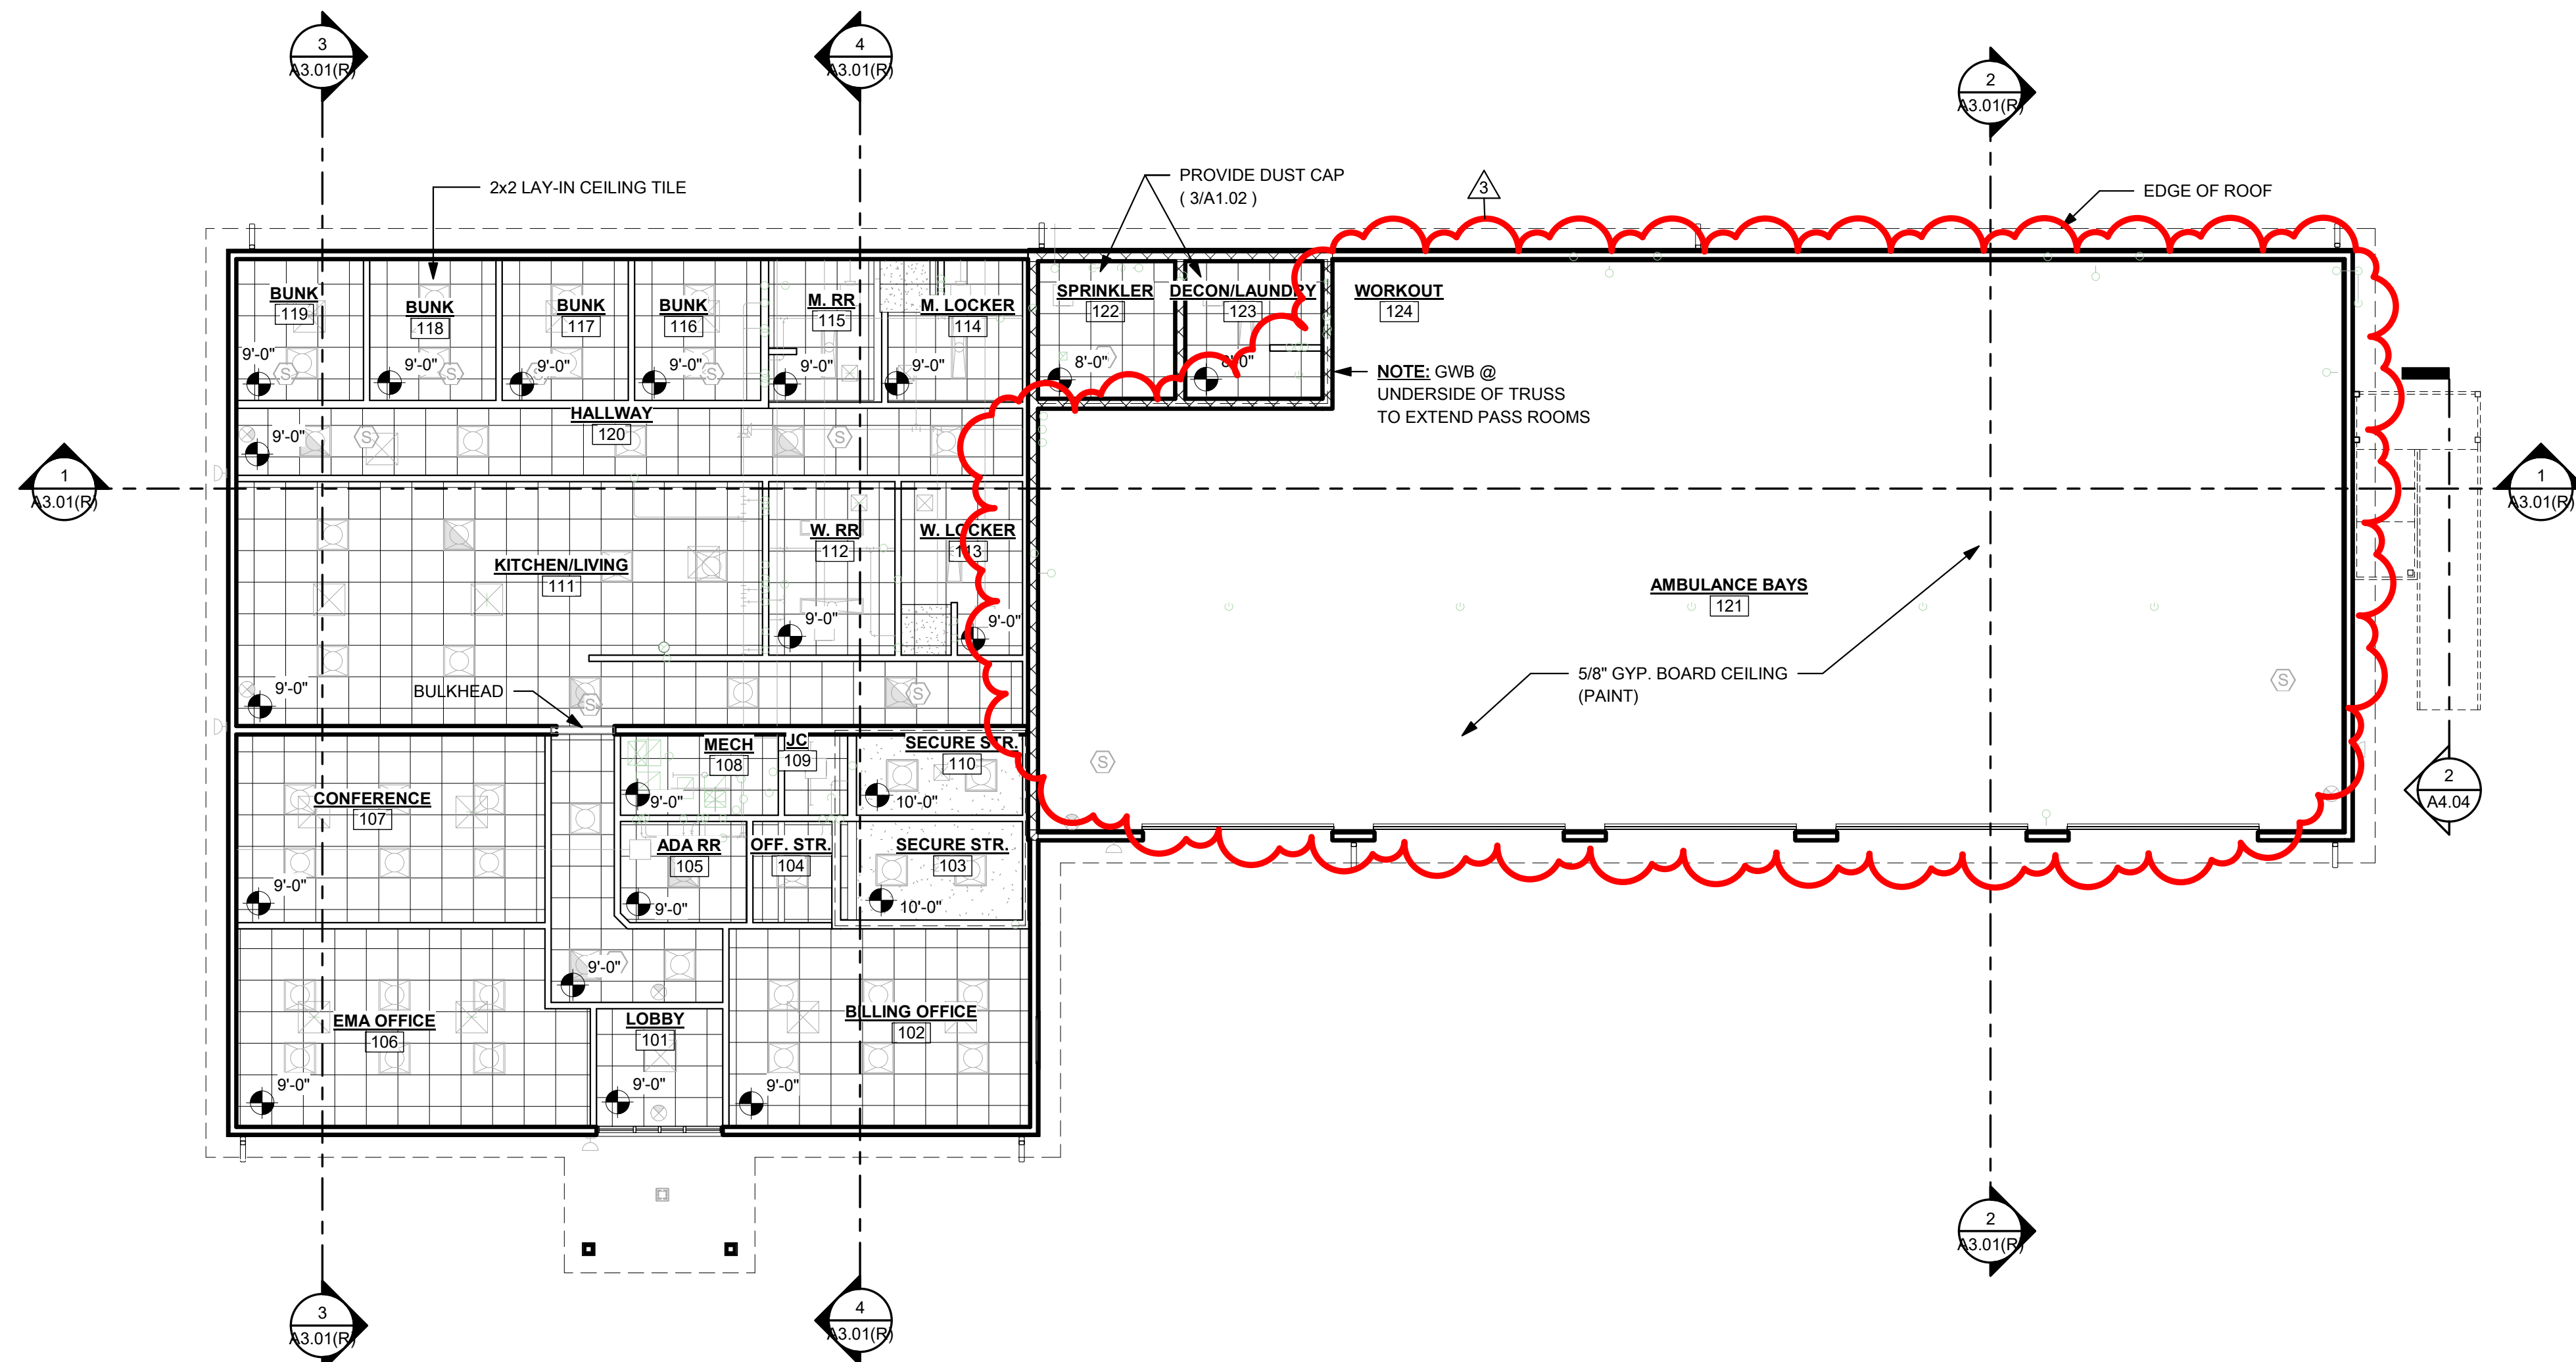

1 FIRST FLOOR RCP
 1/8" = 1'-0"

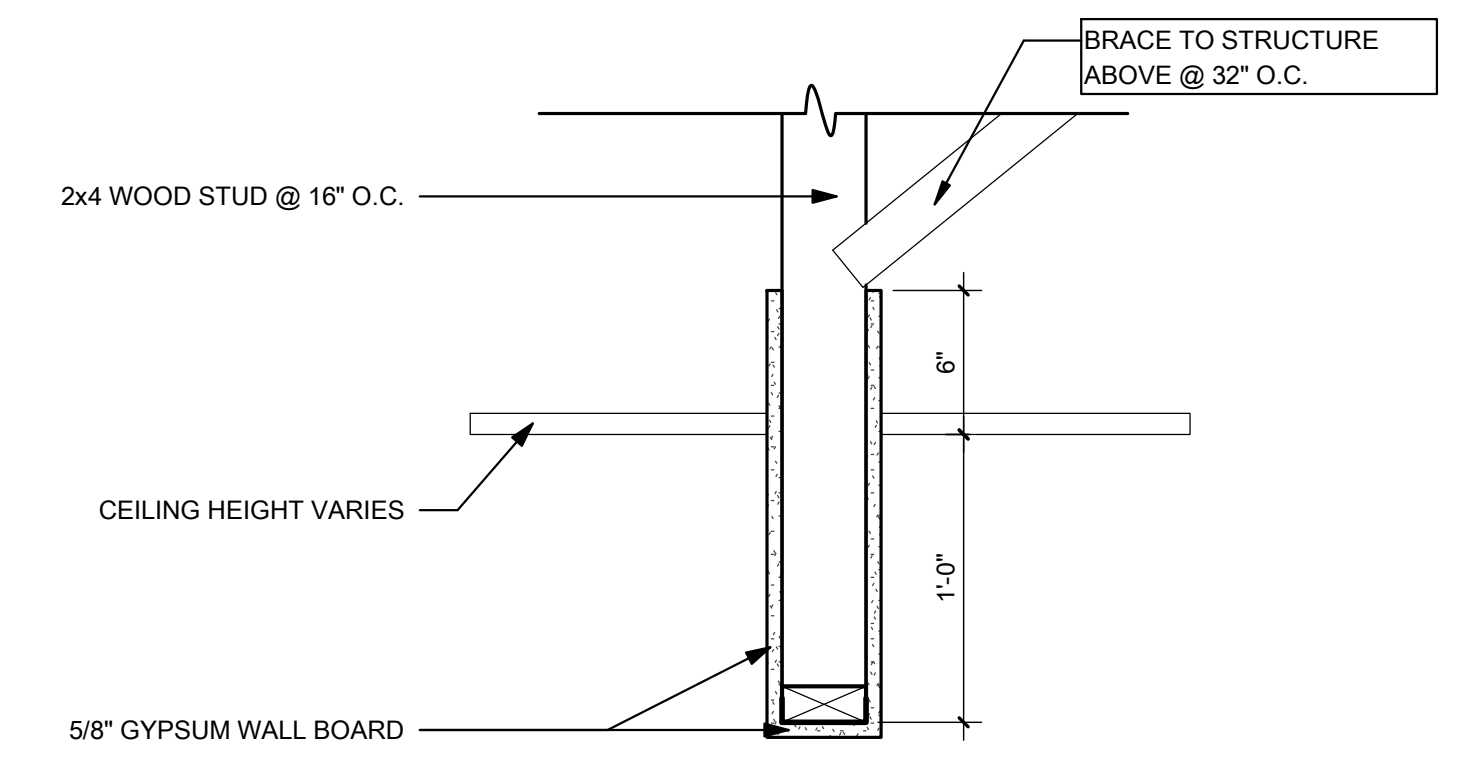

2 CEILING DETAIL - TYPICAL BULKHEAD DETAIL
 1 1/2" = 1'-0"

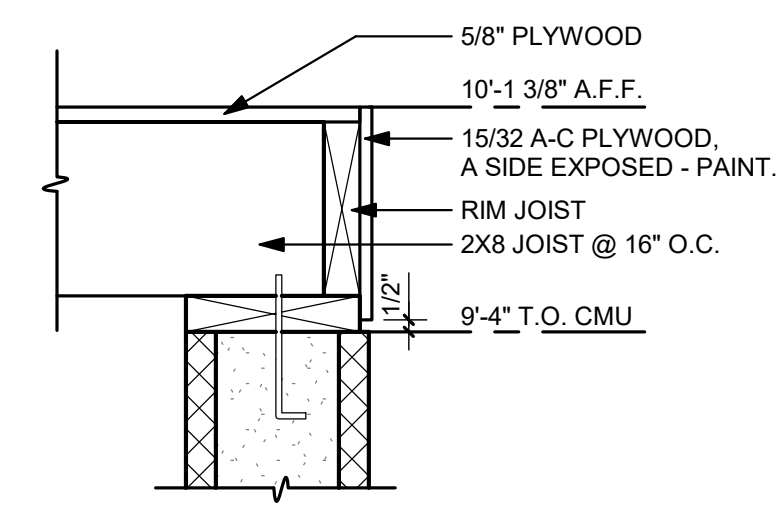

3 DETAIL - DUST CAP
 1 1/2" = 1'-0"

| NO. | BY | DATE | DESCRIPTION |
|-----|----|------|-------------|
| 3 | | | |

BROOKE COUNTY EMS
 BROOKE COUNTY COMMISSION
 3031 PLEASANT AVE, WELLSBURG WV 26070
 FEBRUARY 24, 2023
 CONSTRUCTION DOCUMENTS


DRAWN: DS DATE: 02/24/2023
 CHECKED: PMF DATE: 02/24/2023

PROJECT No. T60-11009.00

REFLECTED CEILING PLAN

SHEET No.

A1.02(R)

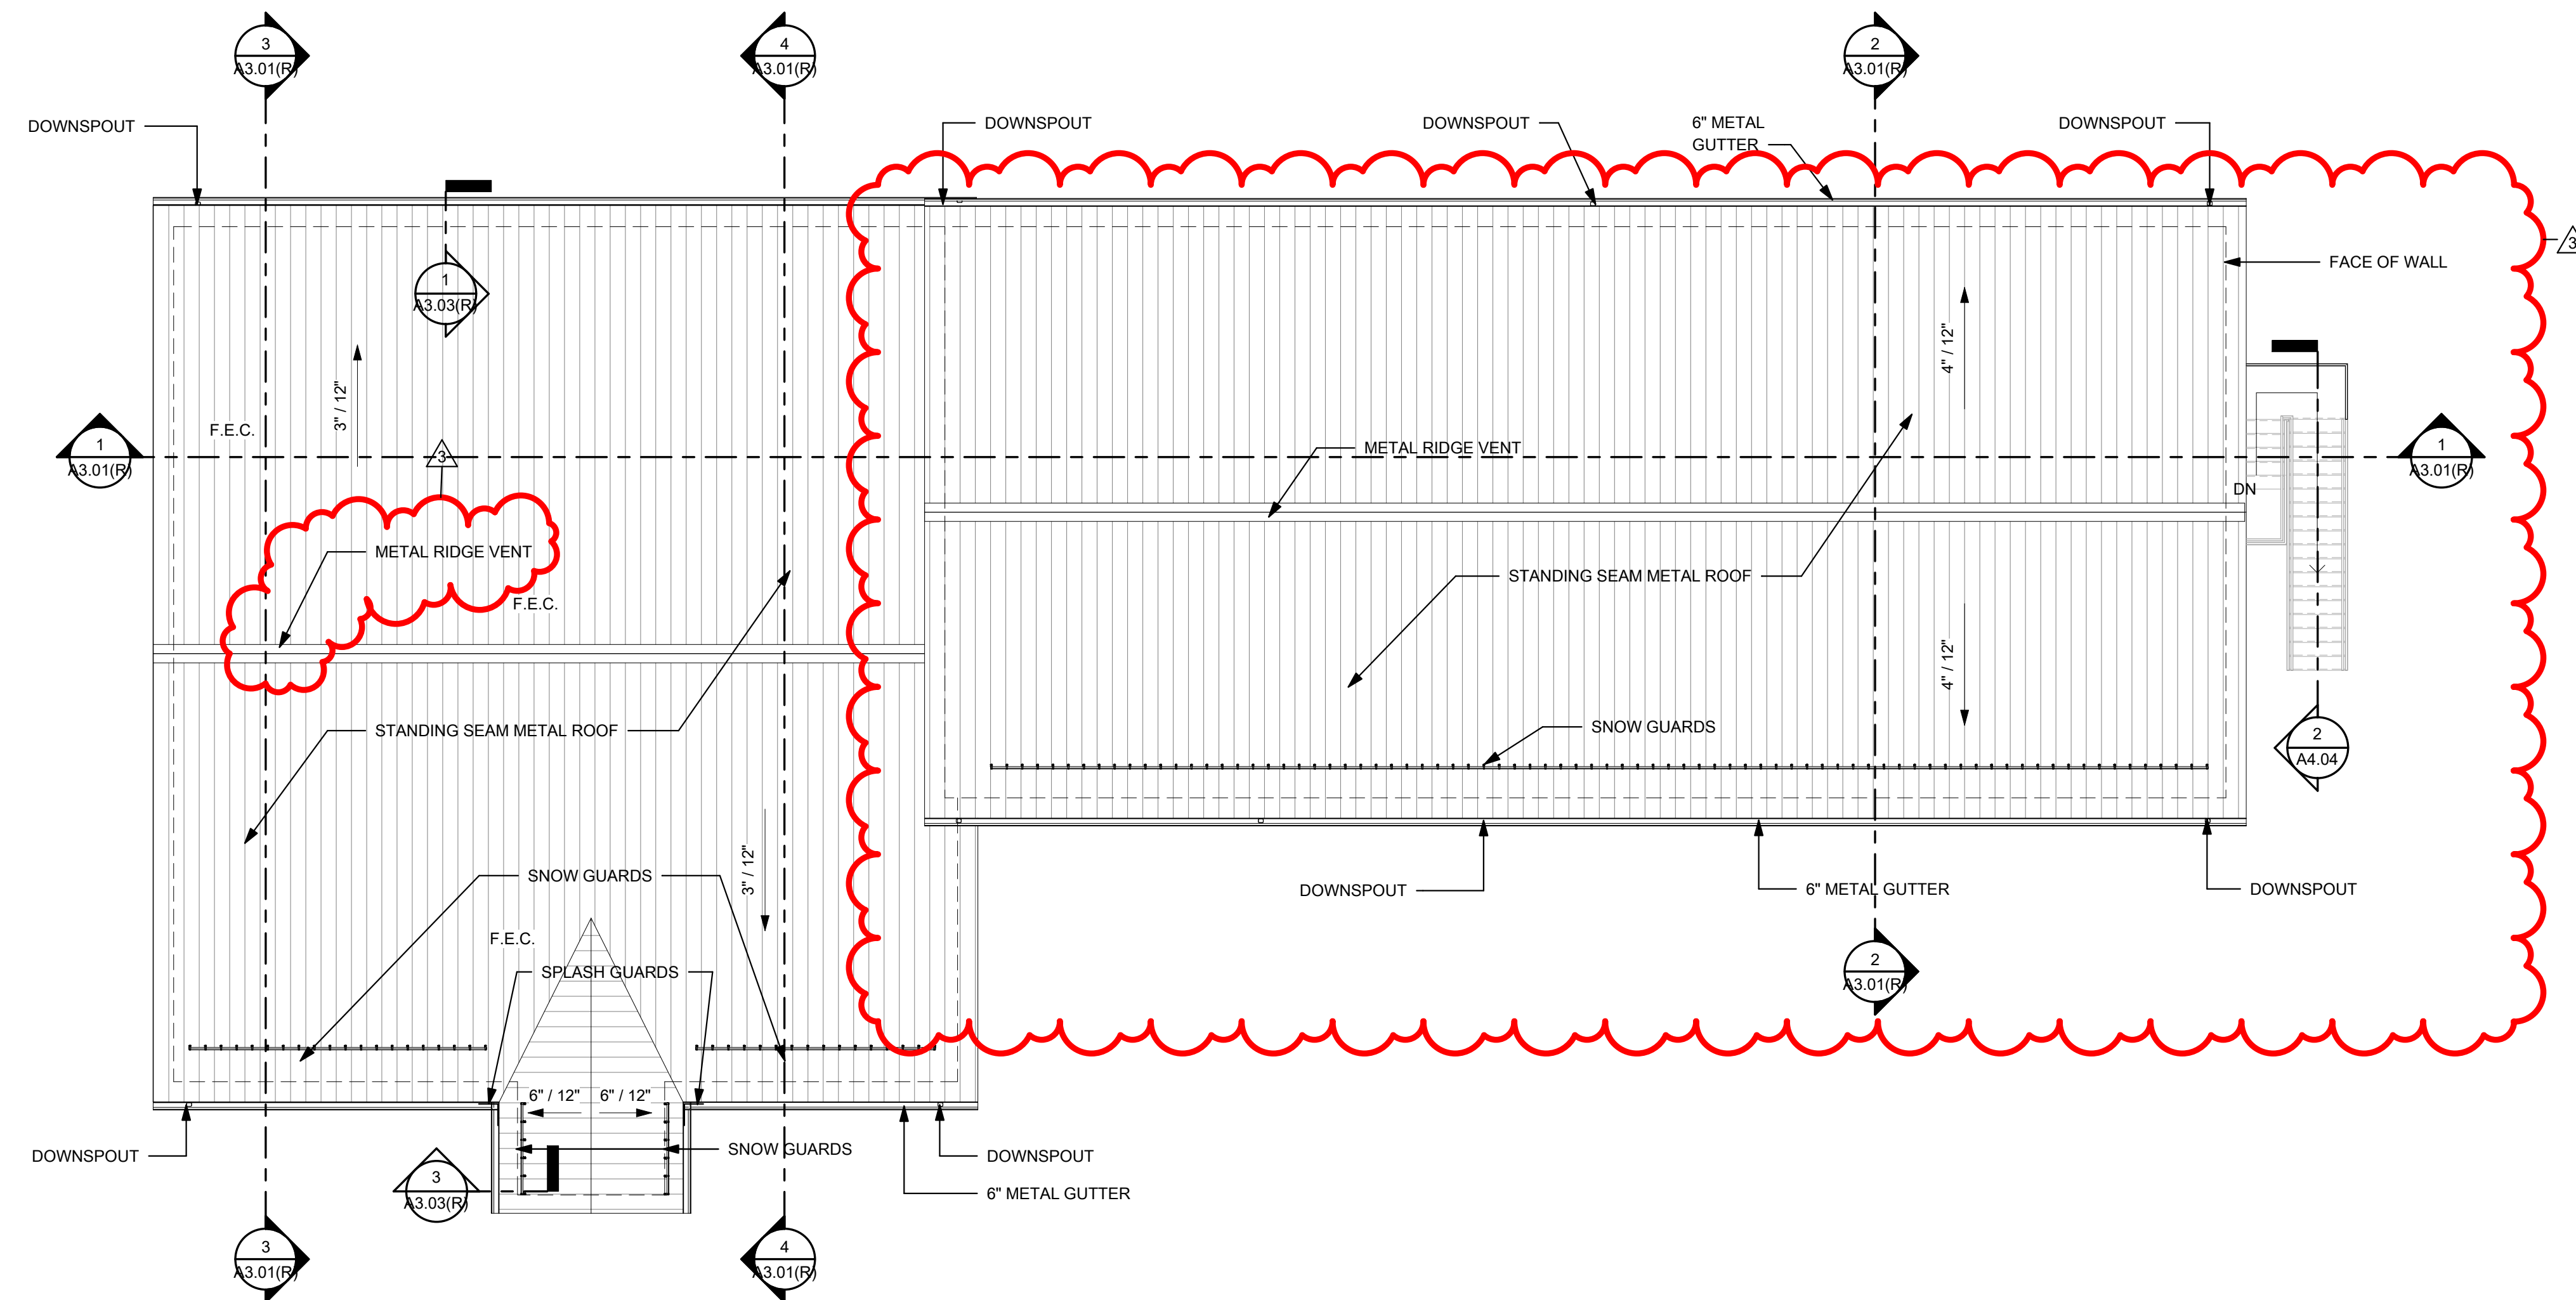

1 ROOF PLAN
1/8" = 1'-0"



USER: DS

PLOT DATE/TIME: 4/4/2023 10:03:33 AM

LAYOUT TAB: ROOF PLAN
CAD FILE: R:\0507150-1100-00-Brooke EMS-Brooke County Commission-Drawing\Rev\02020302-Brooke EMS_CD_2022.rvt

| NO. | BY | DATE | DESCRIPTION |
|-----|----|------|-------------|
| 3 | | | |

BROOKE COUNTY EMS
BROOKE COUNTY COMMISSION
3031 PLEASANT AVE, WELLSBURG WV 26070
FEBRUARY 24, 2023
CONSTRUCTION DOCUMENTS





DRAWN: DS DATE: 02/24/2023
CHECKED: PMF DATE: 02/24/2023

PROJECT No. T60-11009.00

ROOF PLAN

SHEET No.

A1.03(R)

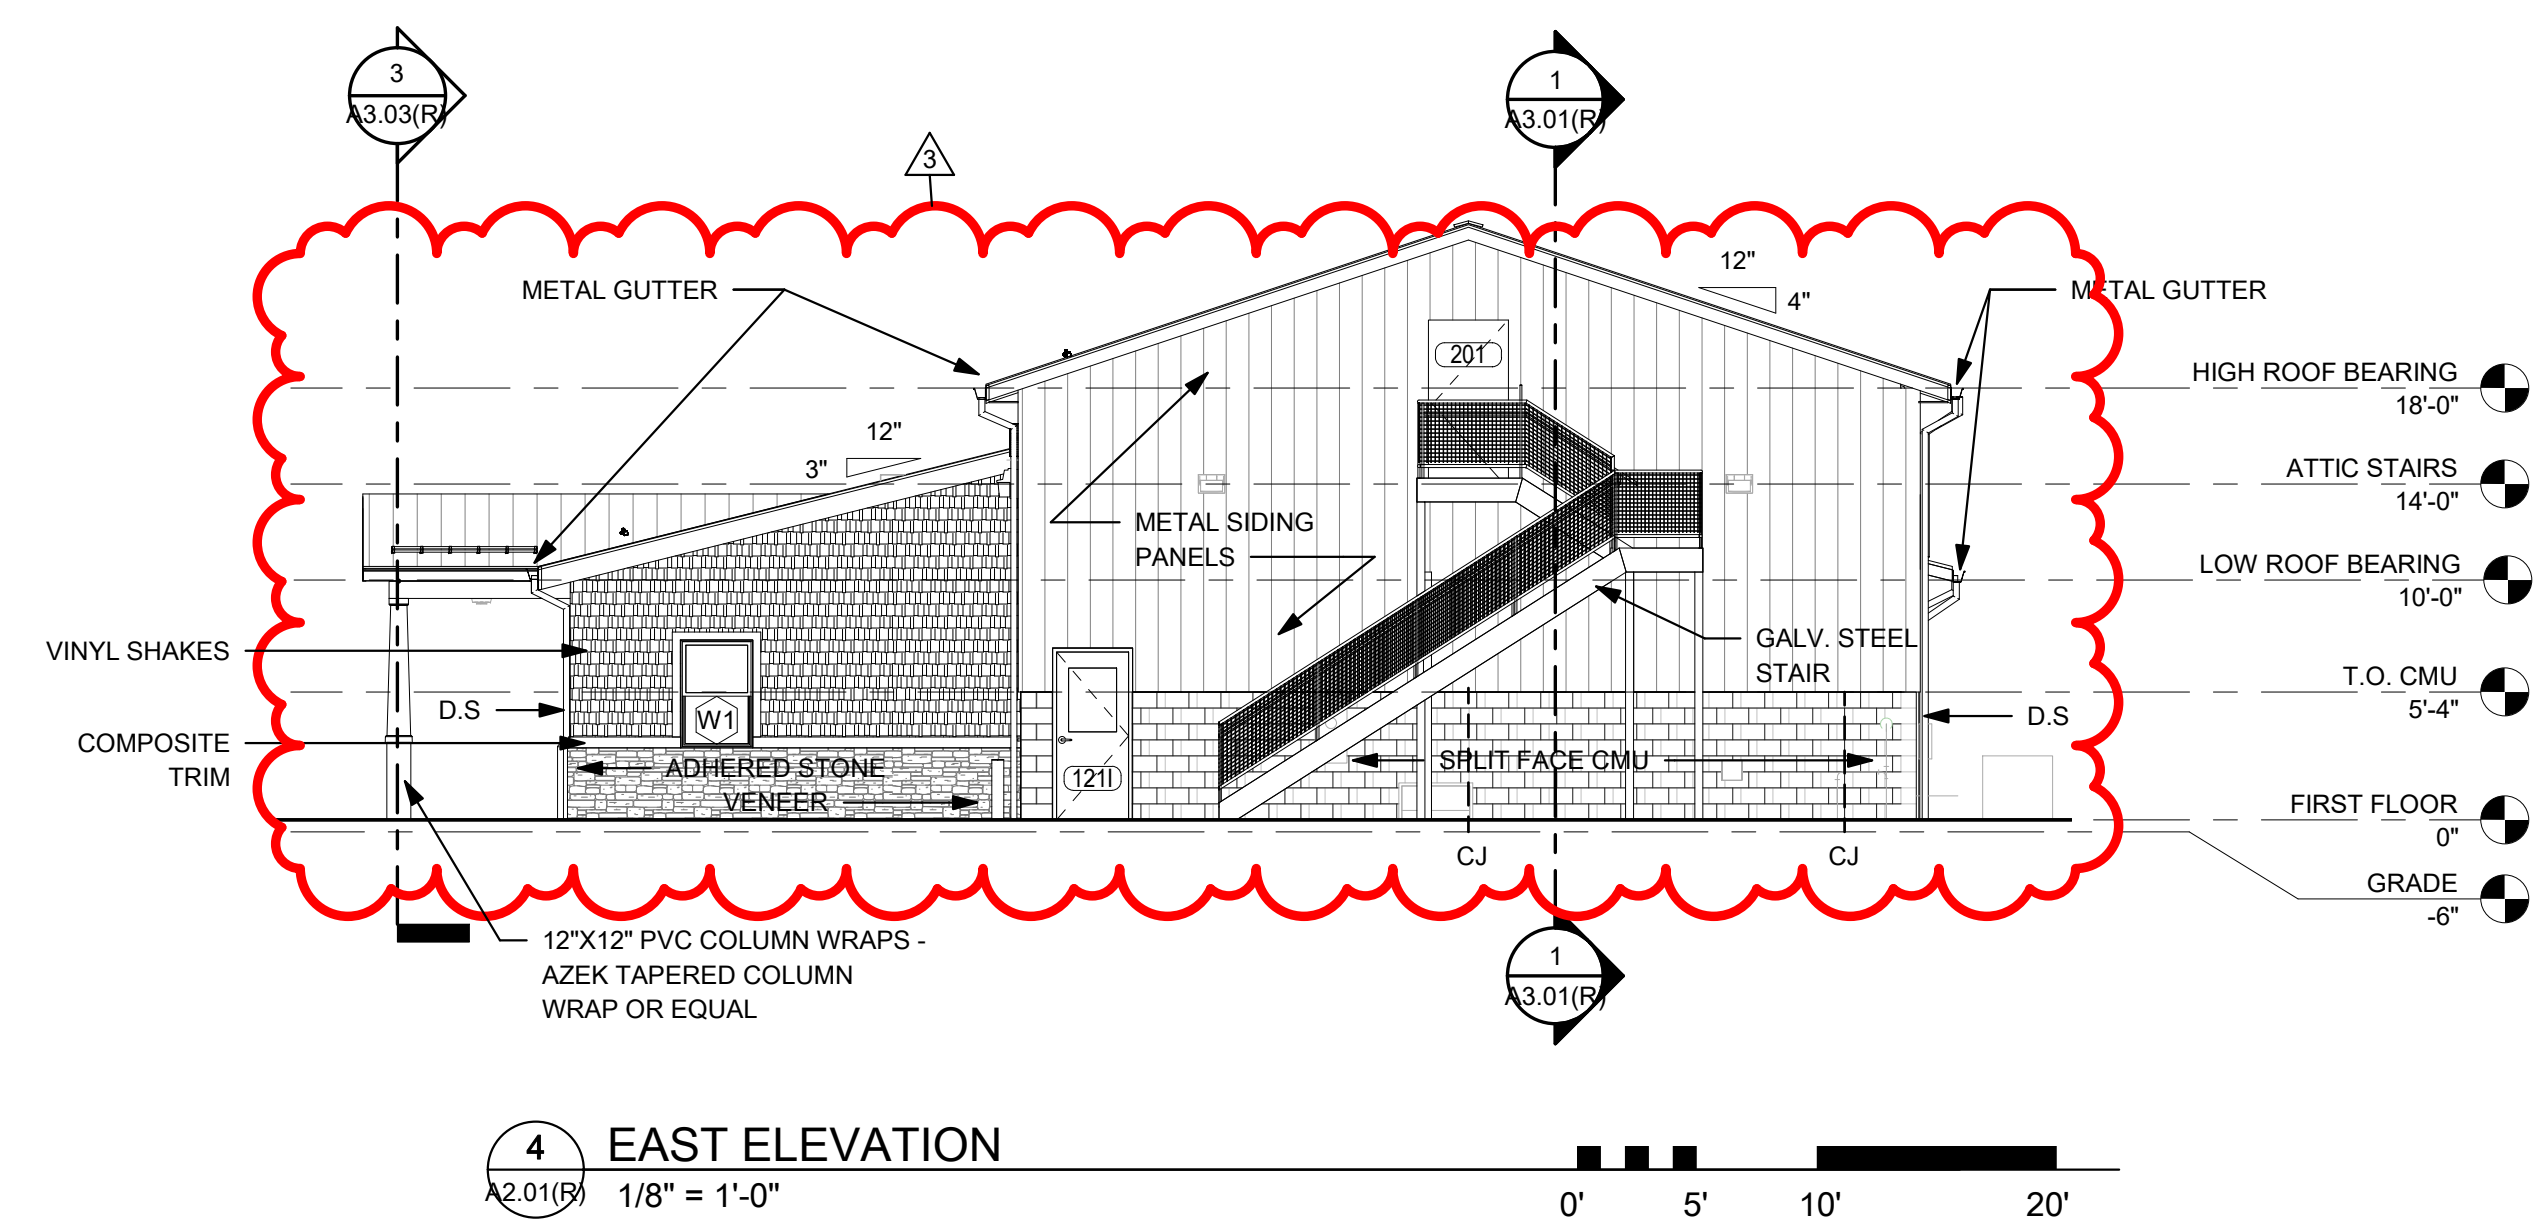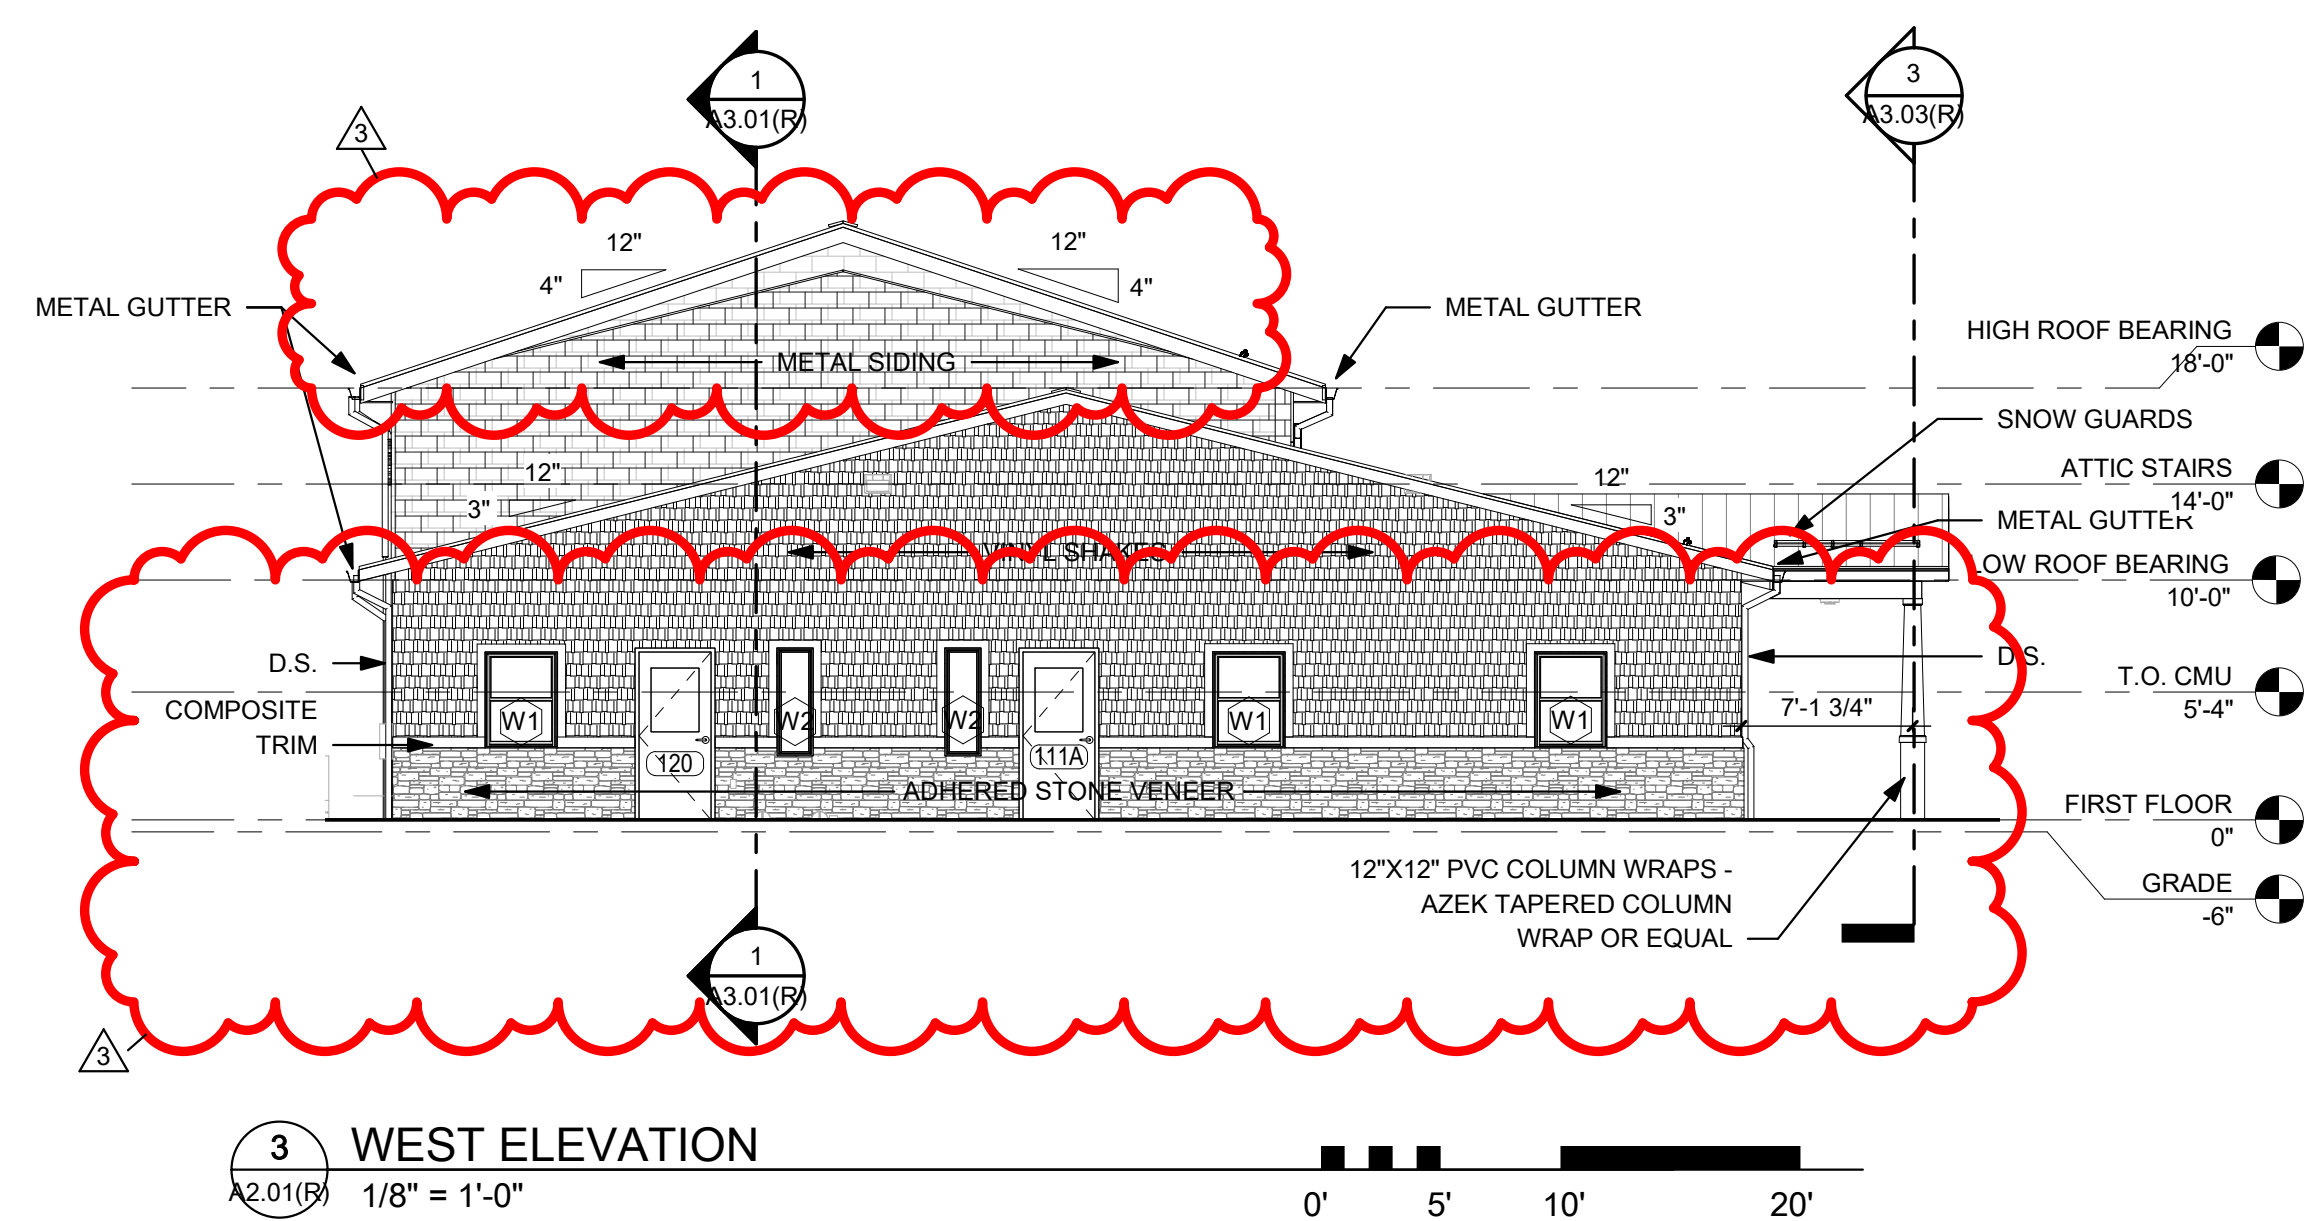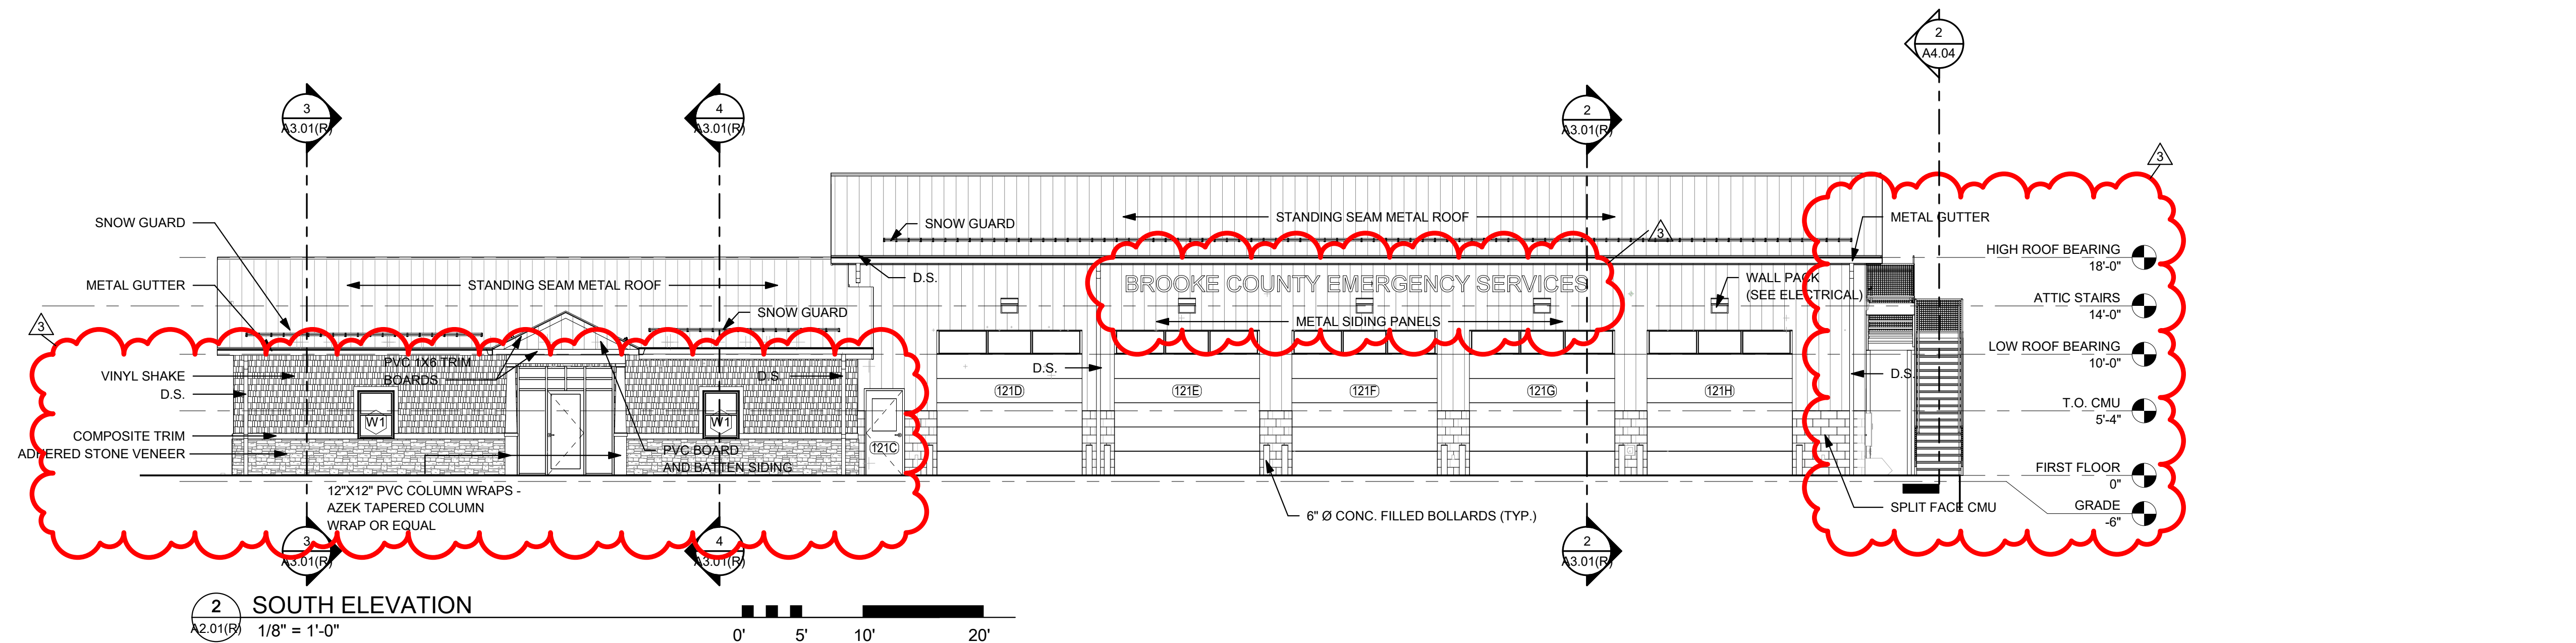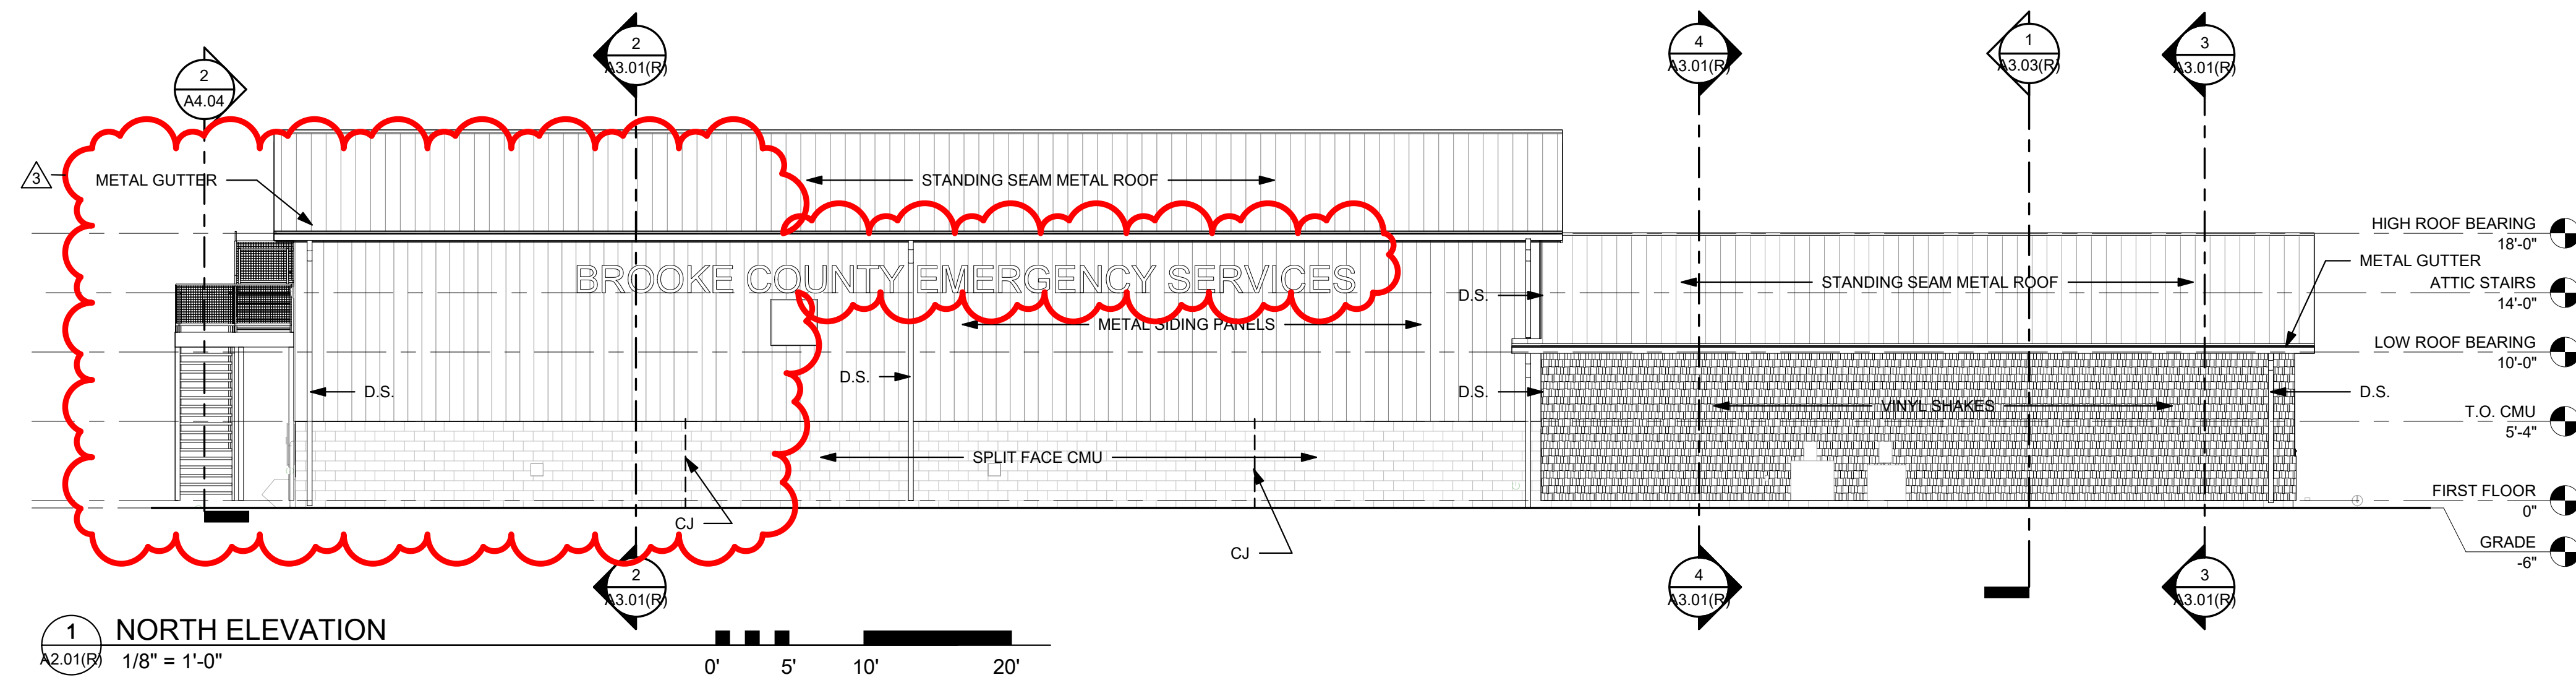

| NO. | BY | DATE | DESCRIPTION |
|-----|----|------|-------------|
| 3 | | | |

BROOKE COUNTY EMS
BROOKE COUNTY COMMISSION
3031 PLEASANT AVE, WELLSBURG WV 26070
FEBRUARY 24, 2023
CONSTRUCTION DOCUMENTS

DRAWN: DS DATE: 02/24/2023
CHECKED: PMF DATE: 02/24/2023





PROJECT No. T60-11009.00

BUILDING ELEVATIONS

SHEET No.

A2.01(R)

THE INFORMATION CONTAINED HEREIN IS THE SOLE PROPERTY OF THE THRASHER GROUP, INC. REPRODUCTION OF THESE DOCUMENTS IN WHOLE, OR IN PART FOR ANY REASON WITHOUT PRIOR WRITTEN PERMISSION IS STRICTLY PROHIBITED. COPYRIGHT © 2021 THE THRASHER GROUP, INC.

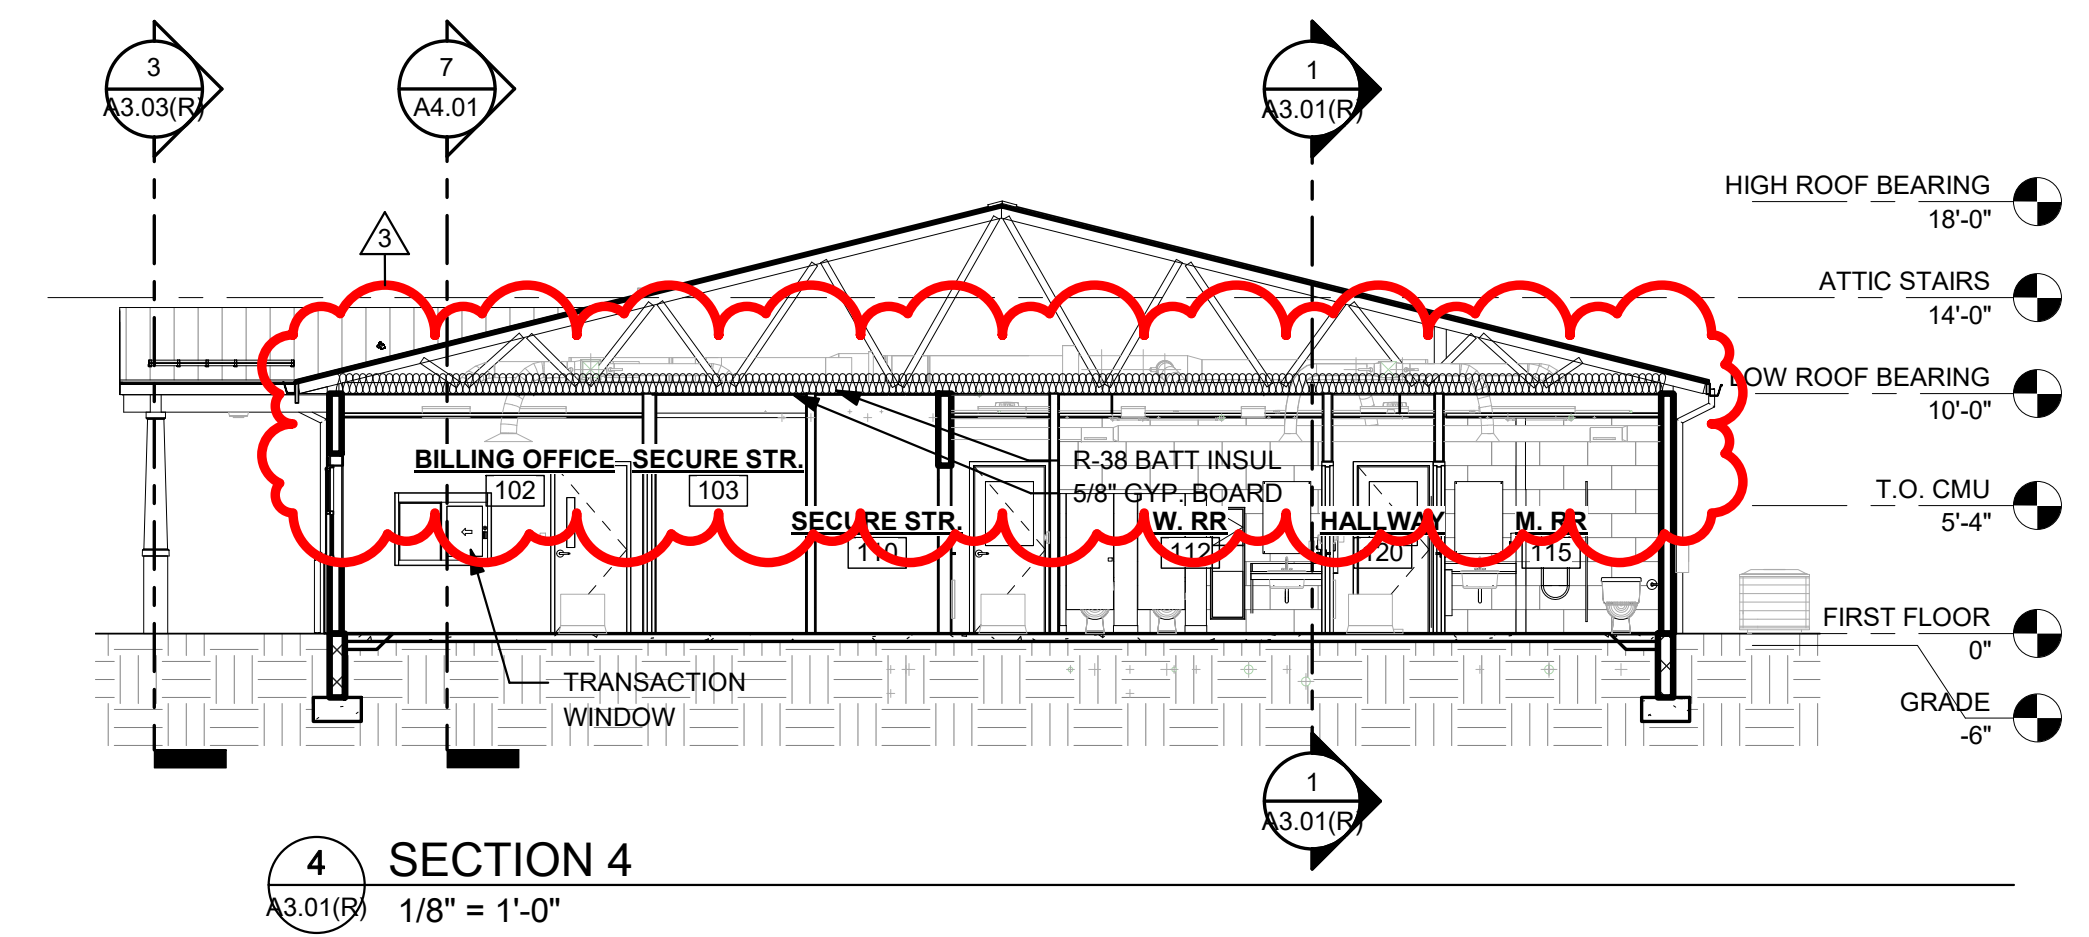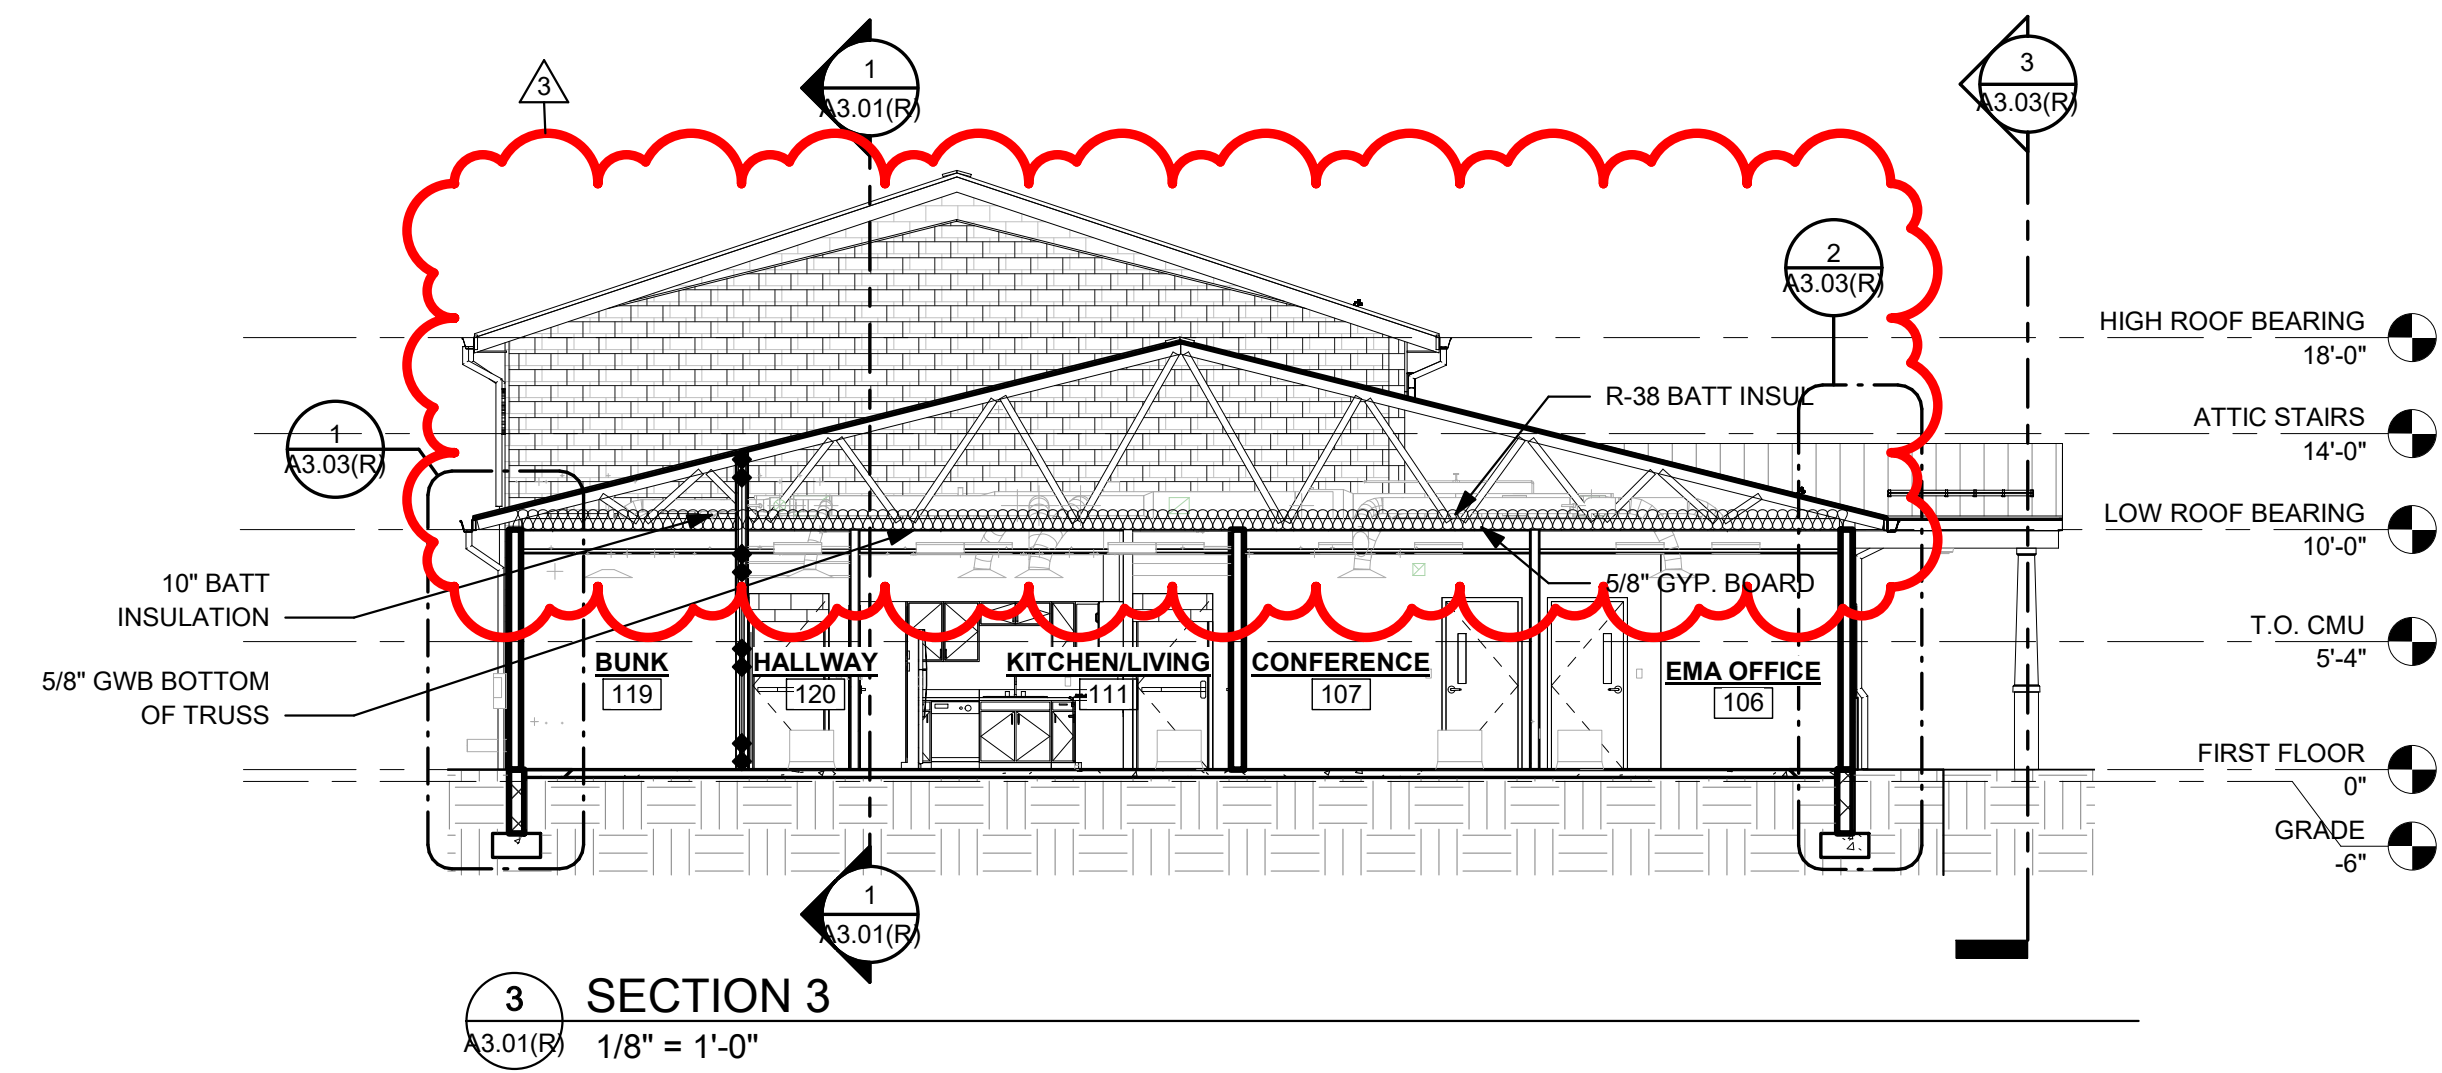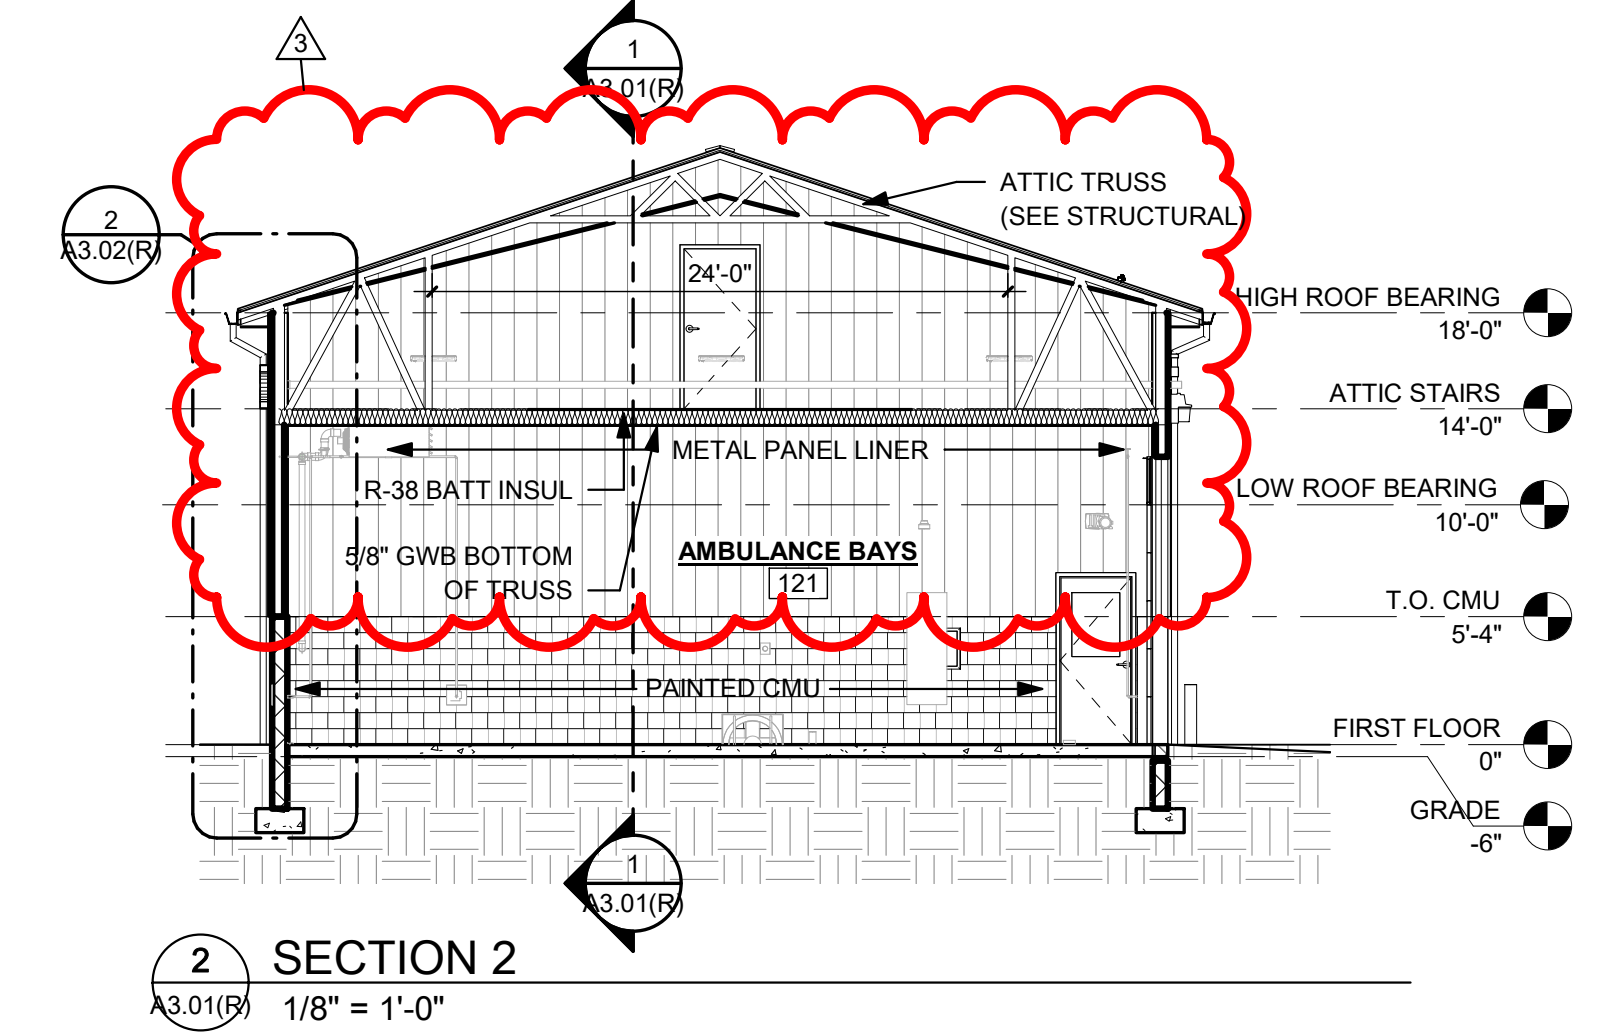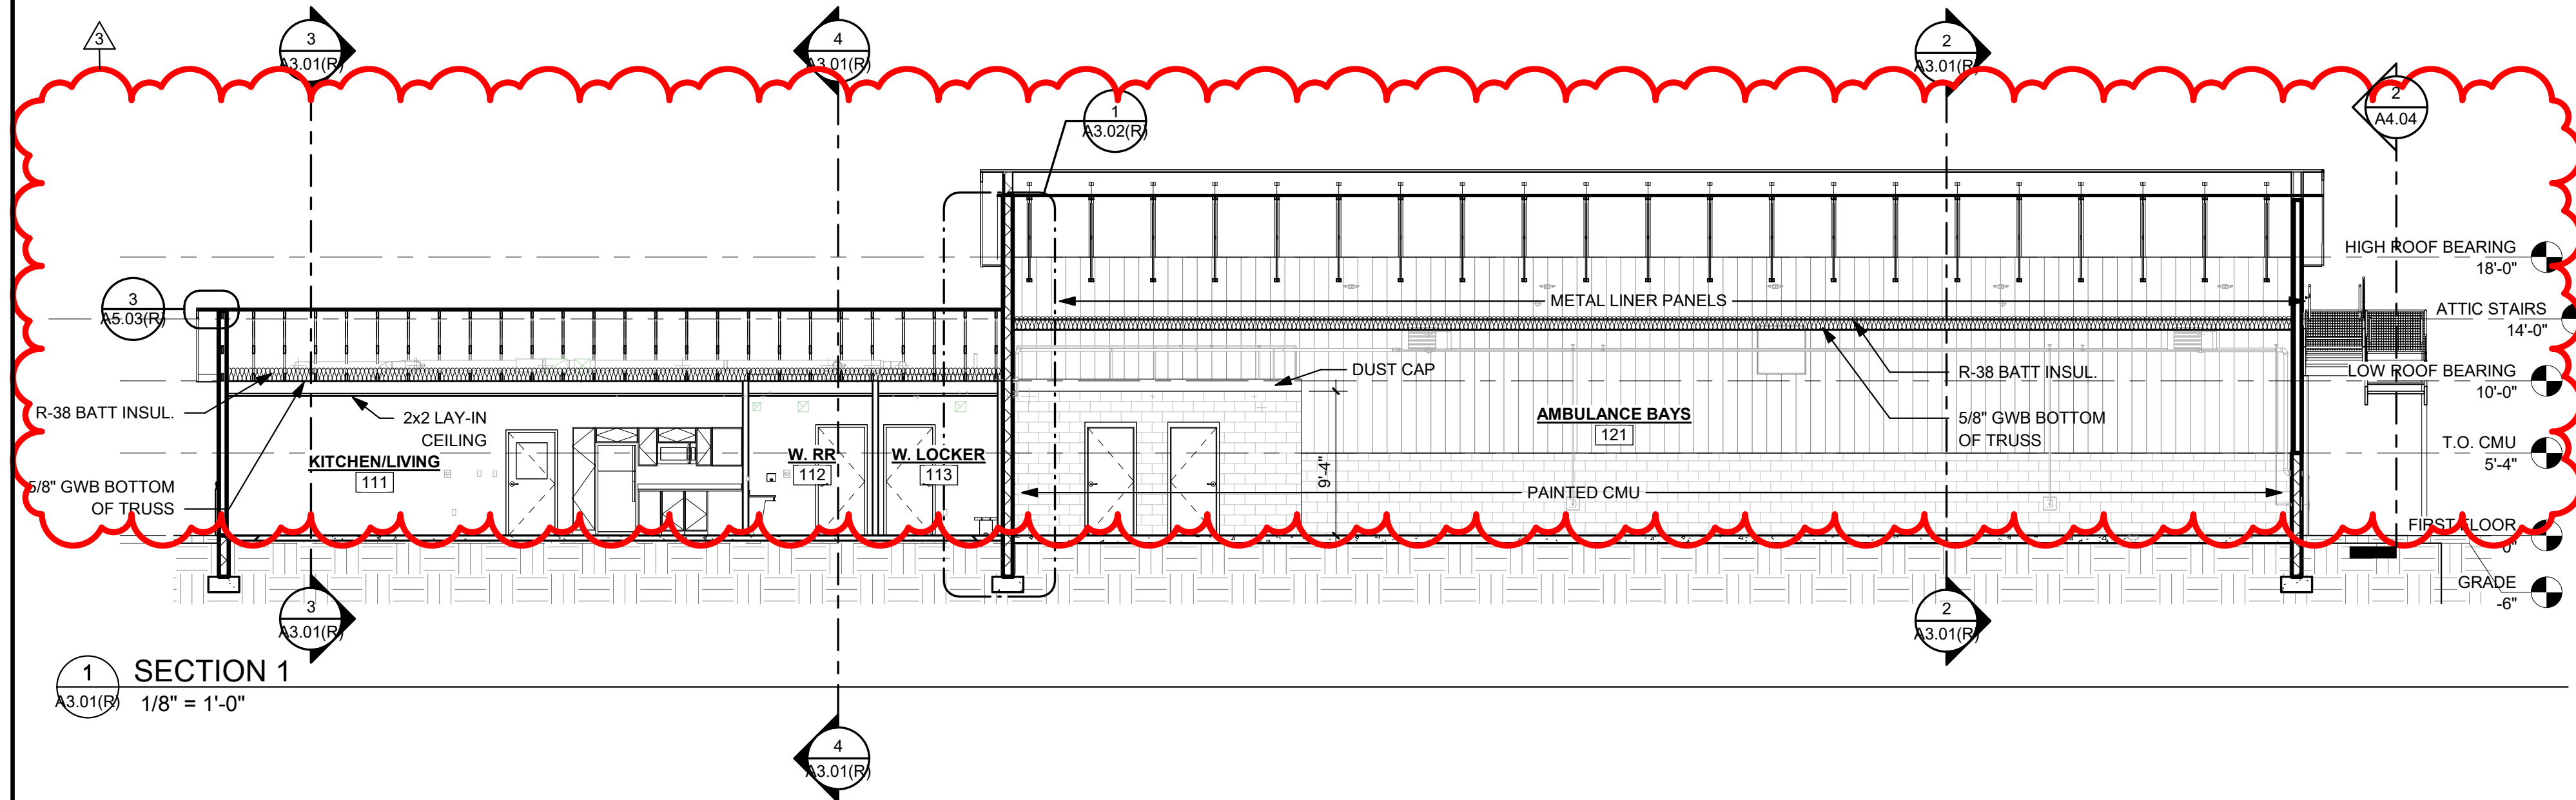

| NO. | BY | DATE | DESCRIPTION |
|-----|----|------|-------------|
| 3 | | | |

BROOKE COUNTY EMS
BROOKE COUNTY COMMISSION
3031 PLEASANT AVE, WELLSBURG WV 26070
FEBRUARY 24, 2023
CONSTRUCTION DOCUMENTS

DRAWN: DS DATE: 02/24/2023
CHECKED: PMF DATE: 02/24/2023

PROJECT No. T60-11009.00


BUILDING SECTIONS

SHEET No.

A3.01(R)

LAYOUT TAB - BUILDING SECTIONS
CAD FILE: R:\0501705-11009-00-BROOKE EMS\Brooke EMS.dwg
PLOT DATE/TIME: 4/4/2023 10:41:17 AM
USER: DS
3

2 HOUR FR

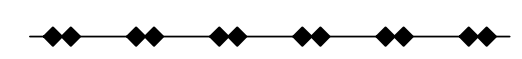

| NO. | BY | DATE | DESCRIPTION |
|-----|----|------|-------------|
| 3 | | | |

BROOKE COUNTY EMS
BROOKE COUNTY COMMISSION
3031 PLEASANT AVE, WELLSBURG WV 26070
FEBRUARY 24, 2023
CONSTRUCTION DOCUMENTS


DRAWN: DS DATE: 02/24/2023
CHECKED: PMF DATE: 02/24/2023

PROJECT No. T60-11009.00


WALL SECTIONS

SHEET No.

A3.02(R)

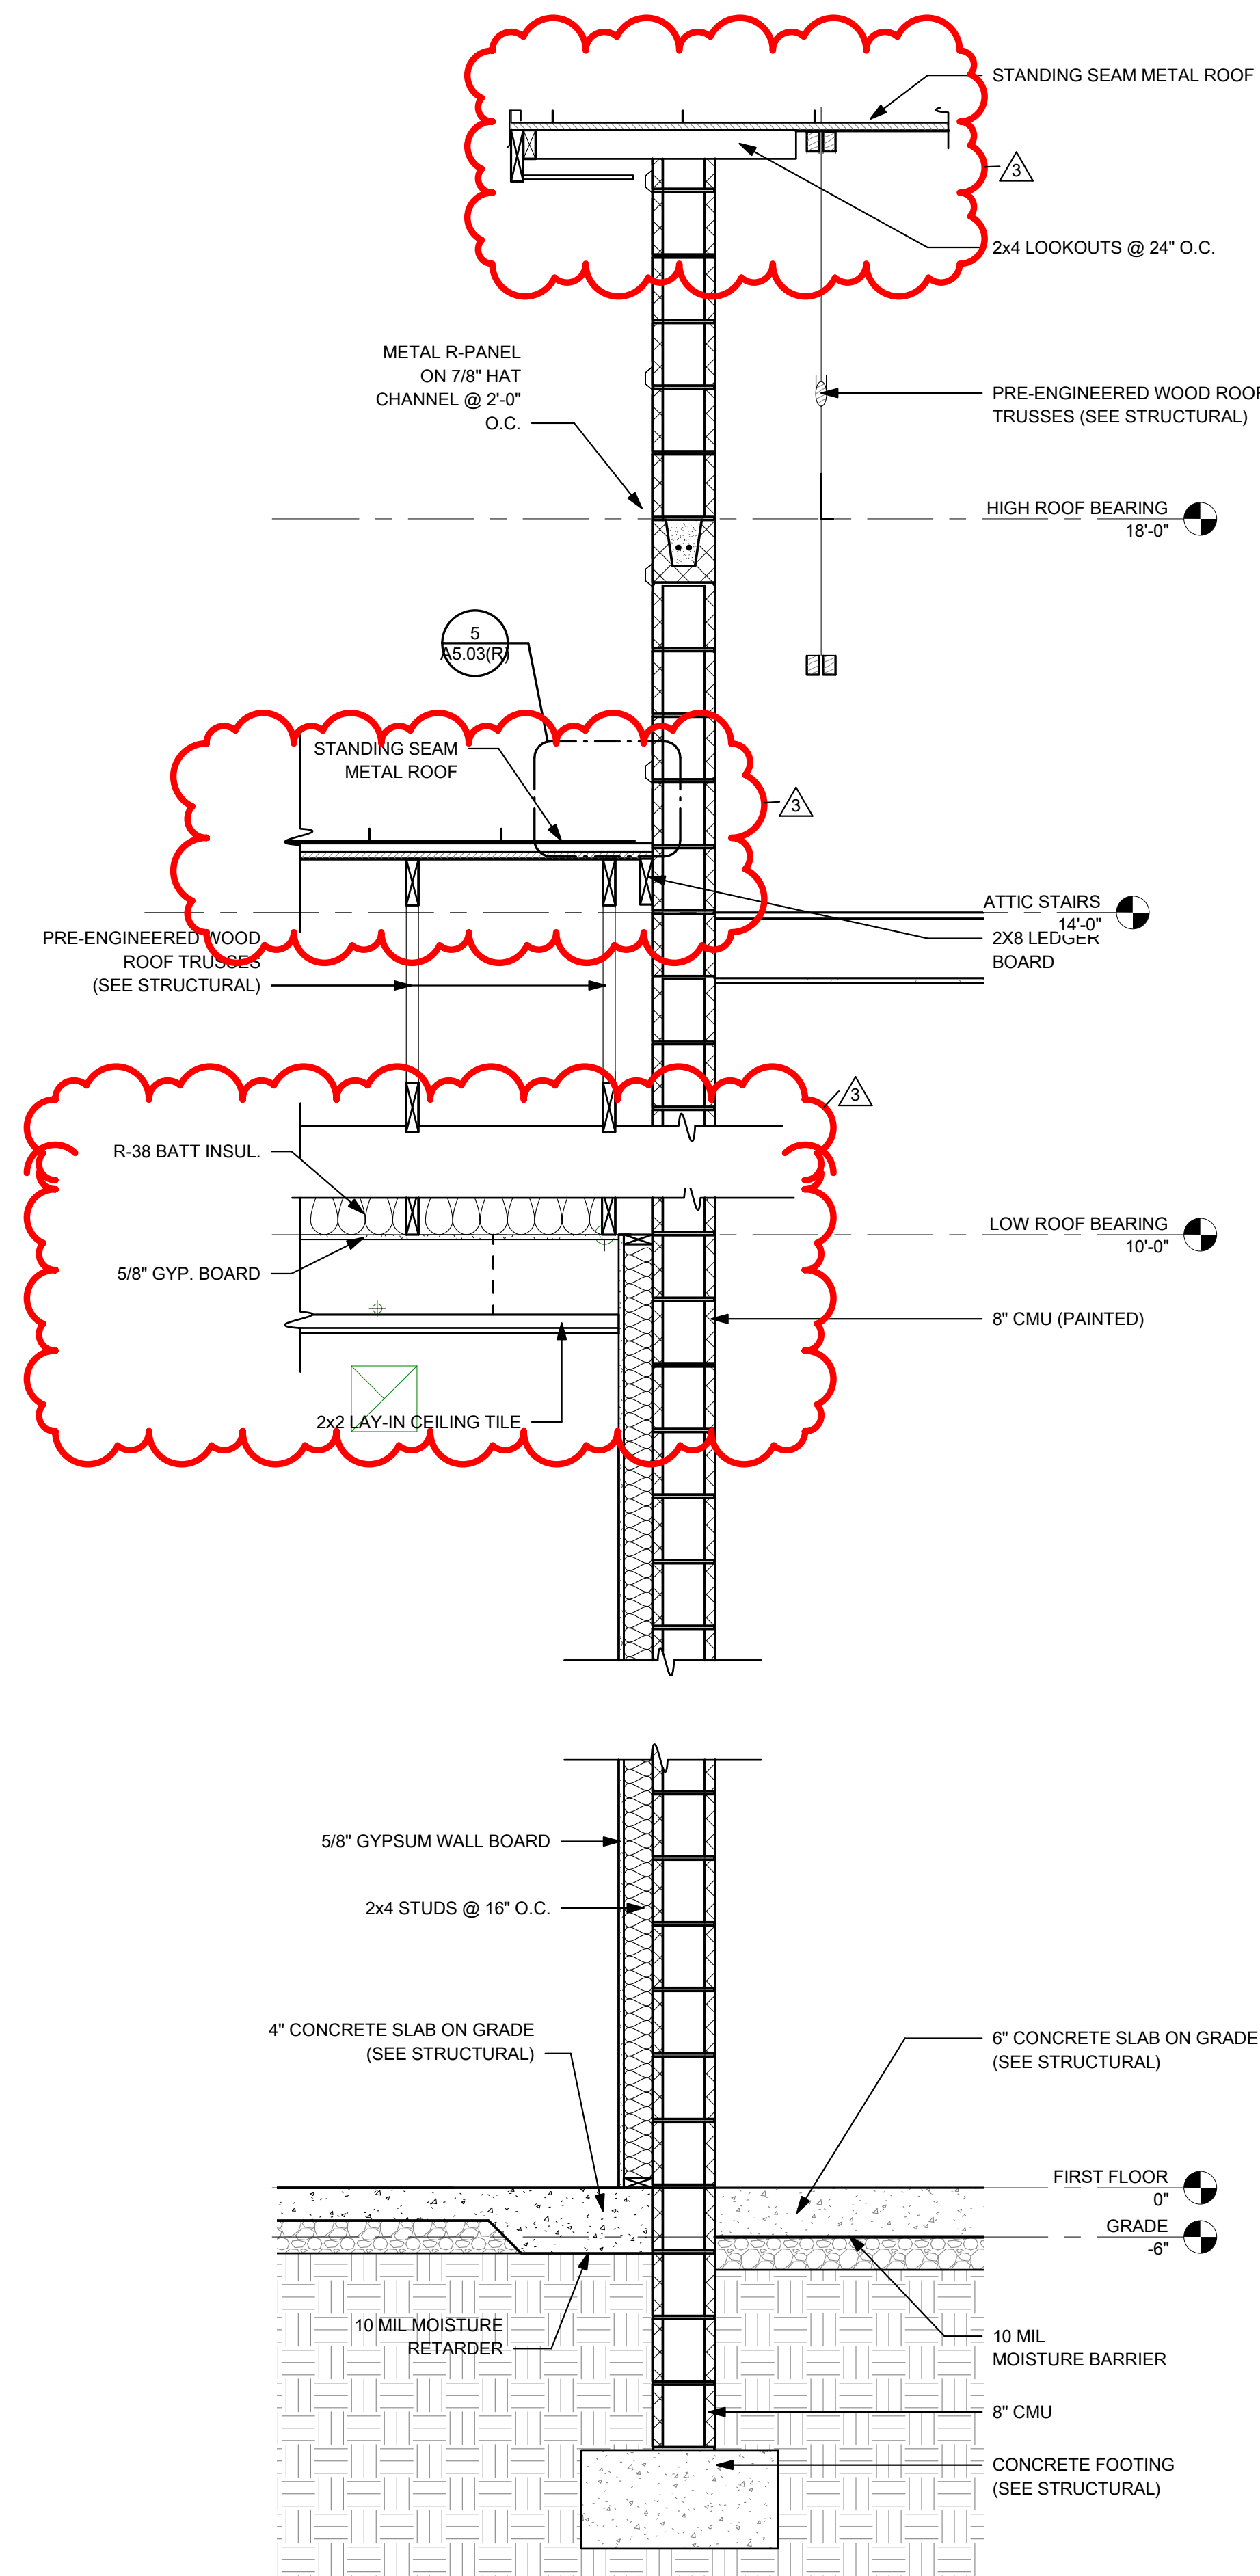


1 WALL SECTION 1
A3.02(R) 3/4" = 1'-0"

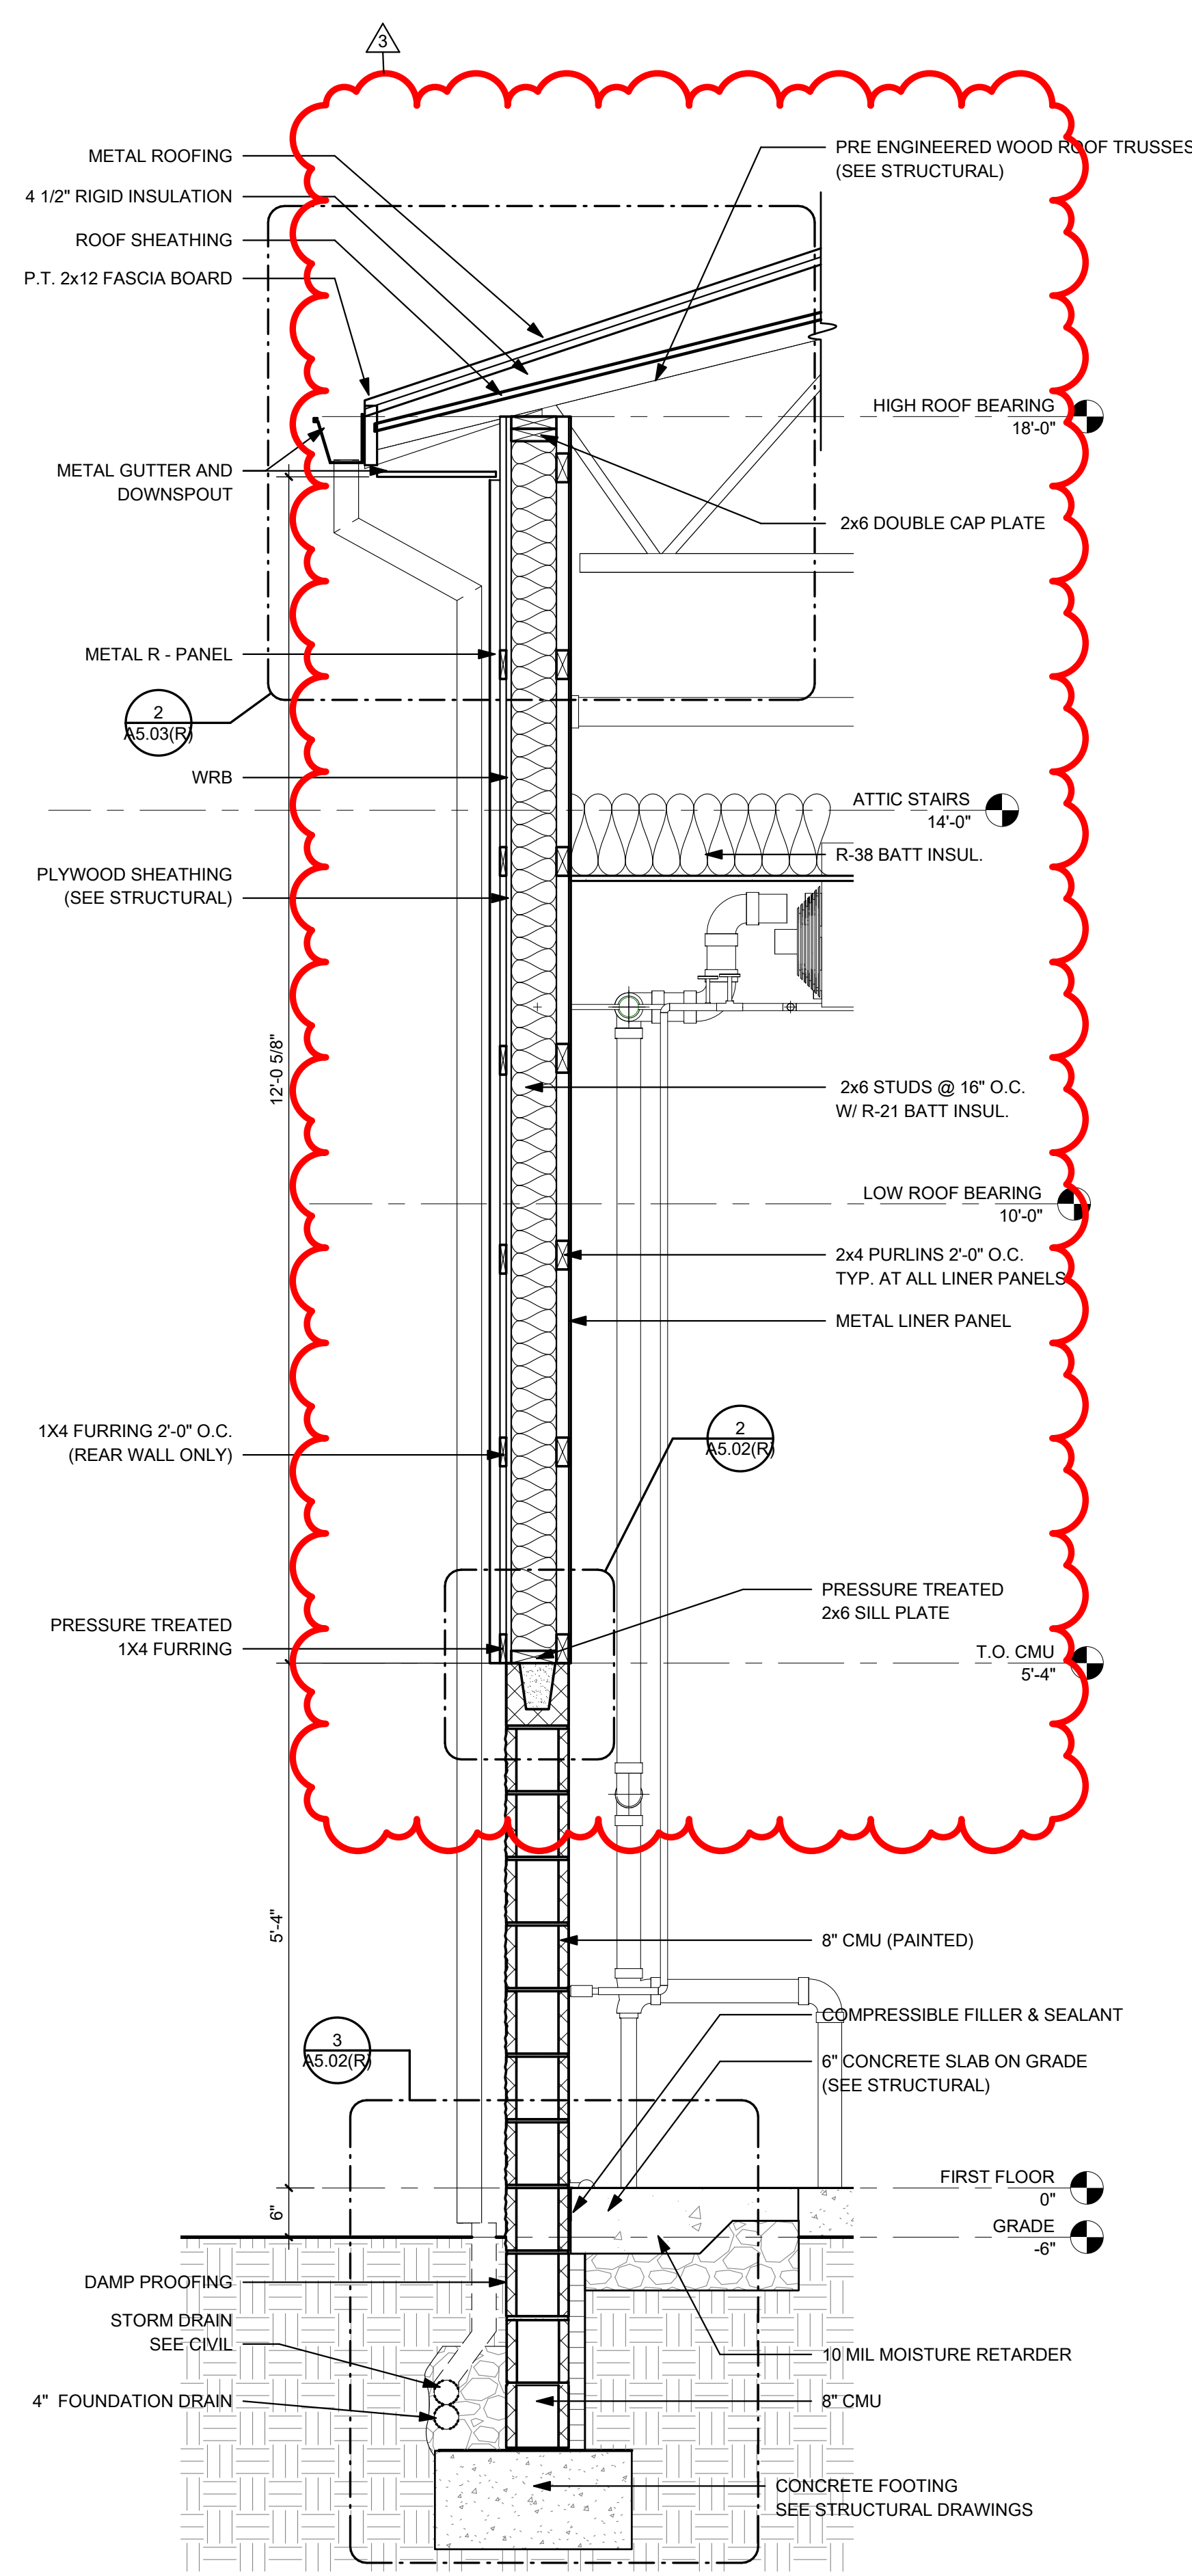

2 WALL SECTION 2
A3.02(R) 3/4" = 1'-0"

USER: DS

LAYOUT TAB: WALL SECTIONS
PLOT DATE/TIME: 4/4/2023 10:04:23 AM
CAD FILE: R:\0607016-11009-00-Brooke EMS\Brooke EMS.dwg

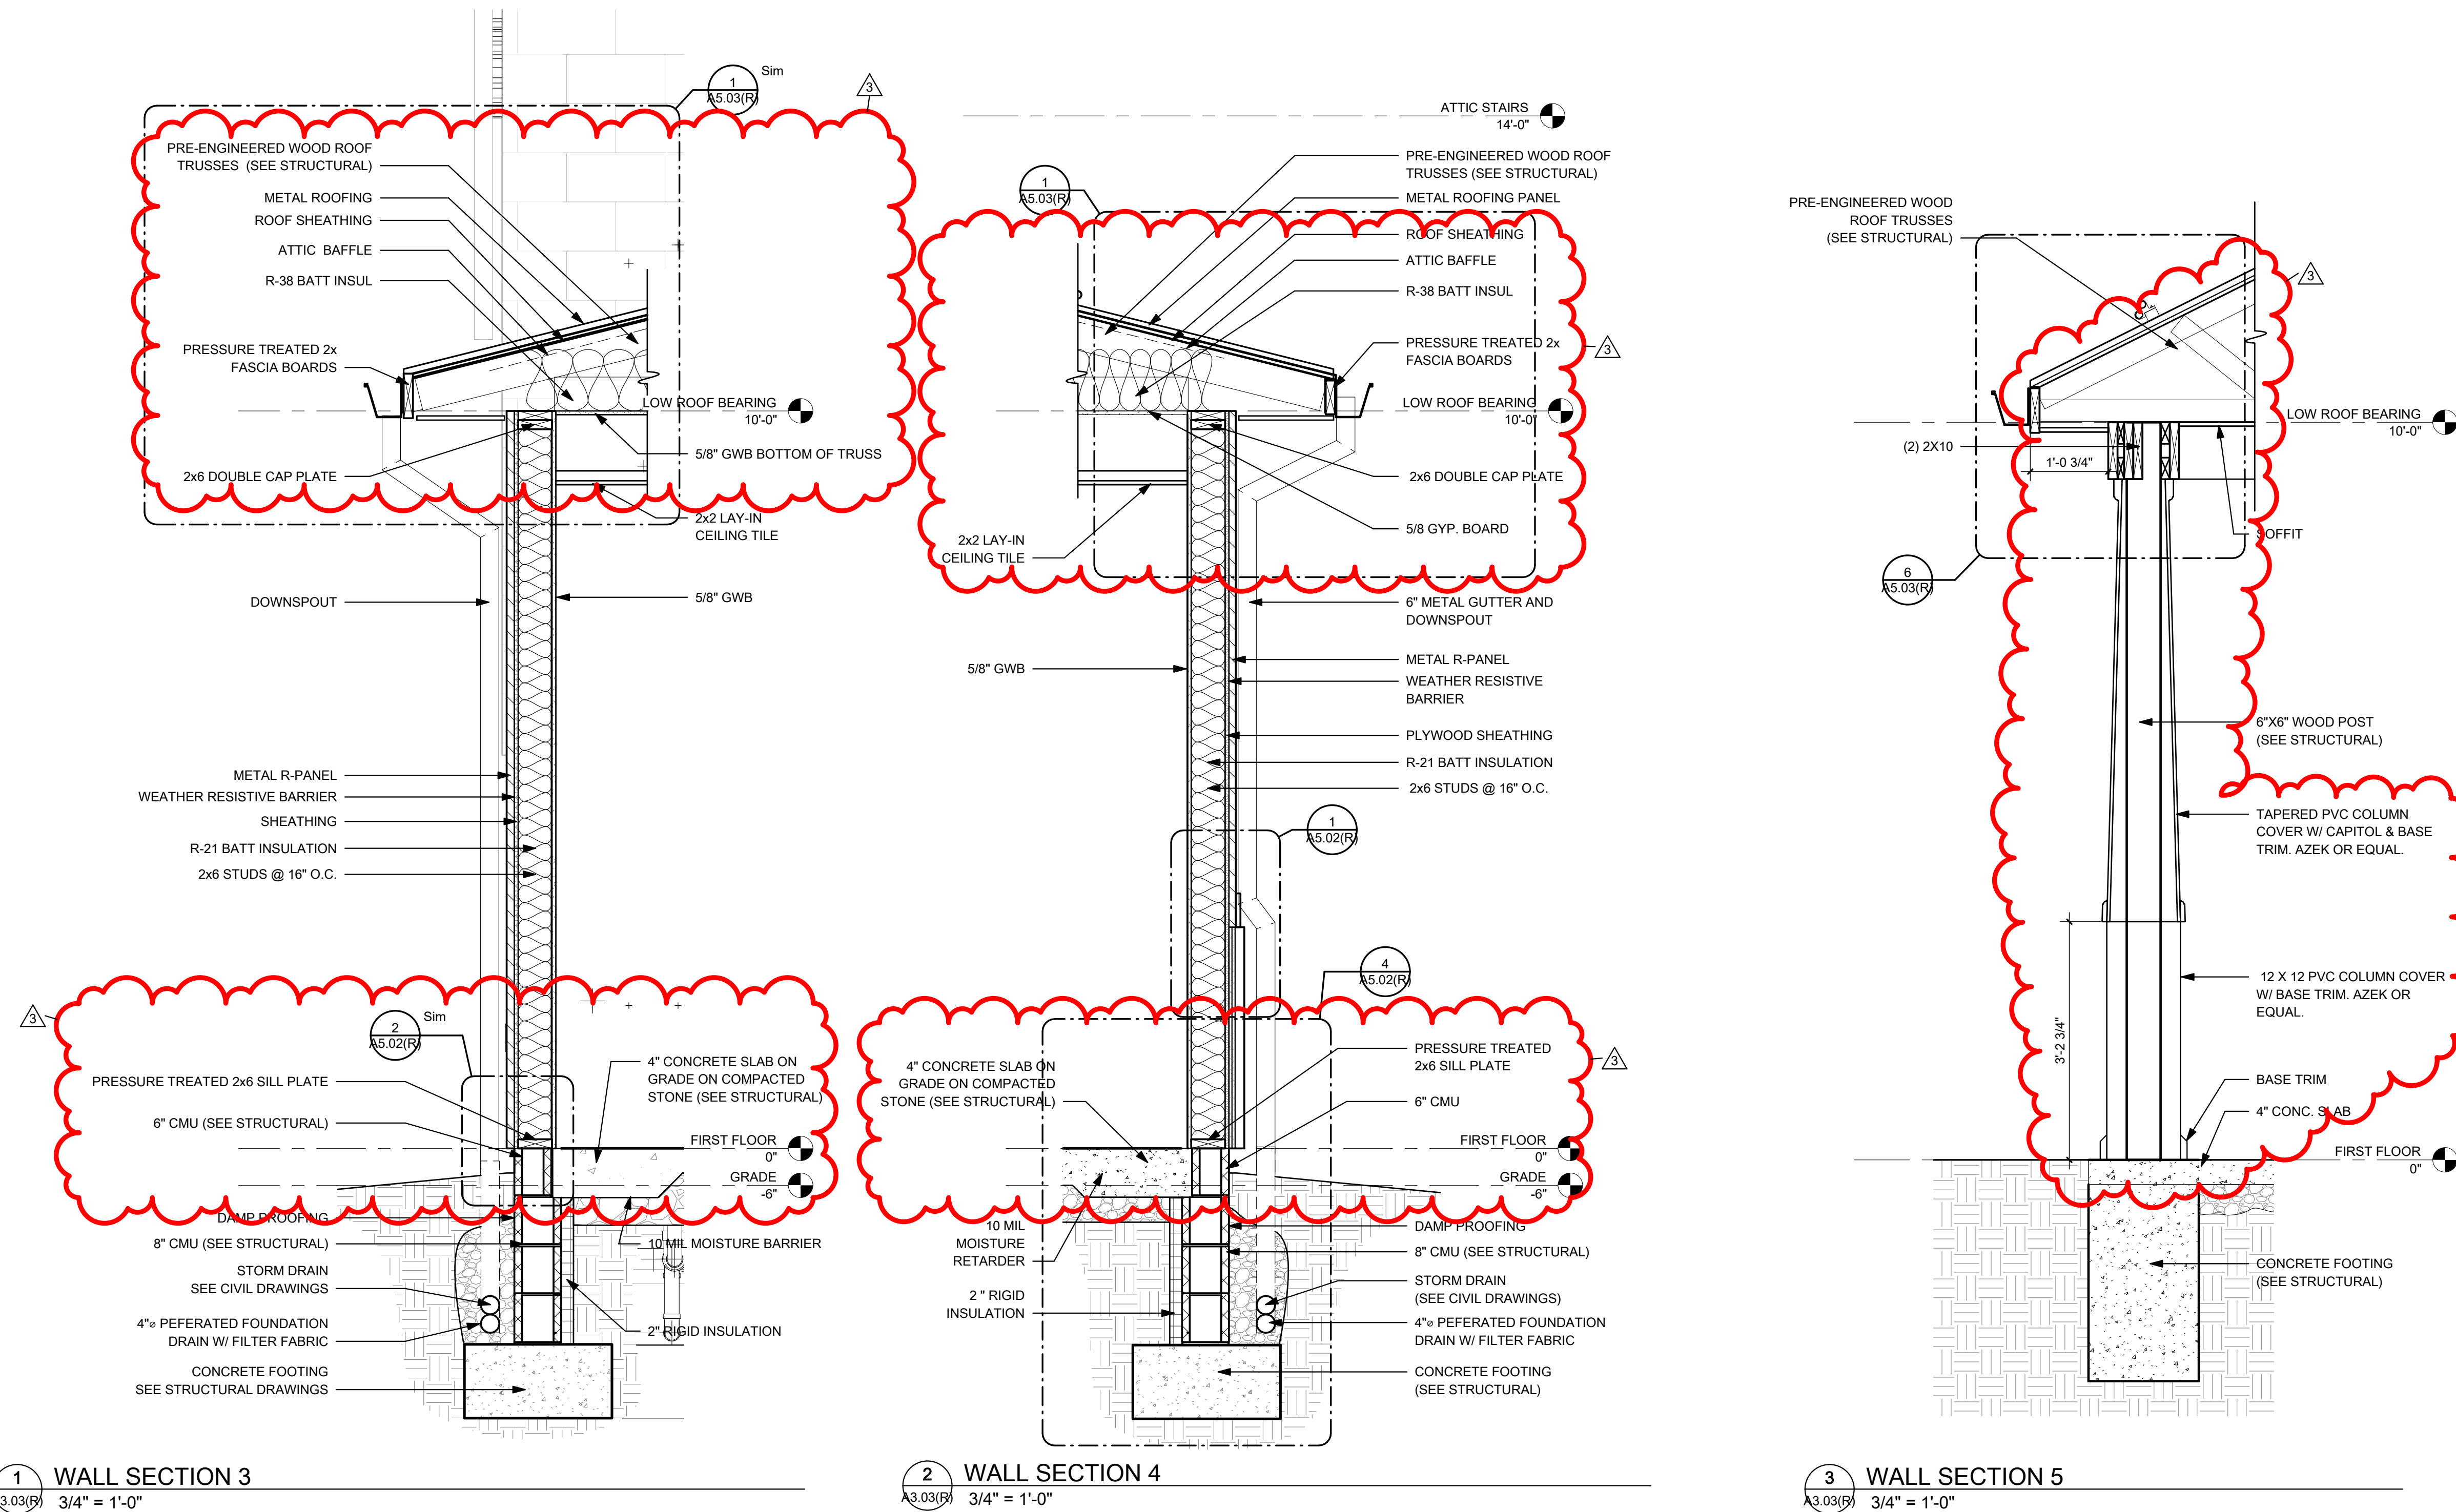

USER: DS

PLOT DATE/TIME: 4/4/2023 10:04:27 AM

LAYOUT TAB: WALL SECTIONS
CAD FILE: R:\0507150-1100-00-Brooke EMS\Brooke EMS.dwg, 2/2022/14

ADDENDUM NO. 3

Date 3

BY

No.

DESCRIPTION

BROOKE COUNTY EMS
BROOKE COUNTY COMMISSION
3031 PLEASANT AVE, WELLSBURG WV 26070
FEBRUARY 24, 2023
CONSTRUCTION DOCUMENTS

DRAWN: DS DATE: 02/24/2023
CHECKED: PMF DATE: 02/24/2023

PROJECT No. T60-11009.00

WALL SECTIONS

SHEET No.

A3.03(R)

| NO. | BY | DATE | DESCRIPTION |
|-----|----|------|---------------|
| 3 | | | ADDENDUM NO.3 |

BROOKE COUNTY EMS
BROOKE COUNTY COMMISSION
3031 PLEASANT AVE, WELLSBURG WV 26070
FEBRUARY 24, 2023
CONSTRUCTION DOCUMENTS


DRAWN: DS DATE: 02/24/2023
CHECKED: PMF DATE: 02/24/2023

PROJECT No. T60-11009.00


DOOR AND WINDOW DETAILS

SHEET No.


A5.01(R)

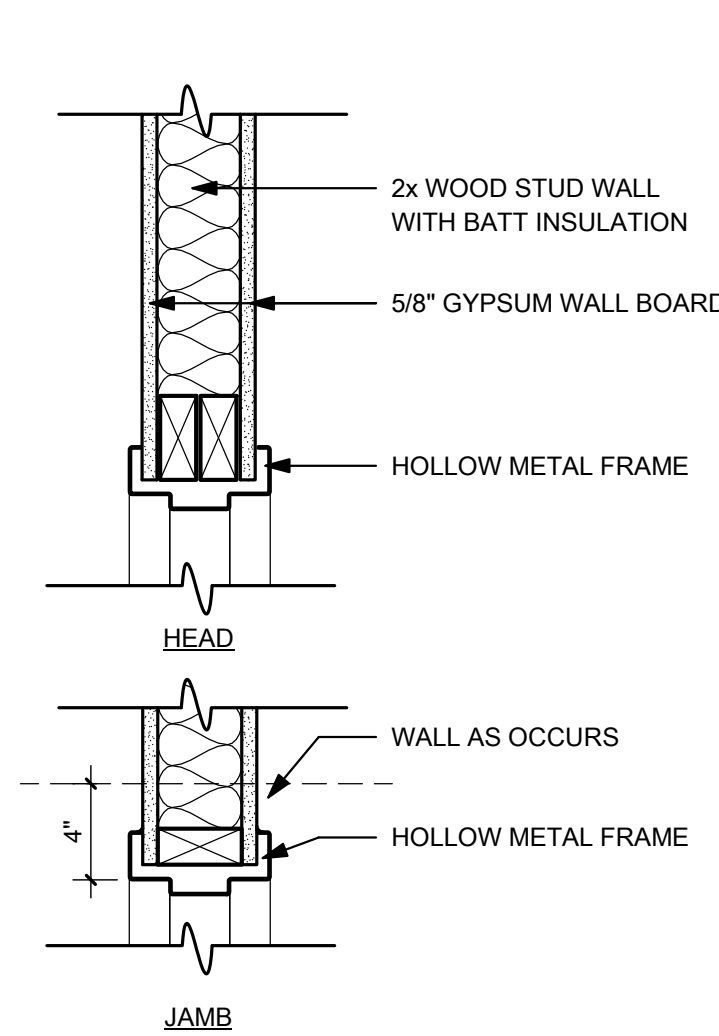


1 DOOR DETAIL - INT. - WALL TYPE A
A5.01(R) 1 1/2" = 1'-0"

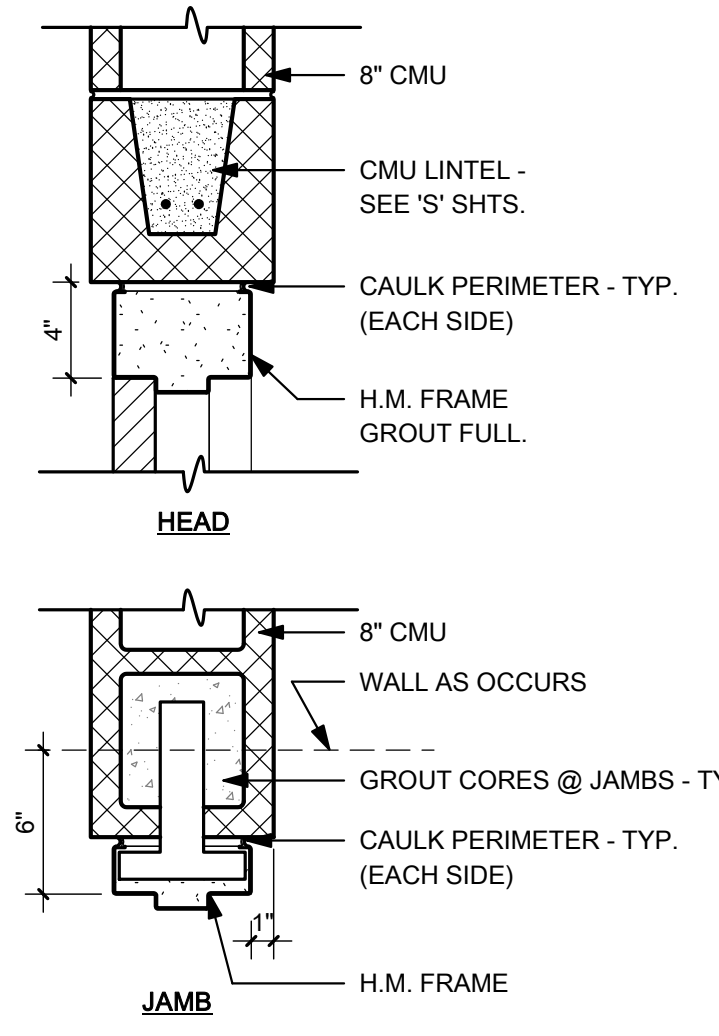


2 DOOR DETAIL - INT. - WALL TYPE B
A5.01(R) 1 1/2" = 1'-0"

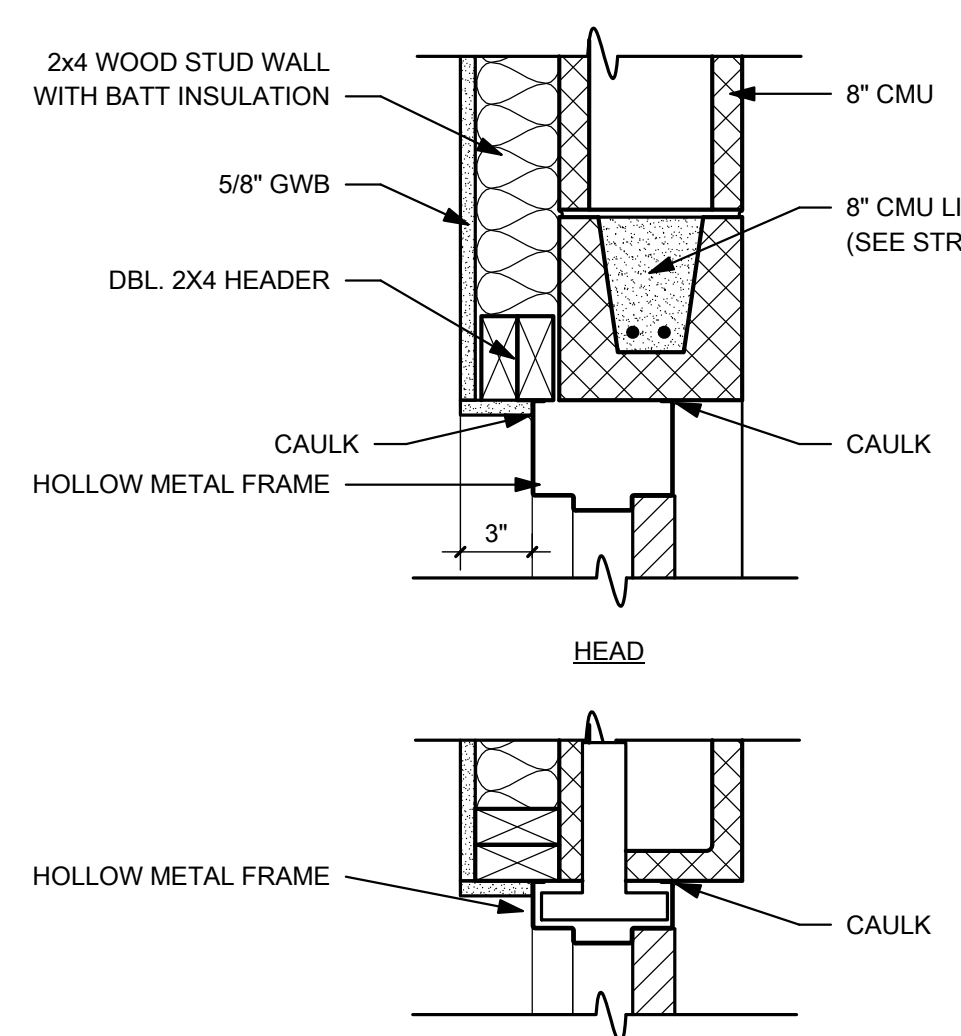





3 DOOR DETAIL - INT. - WALL TYPE C
A5.01(R) 1 1/2" = 1'-0"

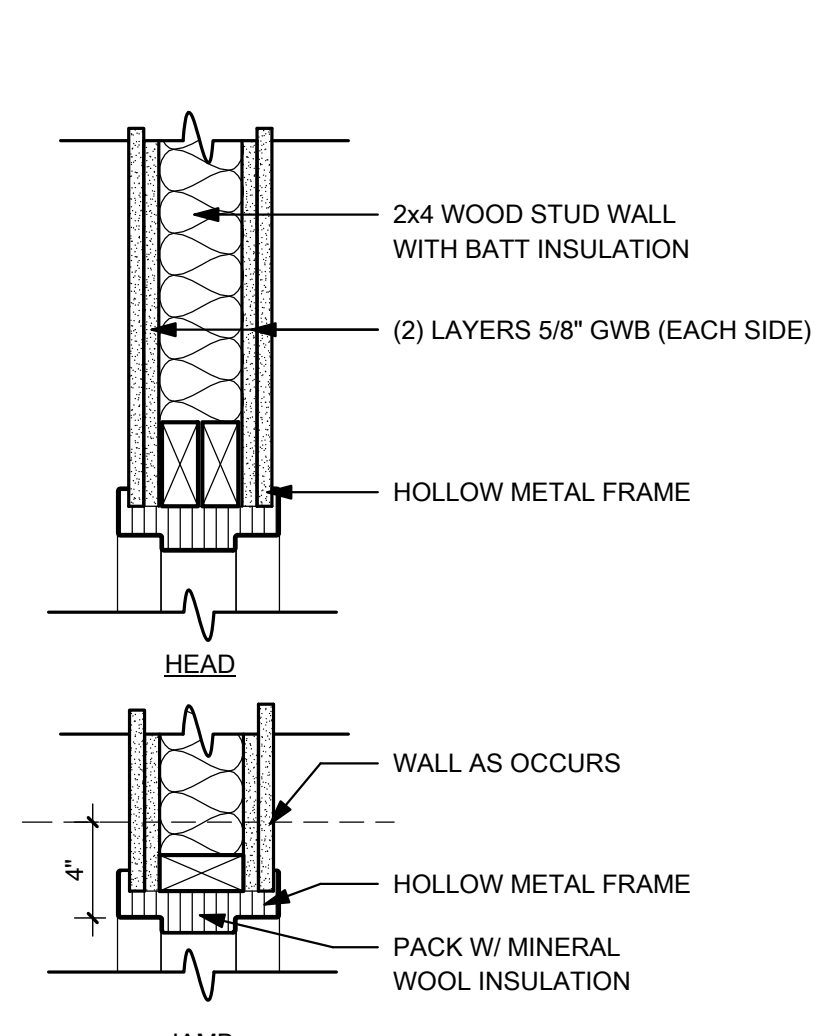





4 DOOR DETAIL - INT. - WALL TYPE D
A5.01(R) 1 1/2" = 1'-0"

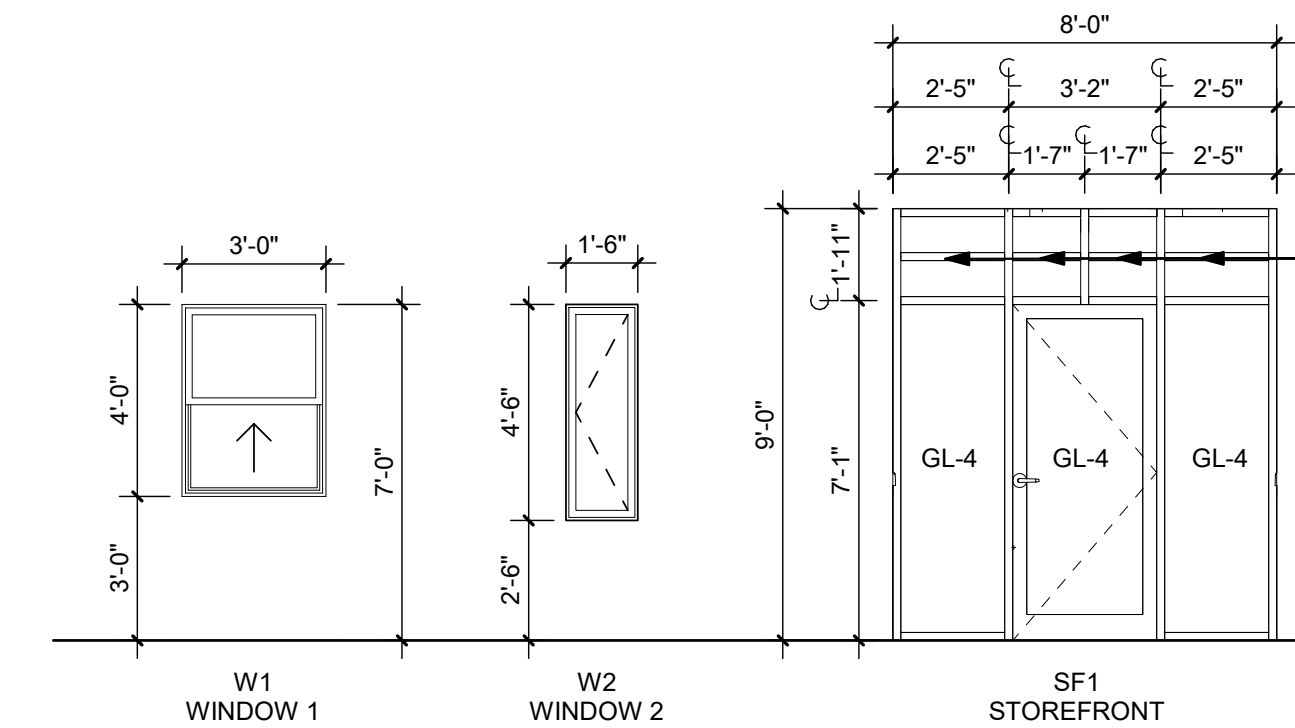





WINDOW TYPE LEGEND
1/4" = 1'-0"

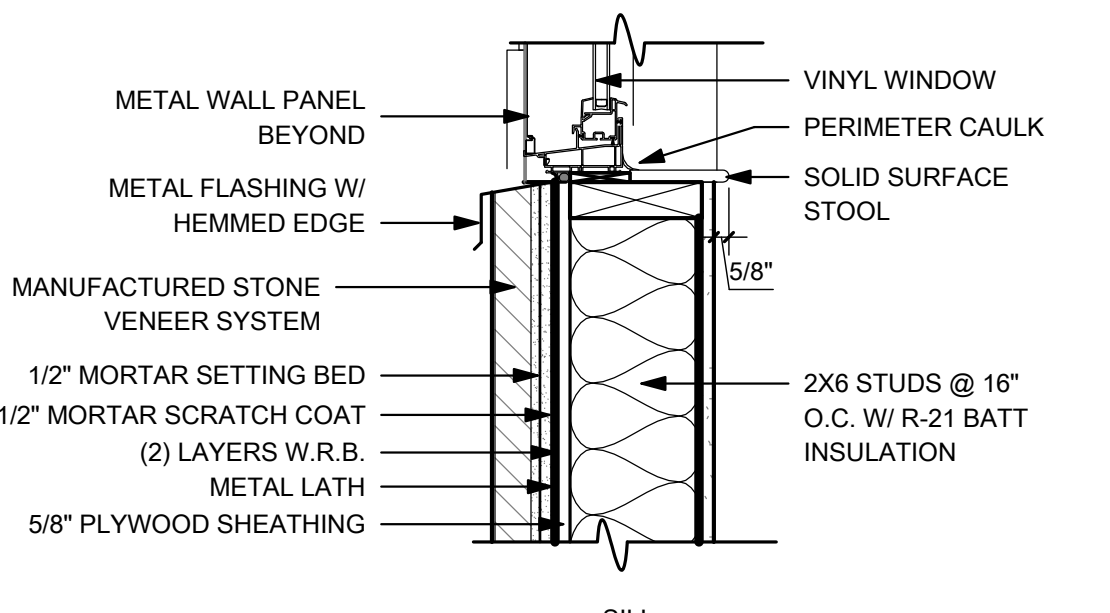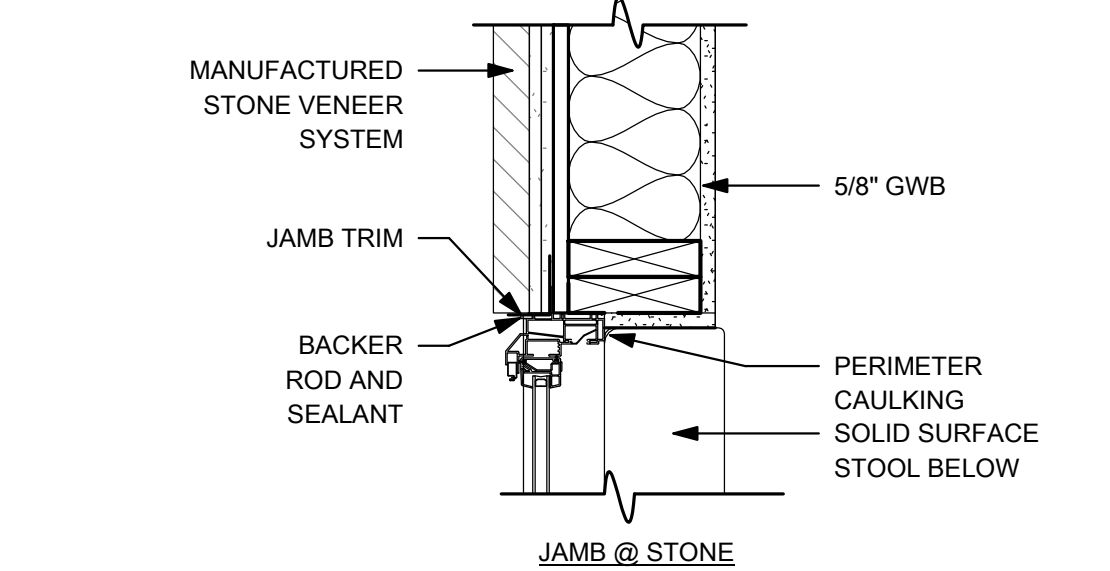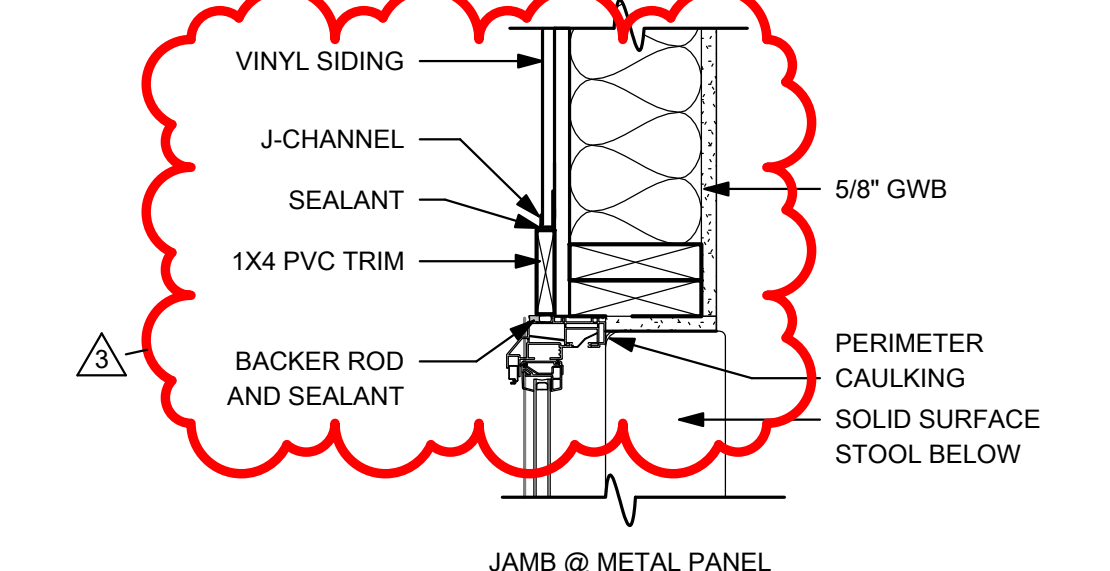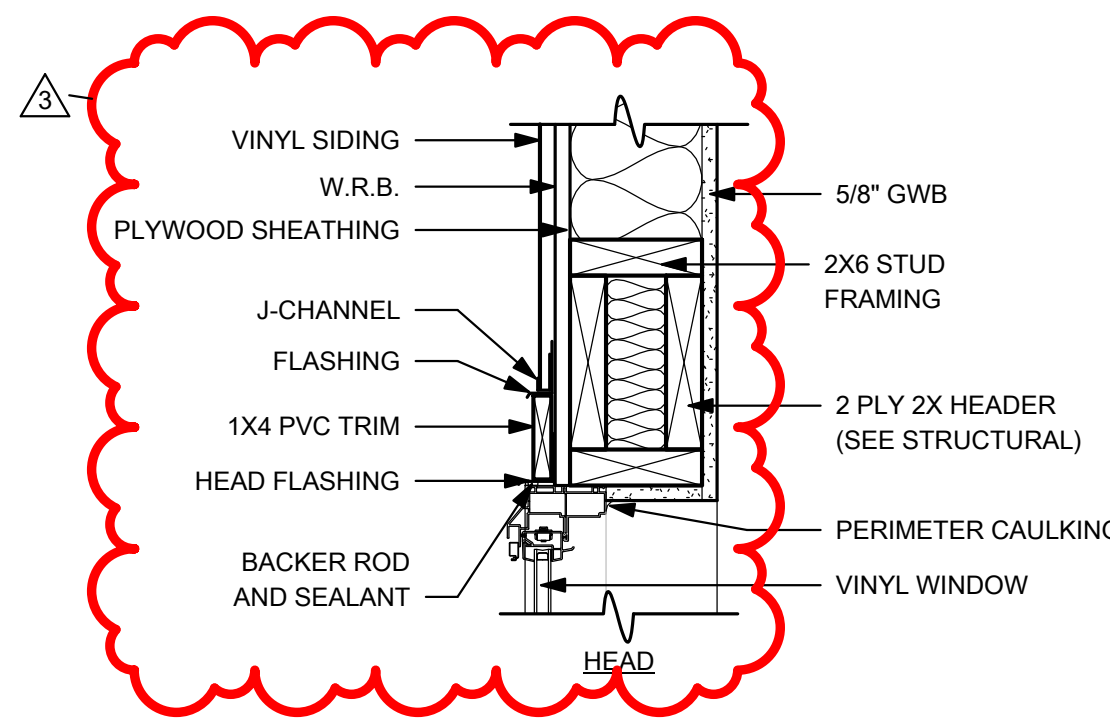




5 WINDOW DETAIL - EXT. (TYP.)
A5.01(R) 1 1/2" = 1'-0"

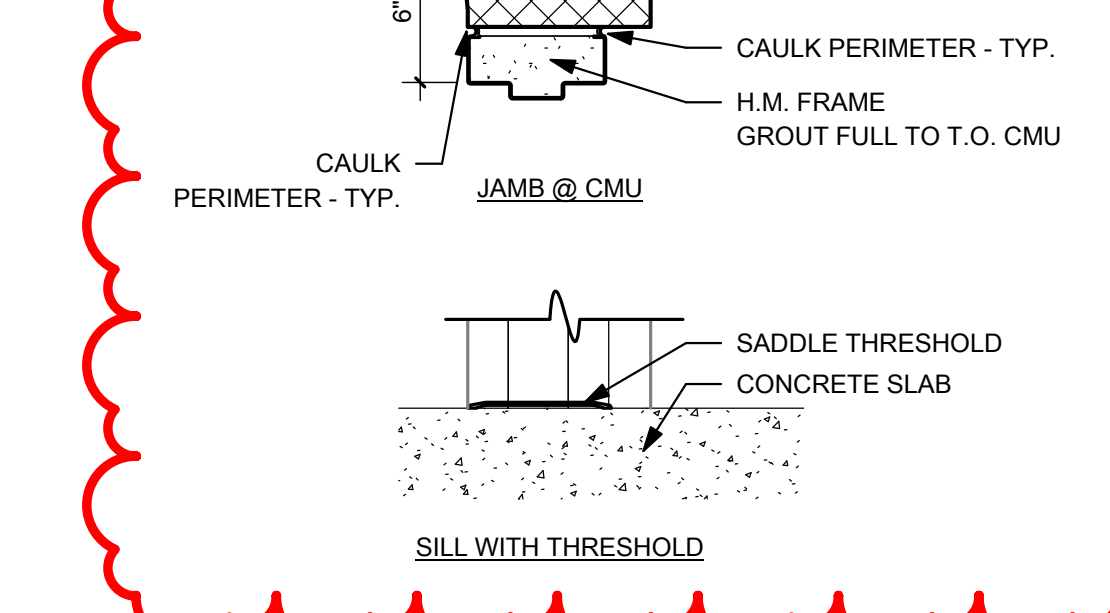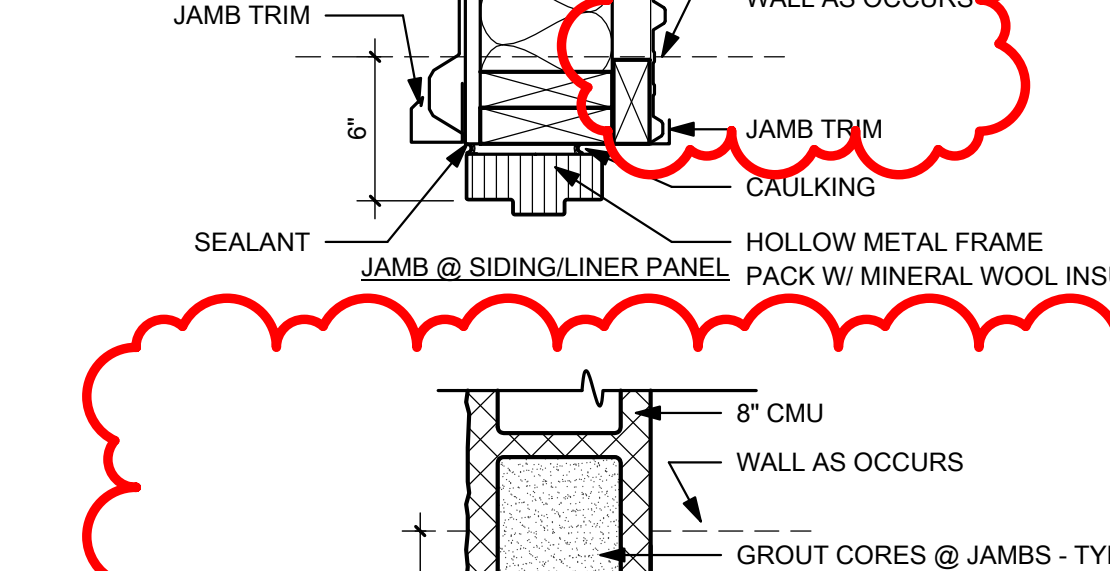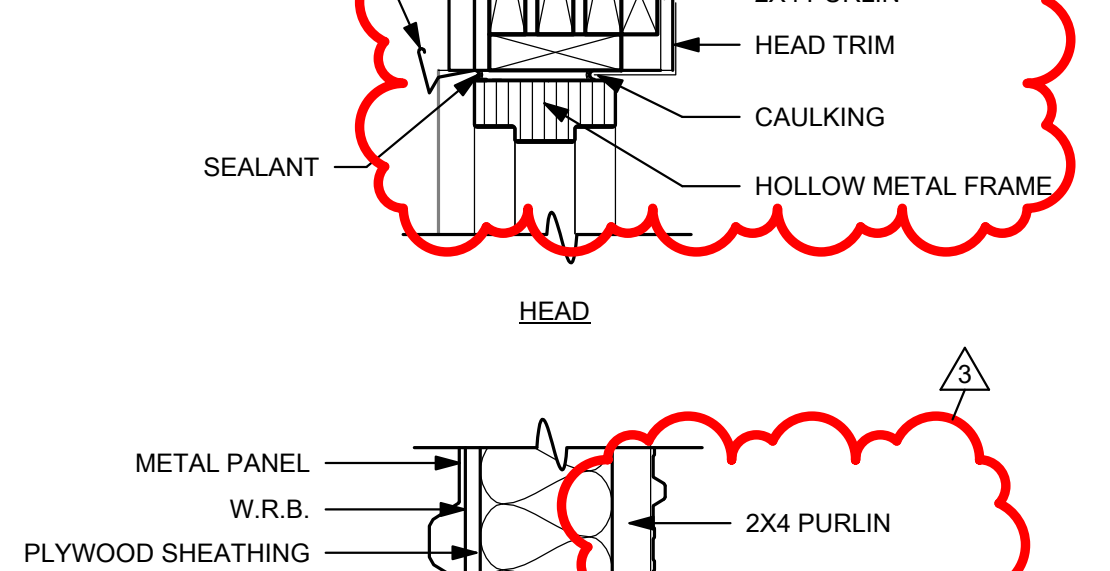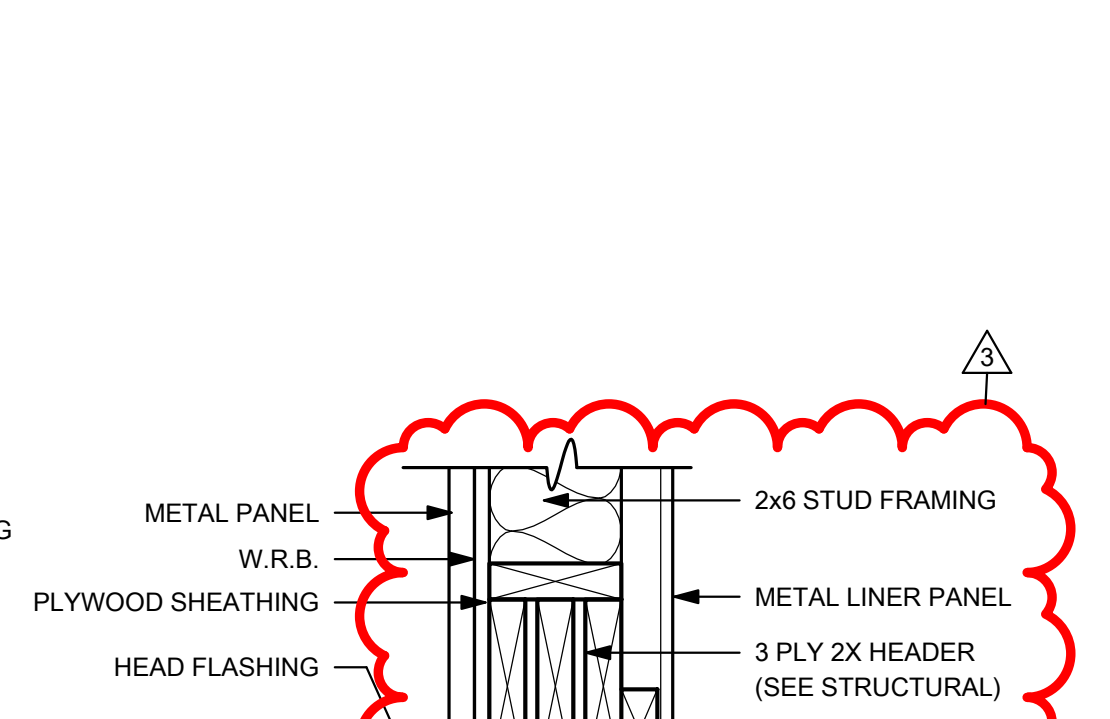

6 DOOR DETAIL @ METAL SIDING/CMU/LINER PANEL
A5.01(R) 1 1/2" = 1'-0"

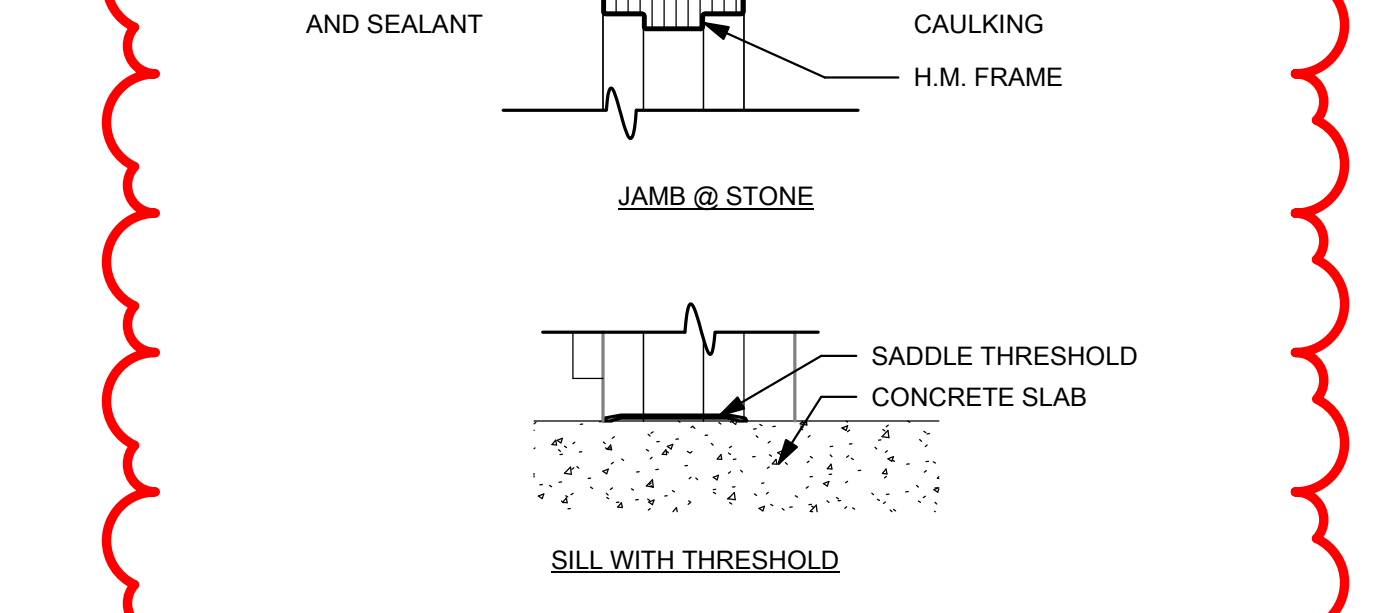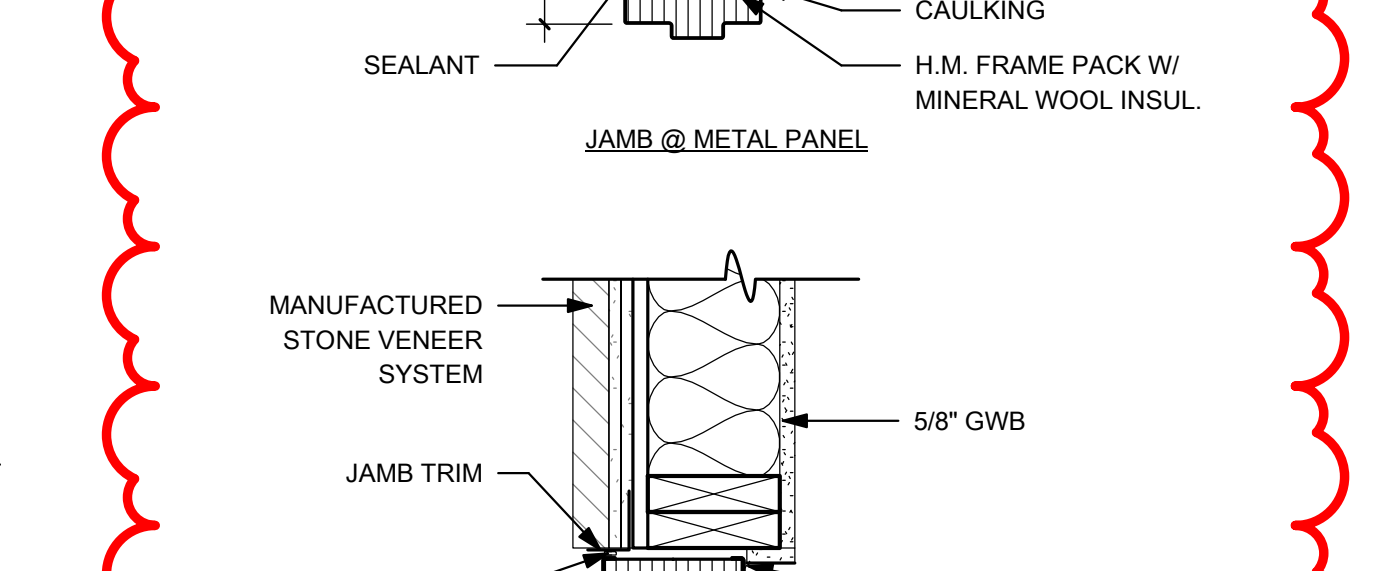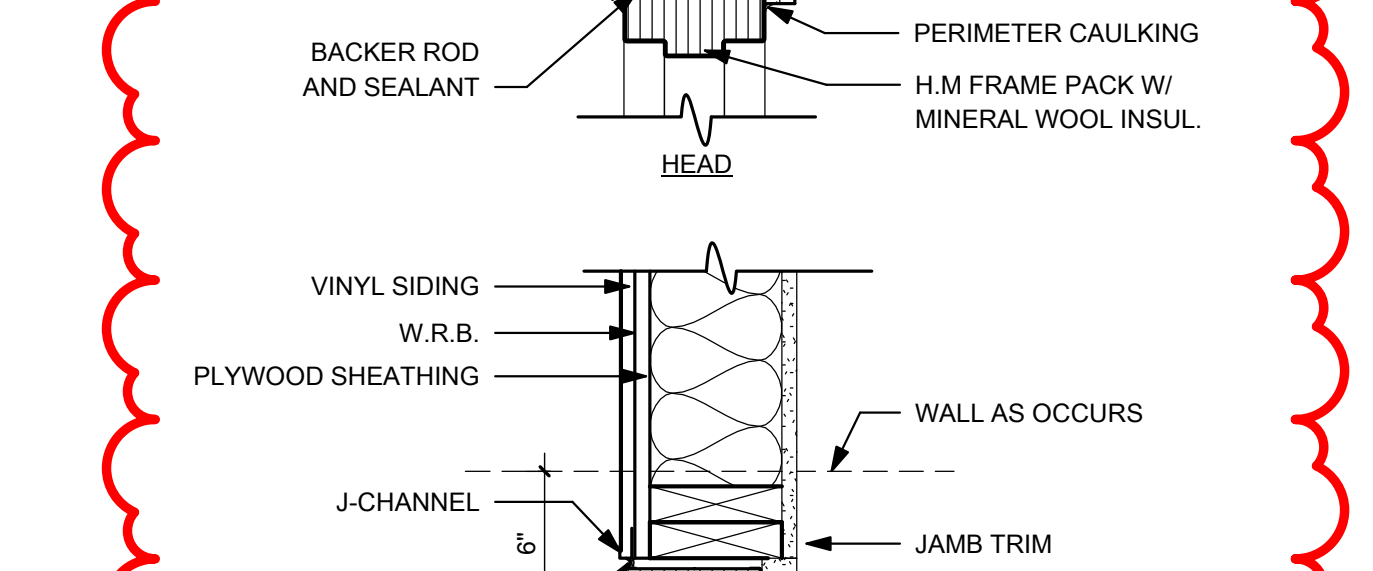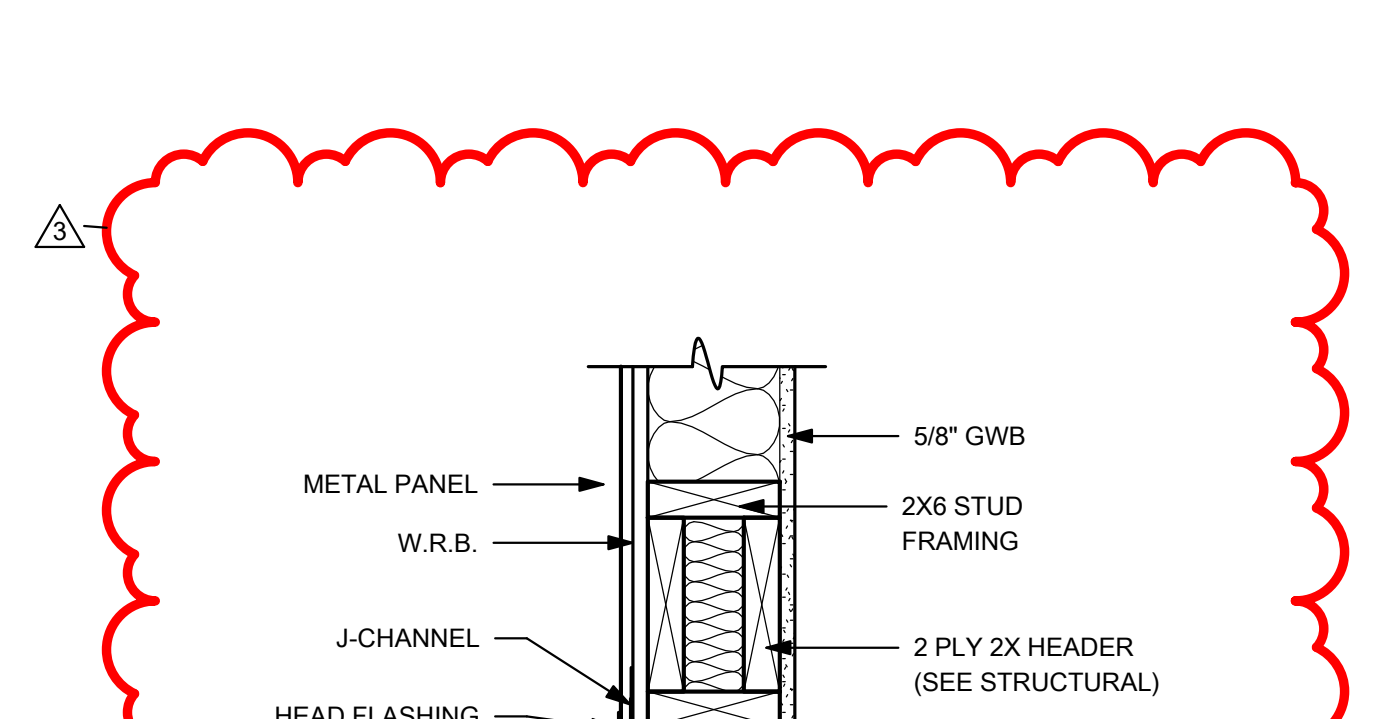


7 DOOR DETAIL @ STONE/ METAL PANEL
A5.01(R) 1 1/2" = 1'-0"

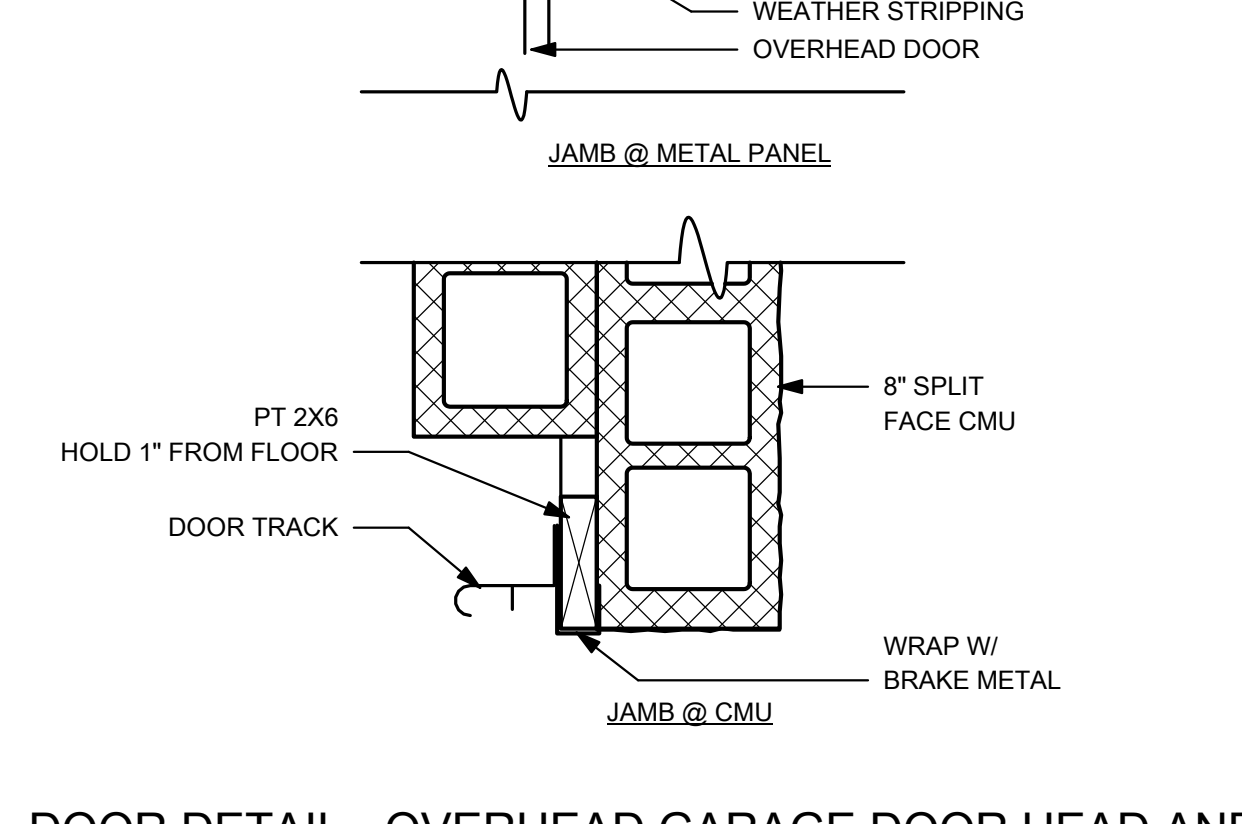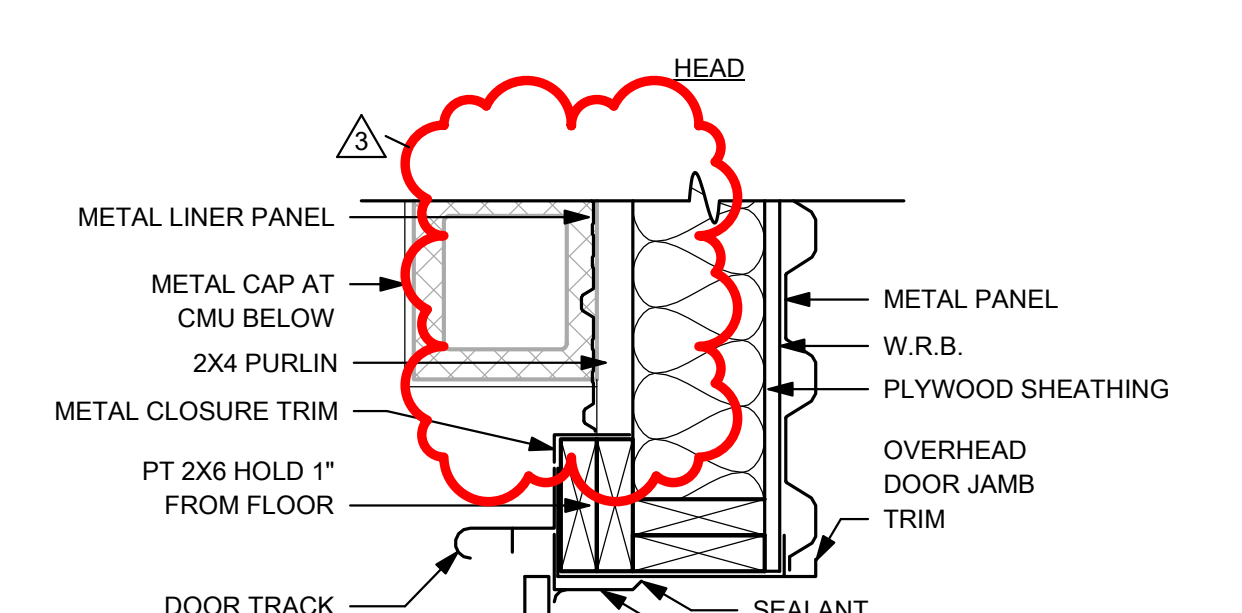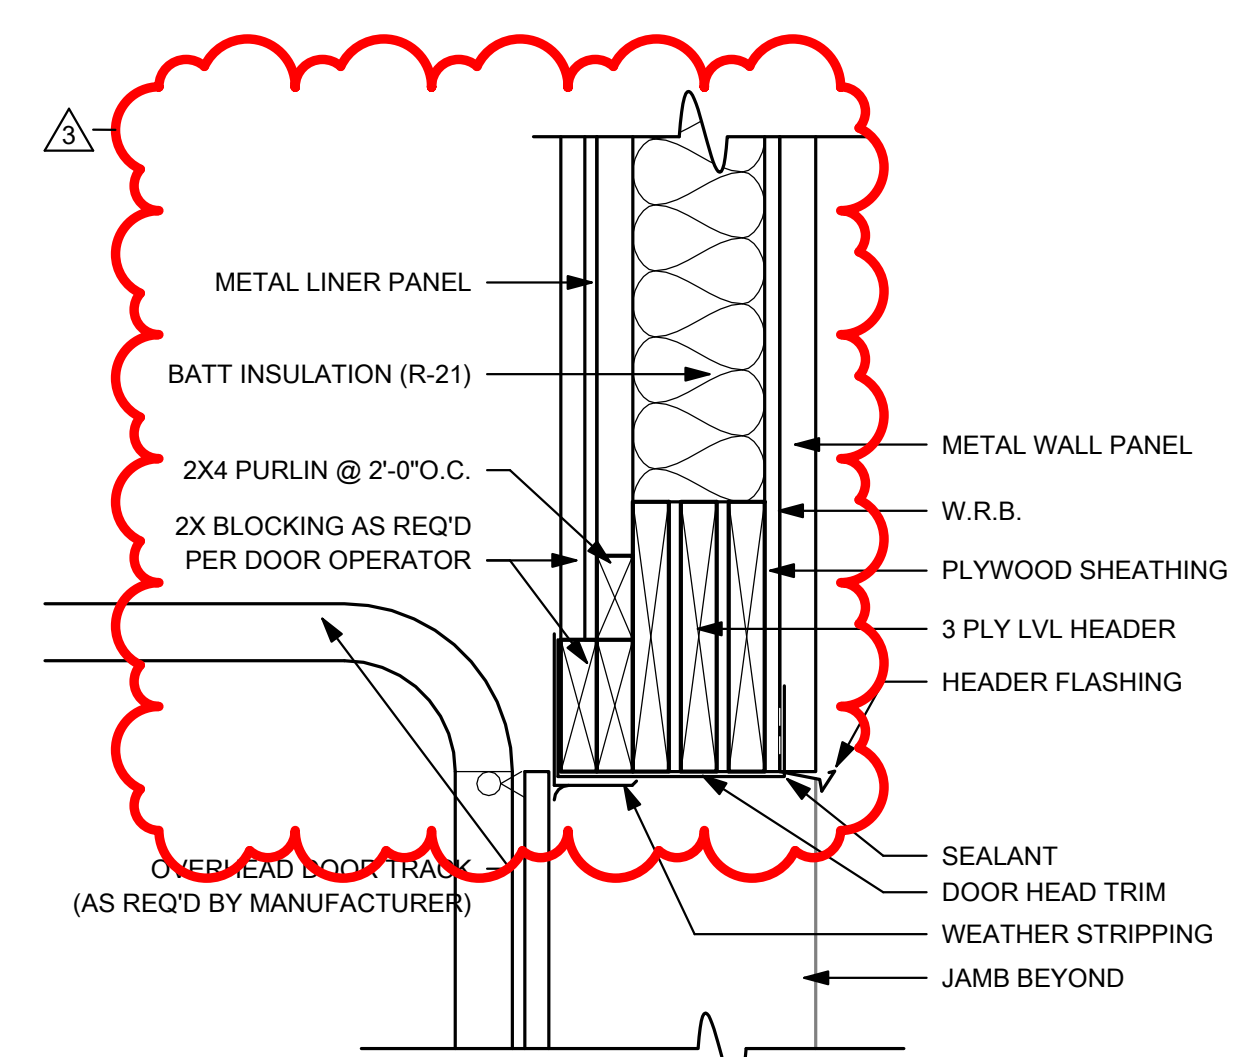


8 DOOR DETAIL - OVERHEAD GARAGE DOOR HEAD AND JAMB DETAIL
A5.01(R) 1 1/2" = 1'-0"


LAYOUT TAB: DOOR AND WINDOW DETAILS
CAD FILE: R:\0001761-11009-00-Brooke EMS\Brooke County Commission-Drawing\Rev\02020302-A5.01(R).DWG
PLOT DATE/TIME: 4/4/2023 10:04:54 AM
USER: DS
3

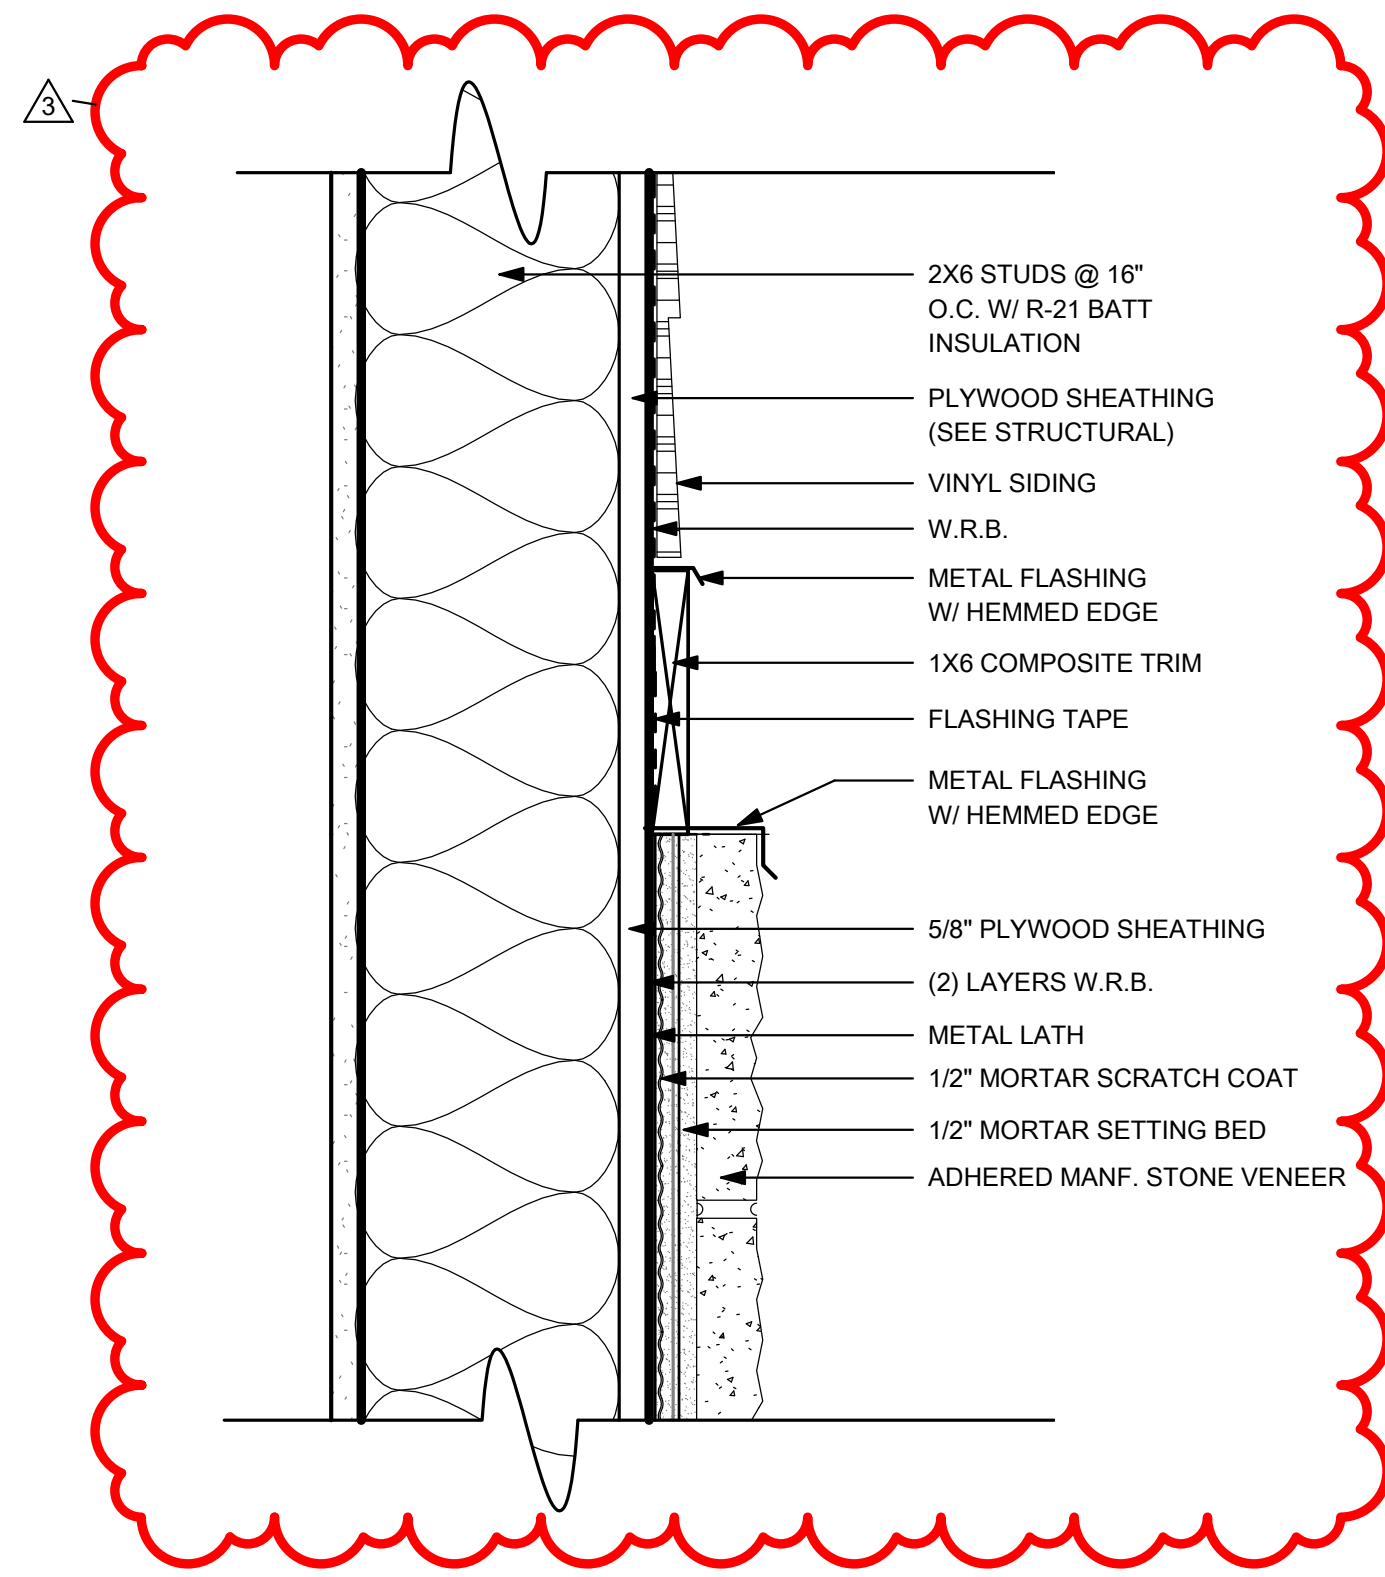


1 DETAIL - METAL PANEL/MSV
A5.02(R) 3" = 1'-0"

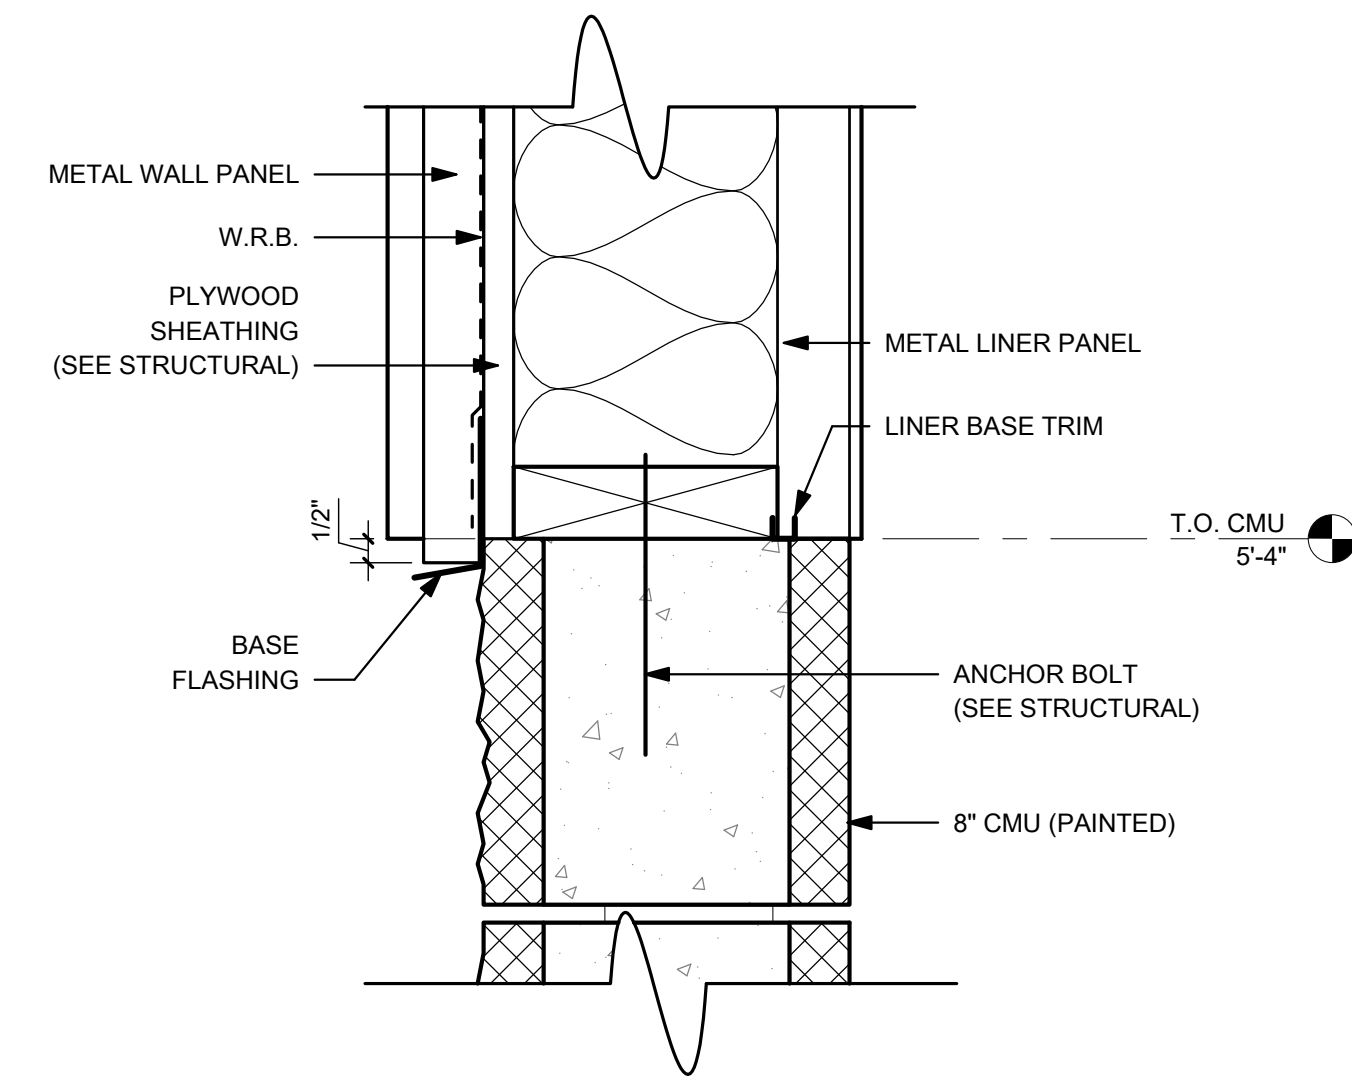

2 DETAIL - METAL PANEL/CMU
A5.02(R) 3" = 1'-0"

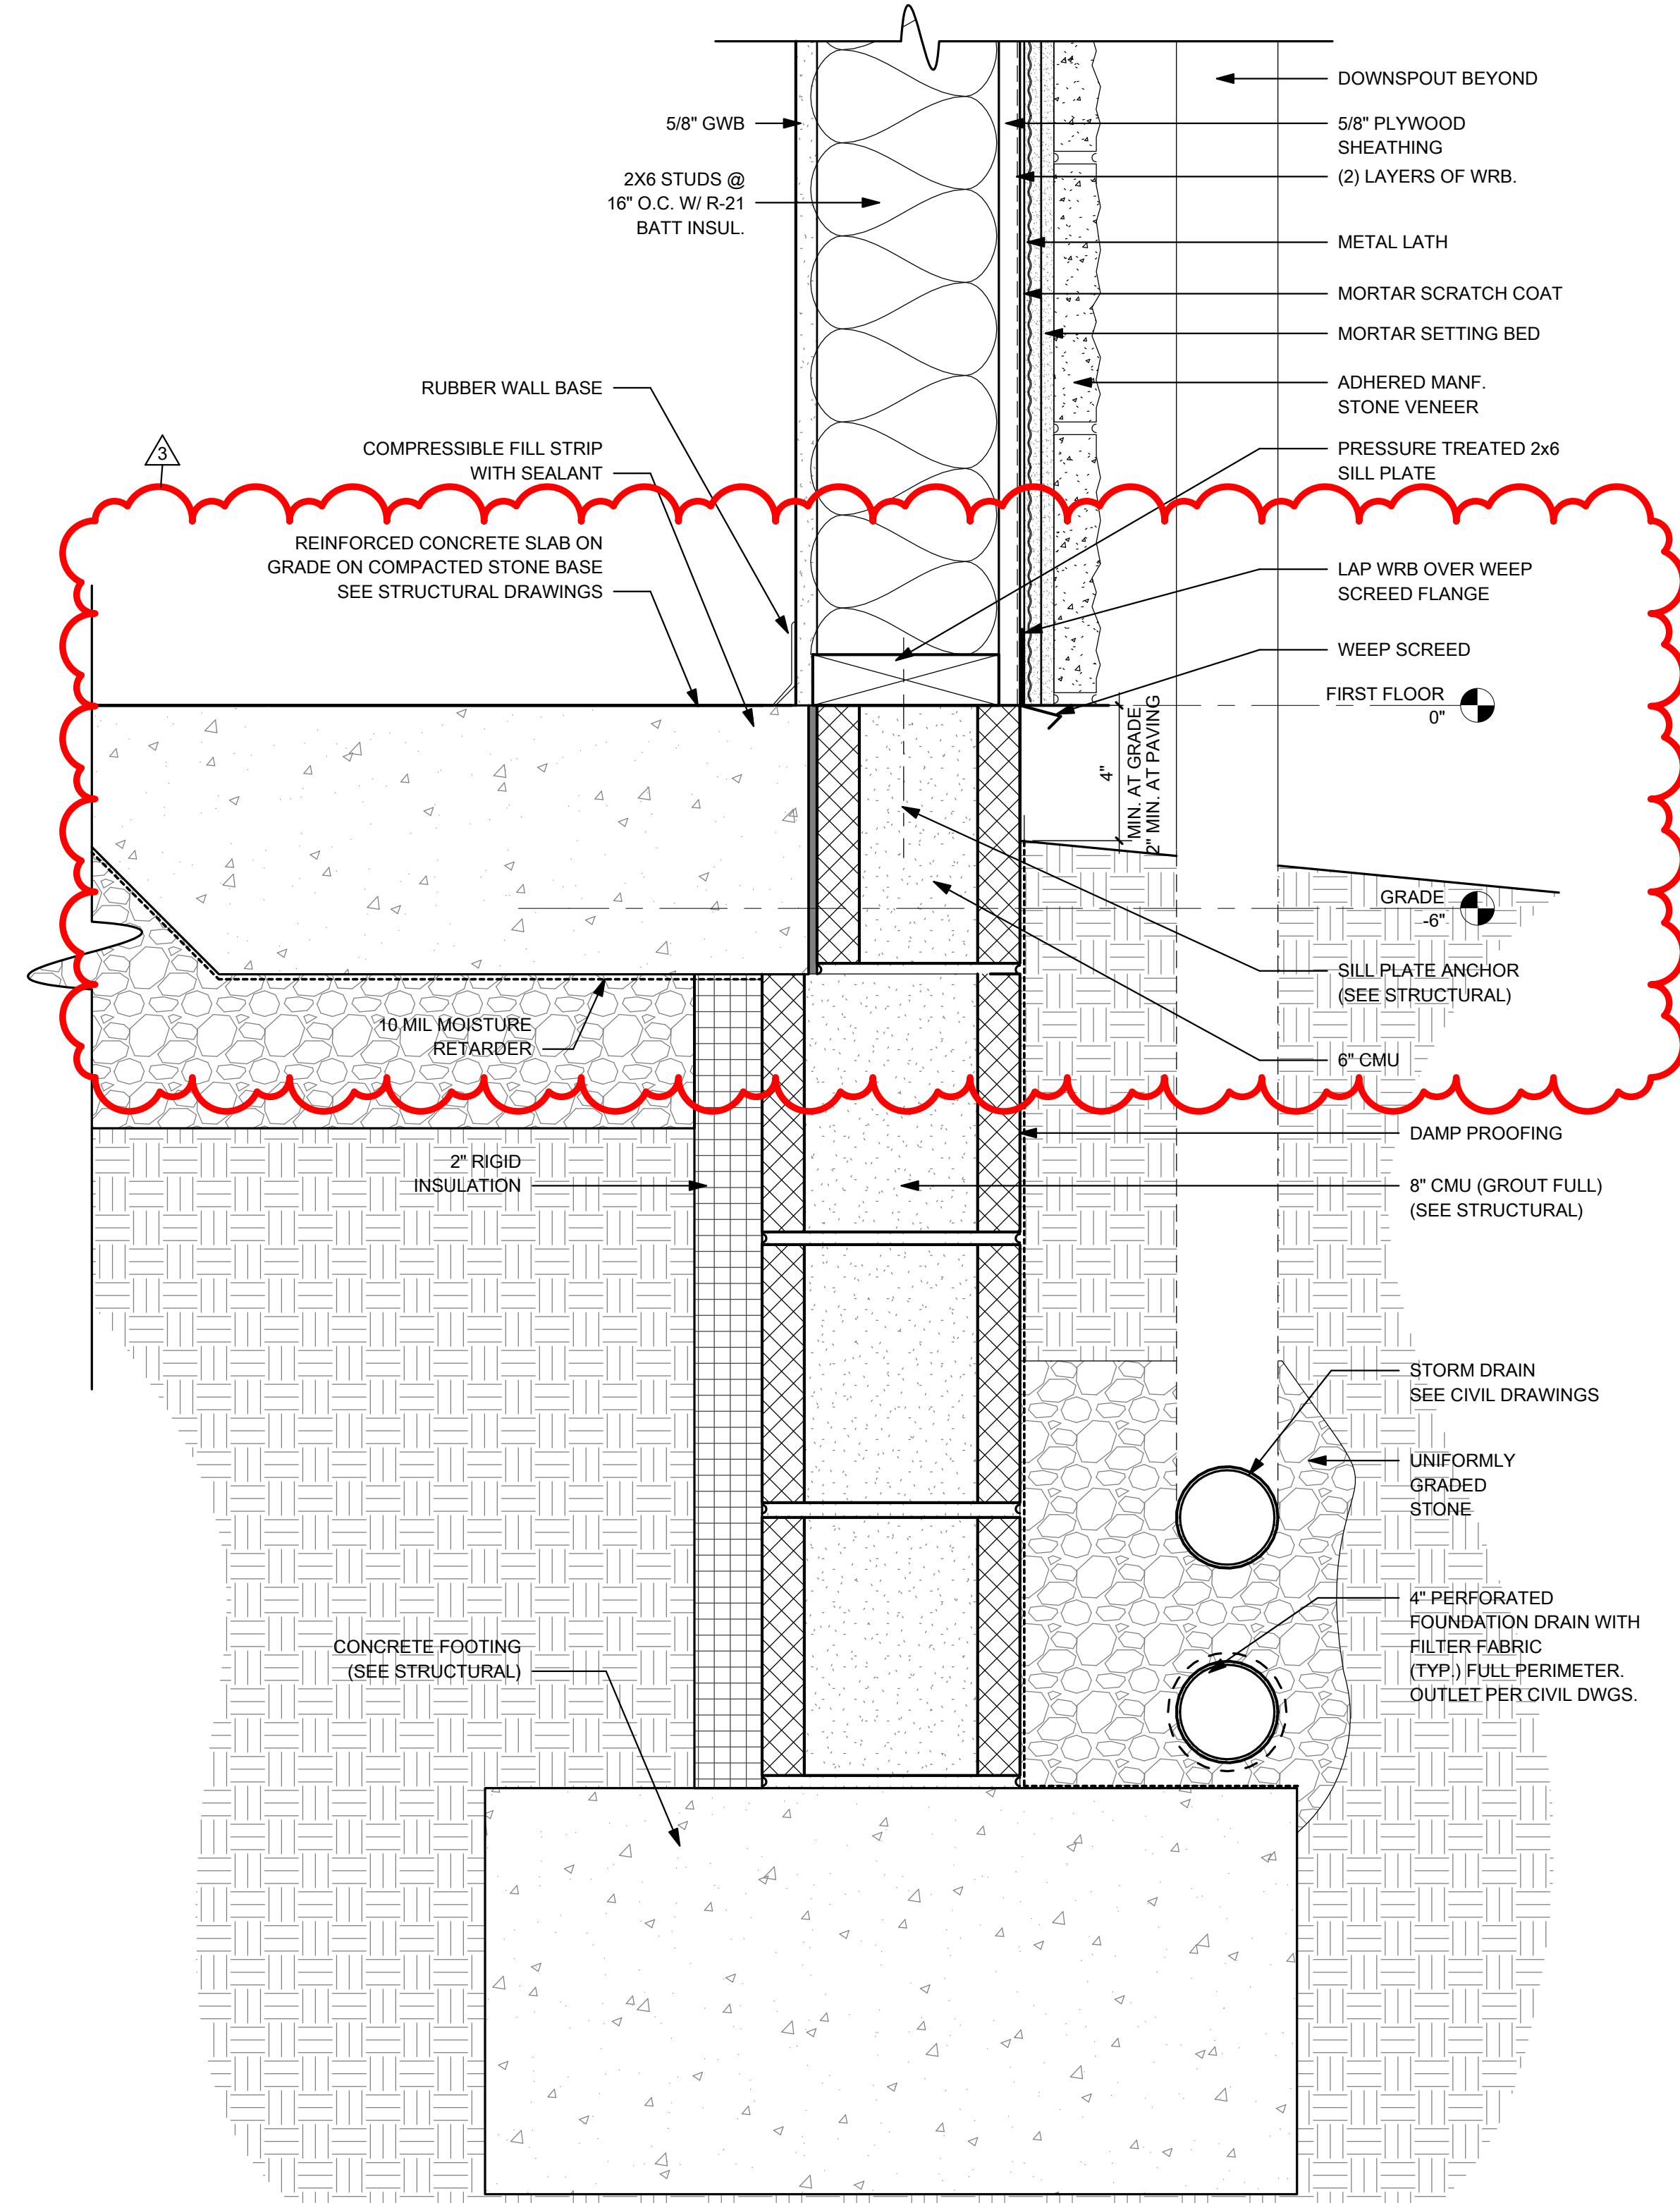

4 DETAIL - FOUNDATION @ WOOD FRAMING
A5.02(R) 3" = 1'-0"

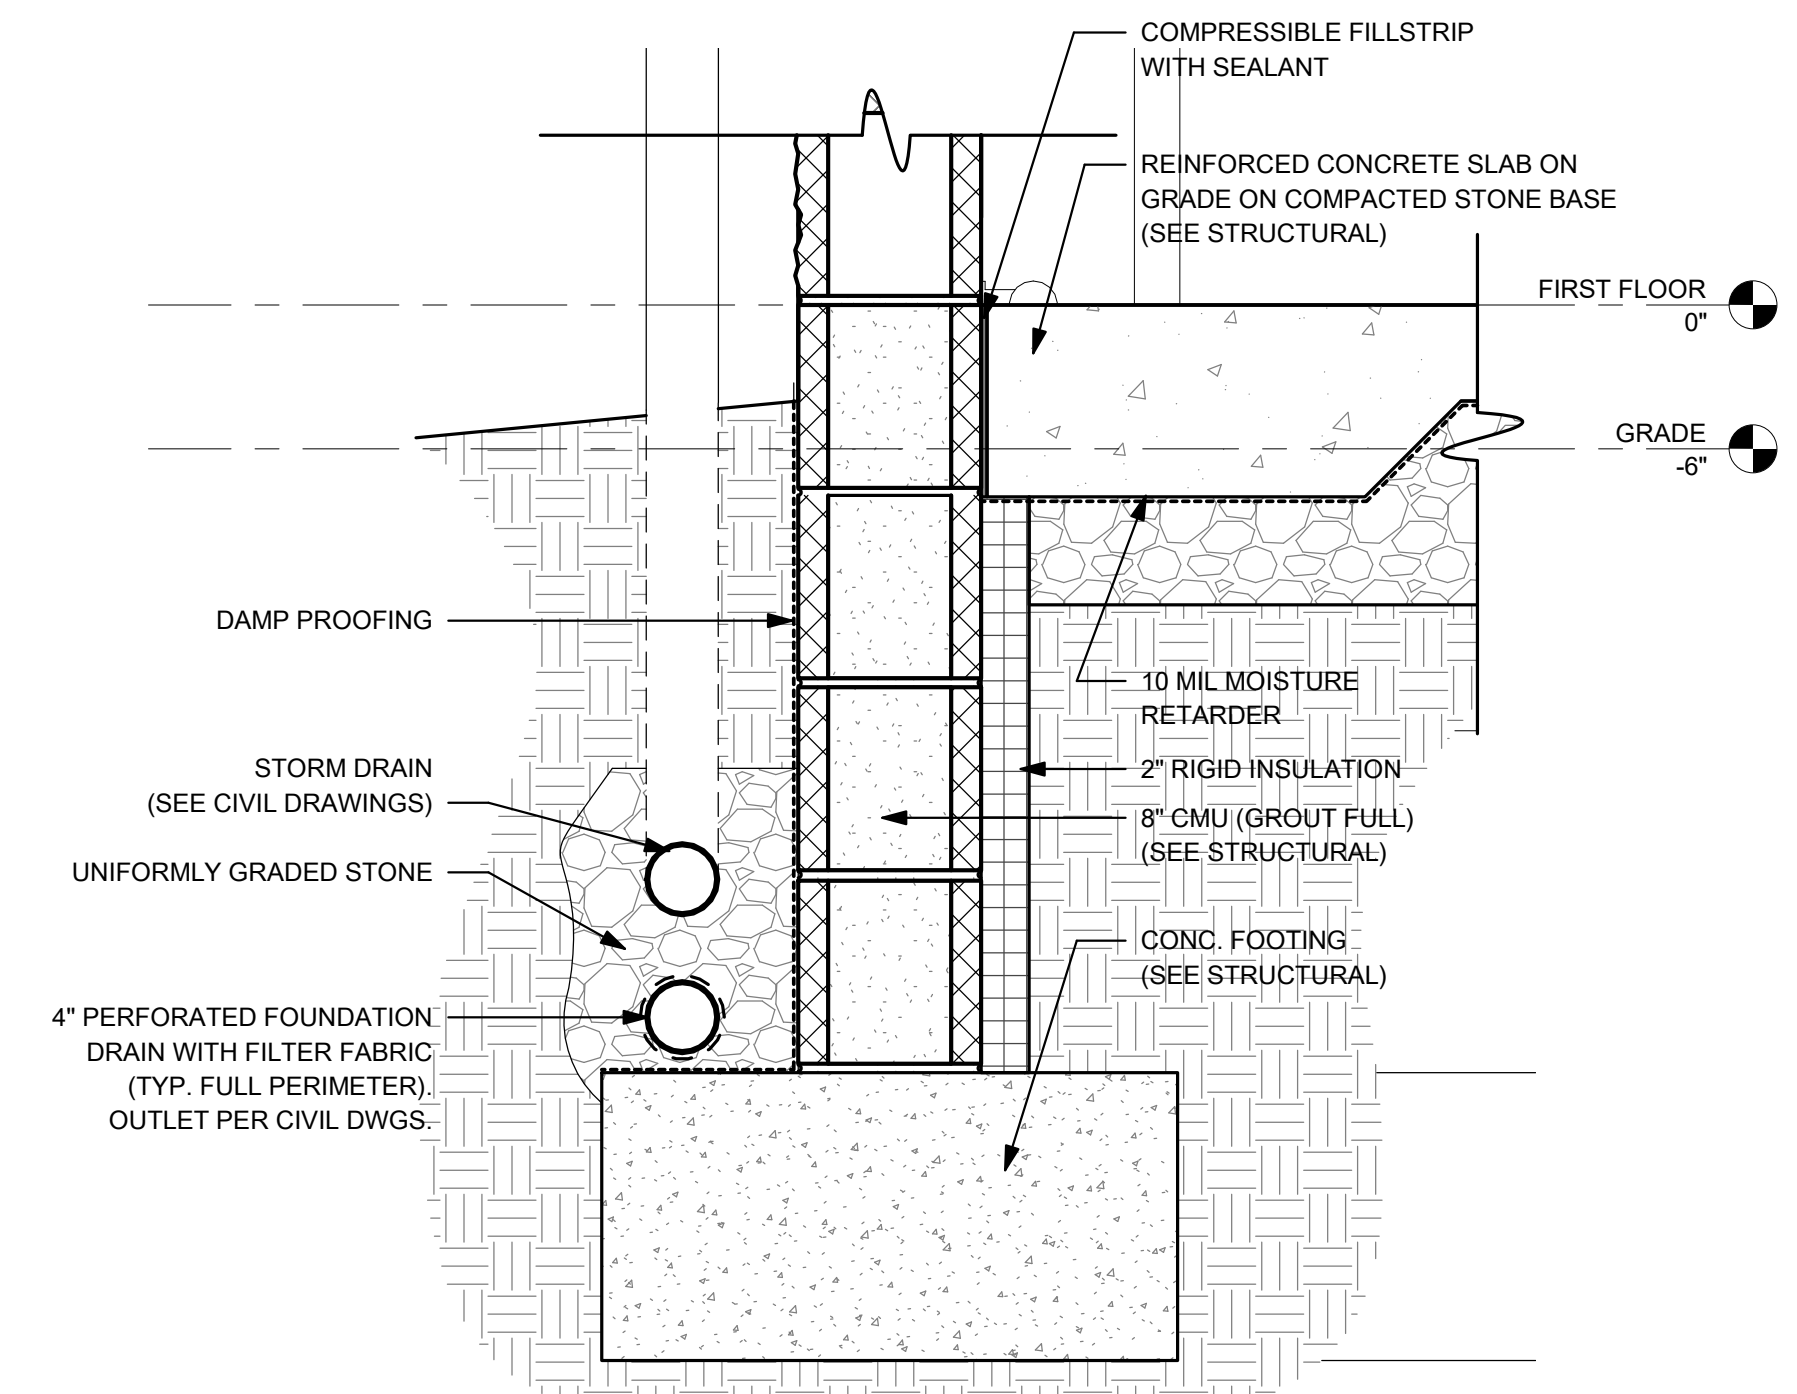

3 DETAIL - FOUNDATION @ CMU WALL
A5.02(R) 1 1/2" = 1'-0"

| NO. | DATE | BY | DESCRIPTION |
|-----|------|----|-------------|
| 3 | | | |

BROOKE COUNTY EMS
BROOKE COUNTY COMMISSION
3031 PLEASANT AVE, WELLSBURG WV 26070
FEBRUARY 24, 2023
CONSTRUCTION DOCUMENTS

DRAWN: DS DATE: 02/24/2023
CHECKED: PMF DATE: 02/24/2023


PROJECT No. T60-11009.00

WALL DETAILS


SHEET No.

A5.02(R)


THE INFORMATION CONTAINED HEREIN IS THE SOLE PROPERTY OF THE THRASHER GROUP, INC. REPRODUCTION OF THESE DOCUMENTS IN WHOLE, OR IN PART FOR ANY REASON WITHOUT PRIOR WRITTEN PERMISSION IS STRICTLY PROHIBITED. COPYRIGHT © 2021 THE THRASHER GROUP, INC.

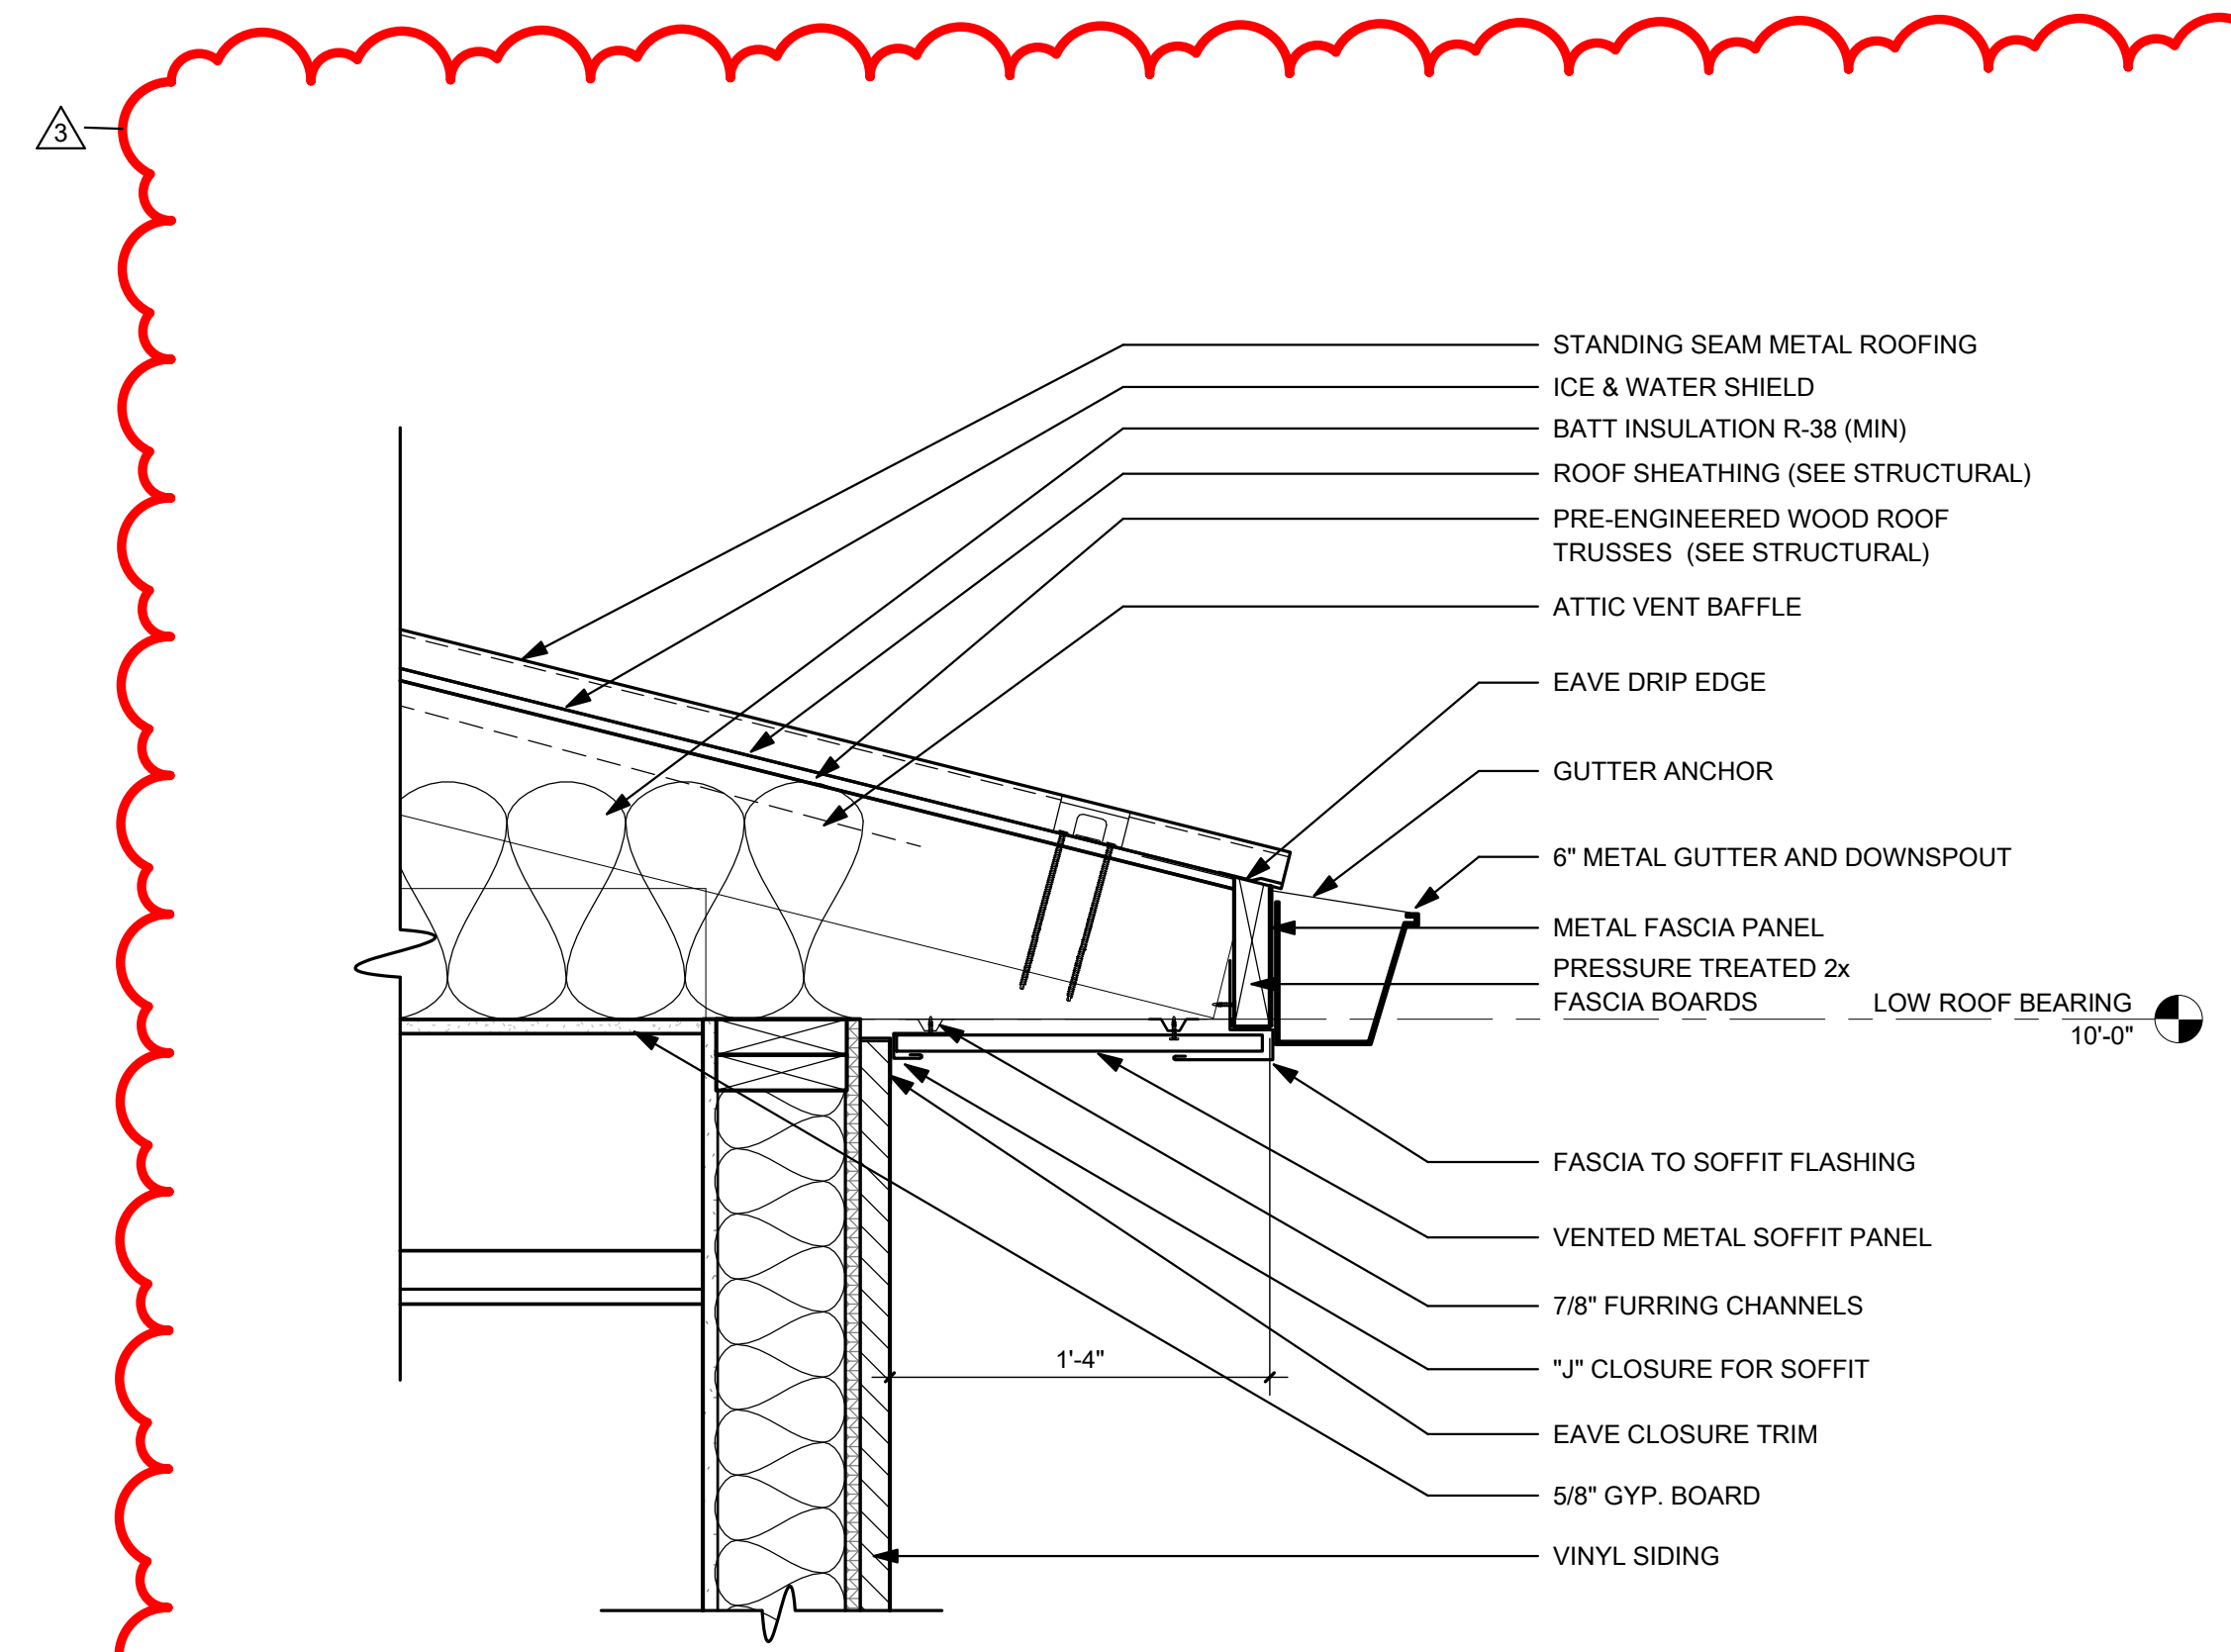


1 DETAIL - ROOF EAVE @ ADMINISTRATION (TYP.)
 A5.03(R) 1 1/2" = 1'-0"

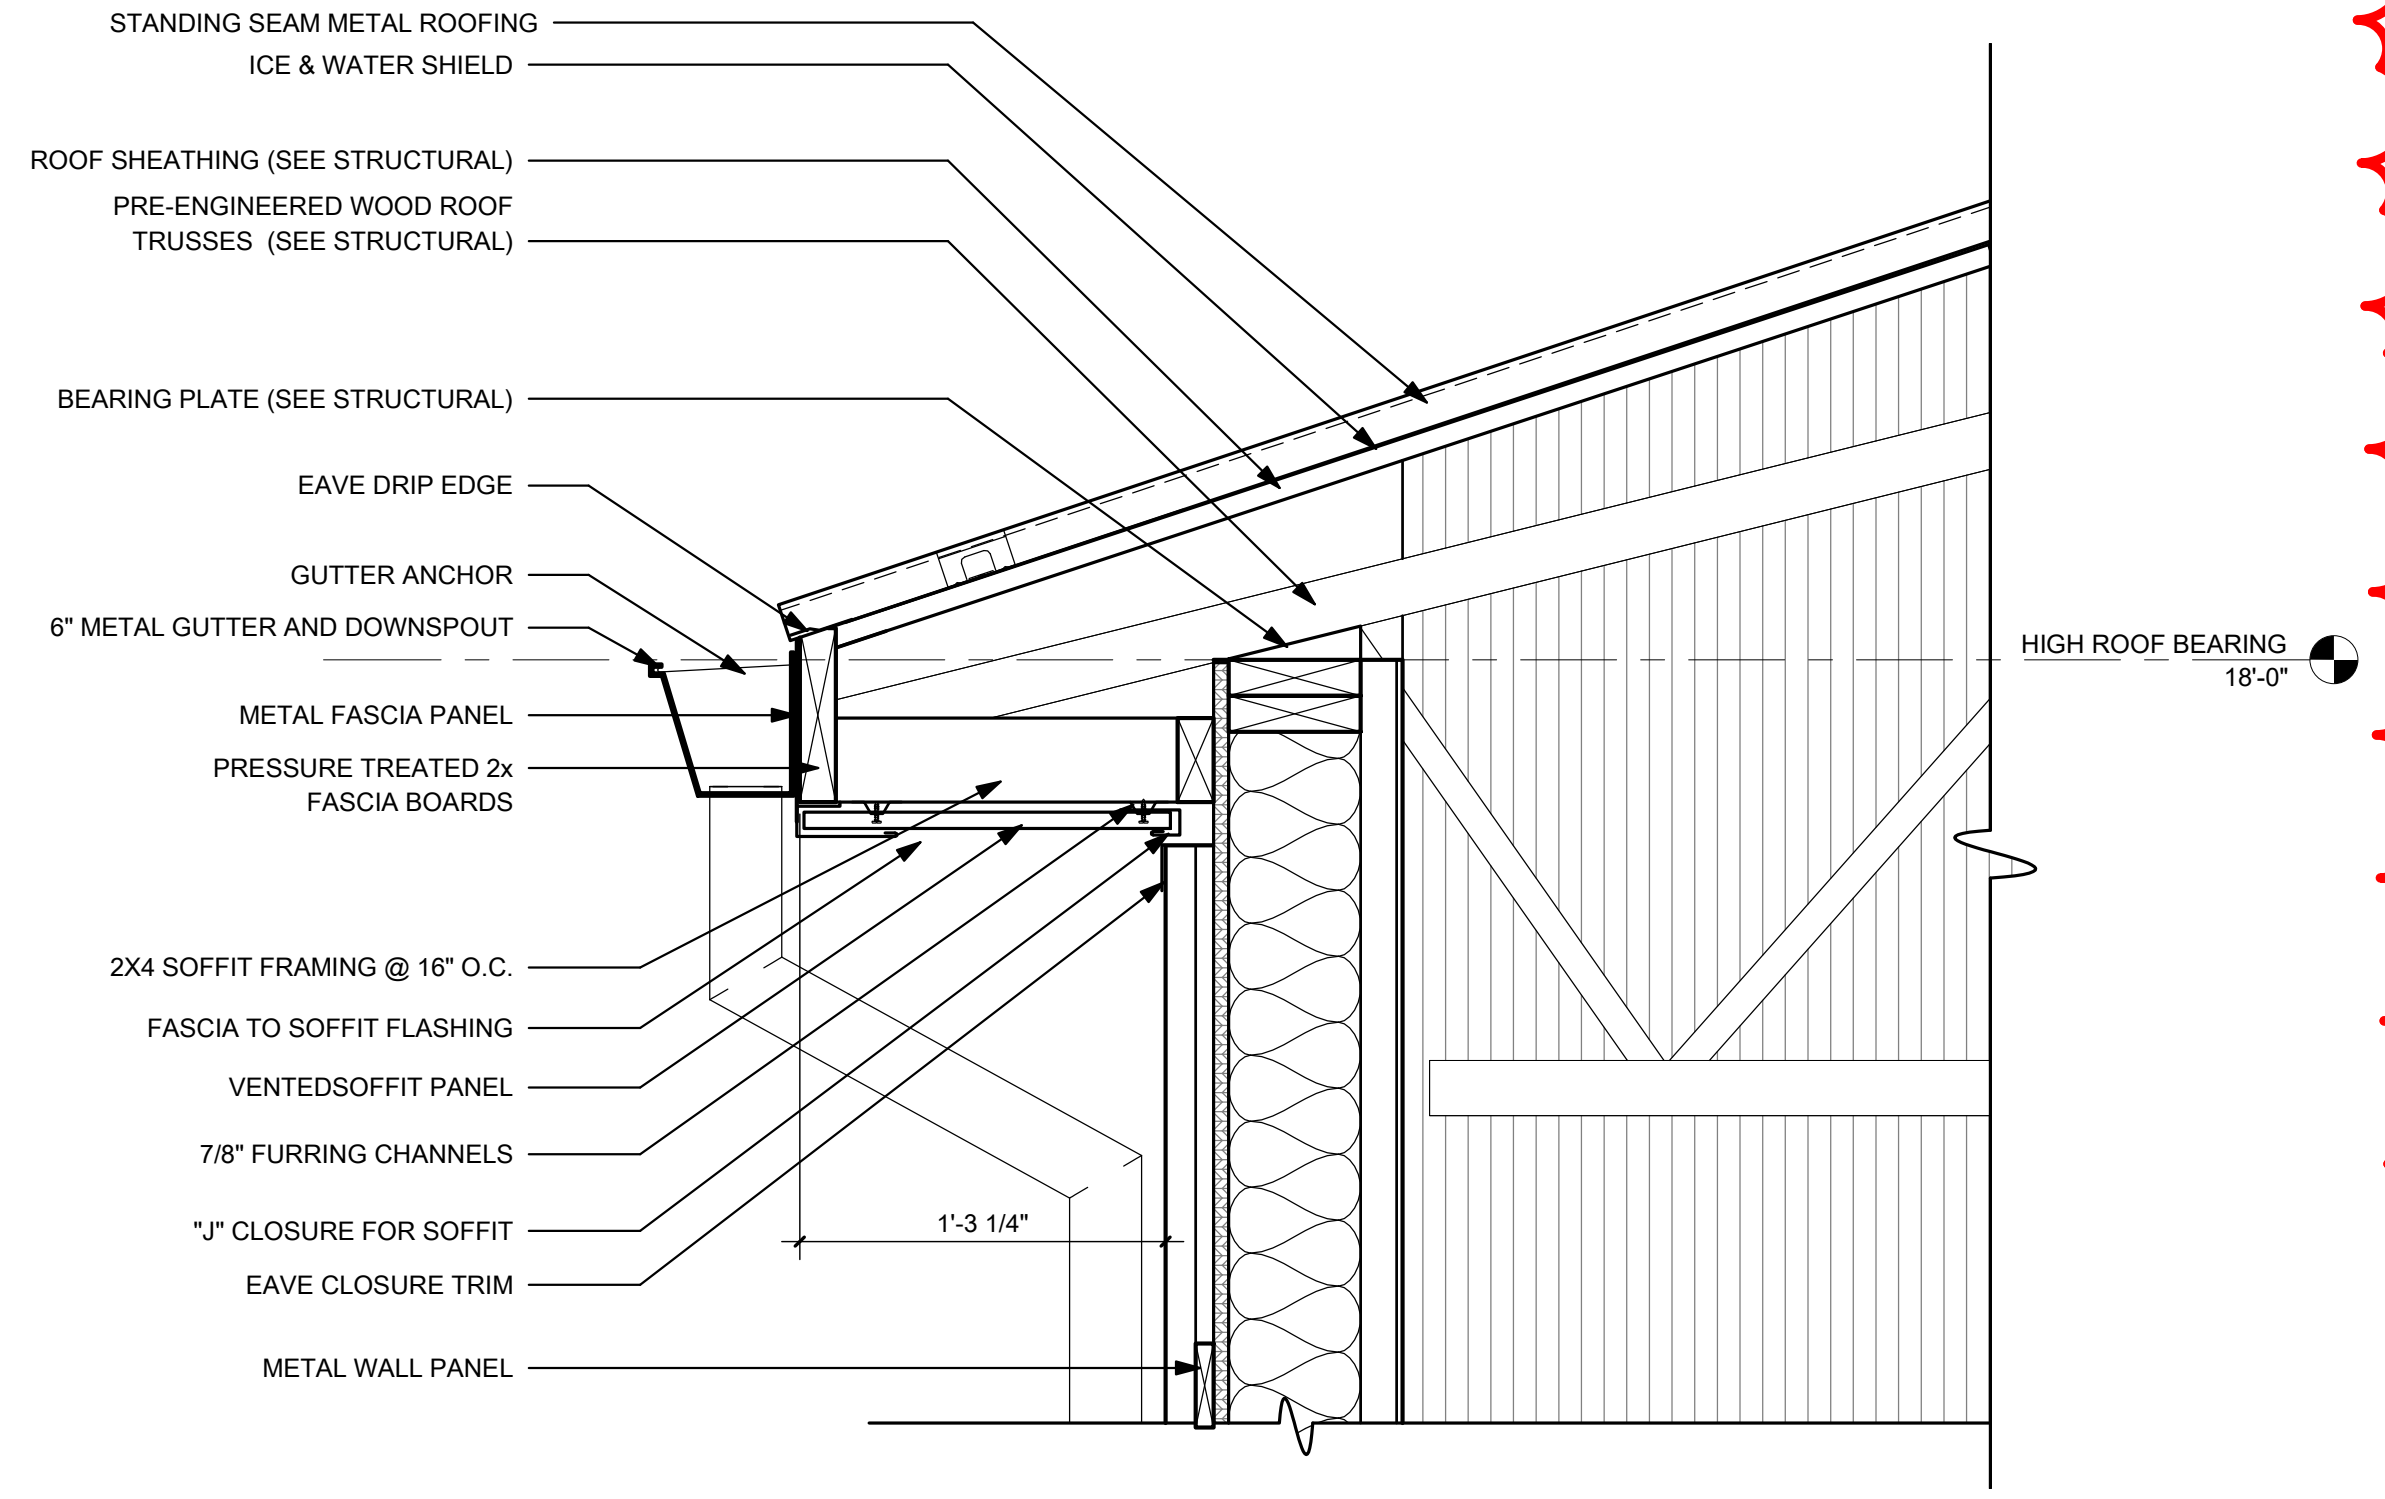


2 DETAIL - ROOF EAVE @ GARAGE (TYP.)
 A5.03(R) 1 1/2" = 1'-0"

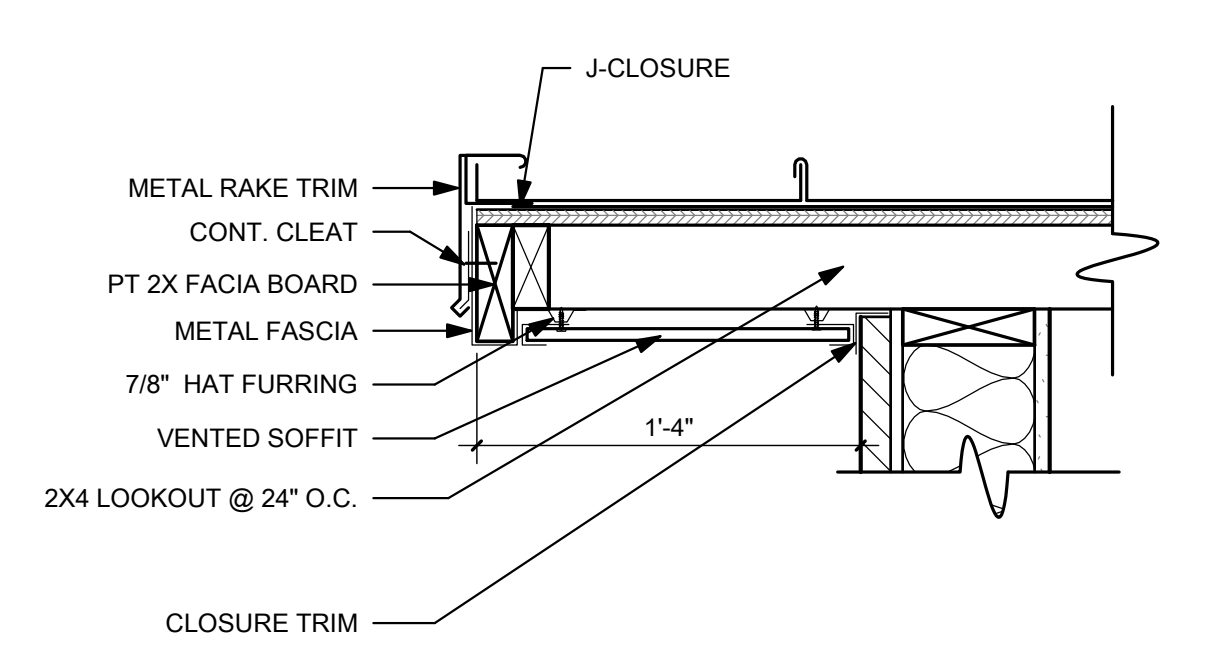


3 DETAIL - RAKE @ METAL PANEL
 A5.03(R) 1 1/2" = 1'-0"

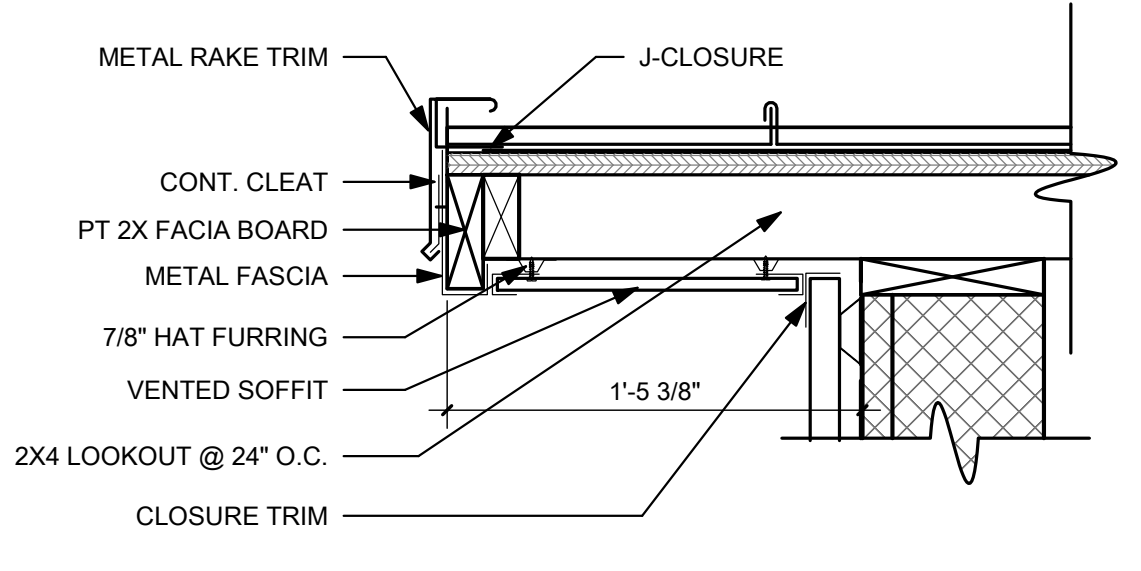

4 DETAIL - RAKE @ CMU
 A5.03(R) 1 1/2" = 1'-0"

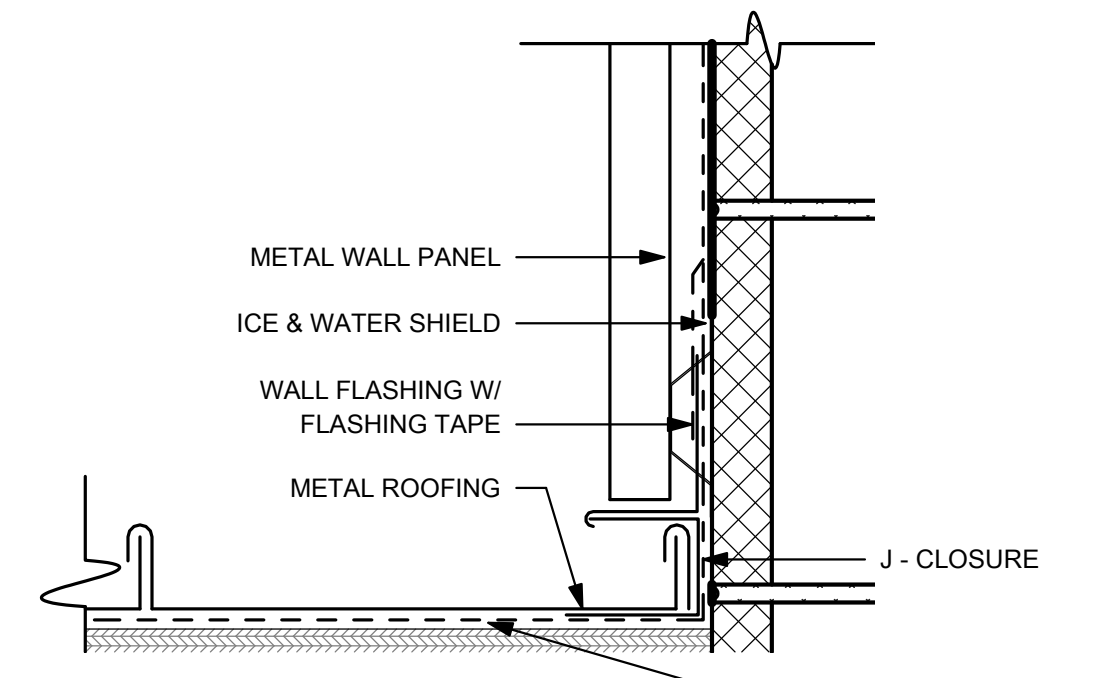

5 DETAIL - ROOF/WALL
 A5.03(R) 3" = 1'-0"

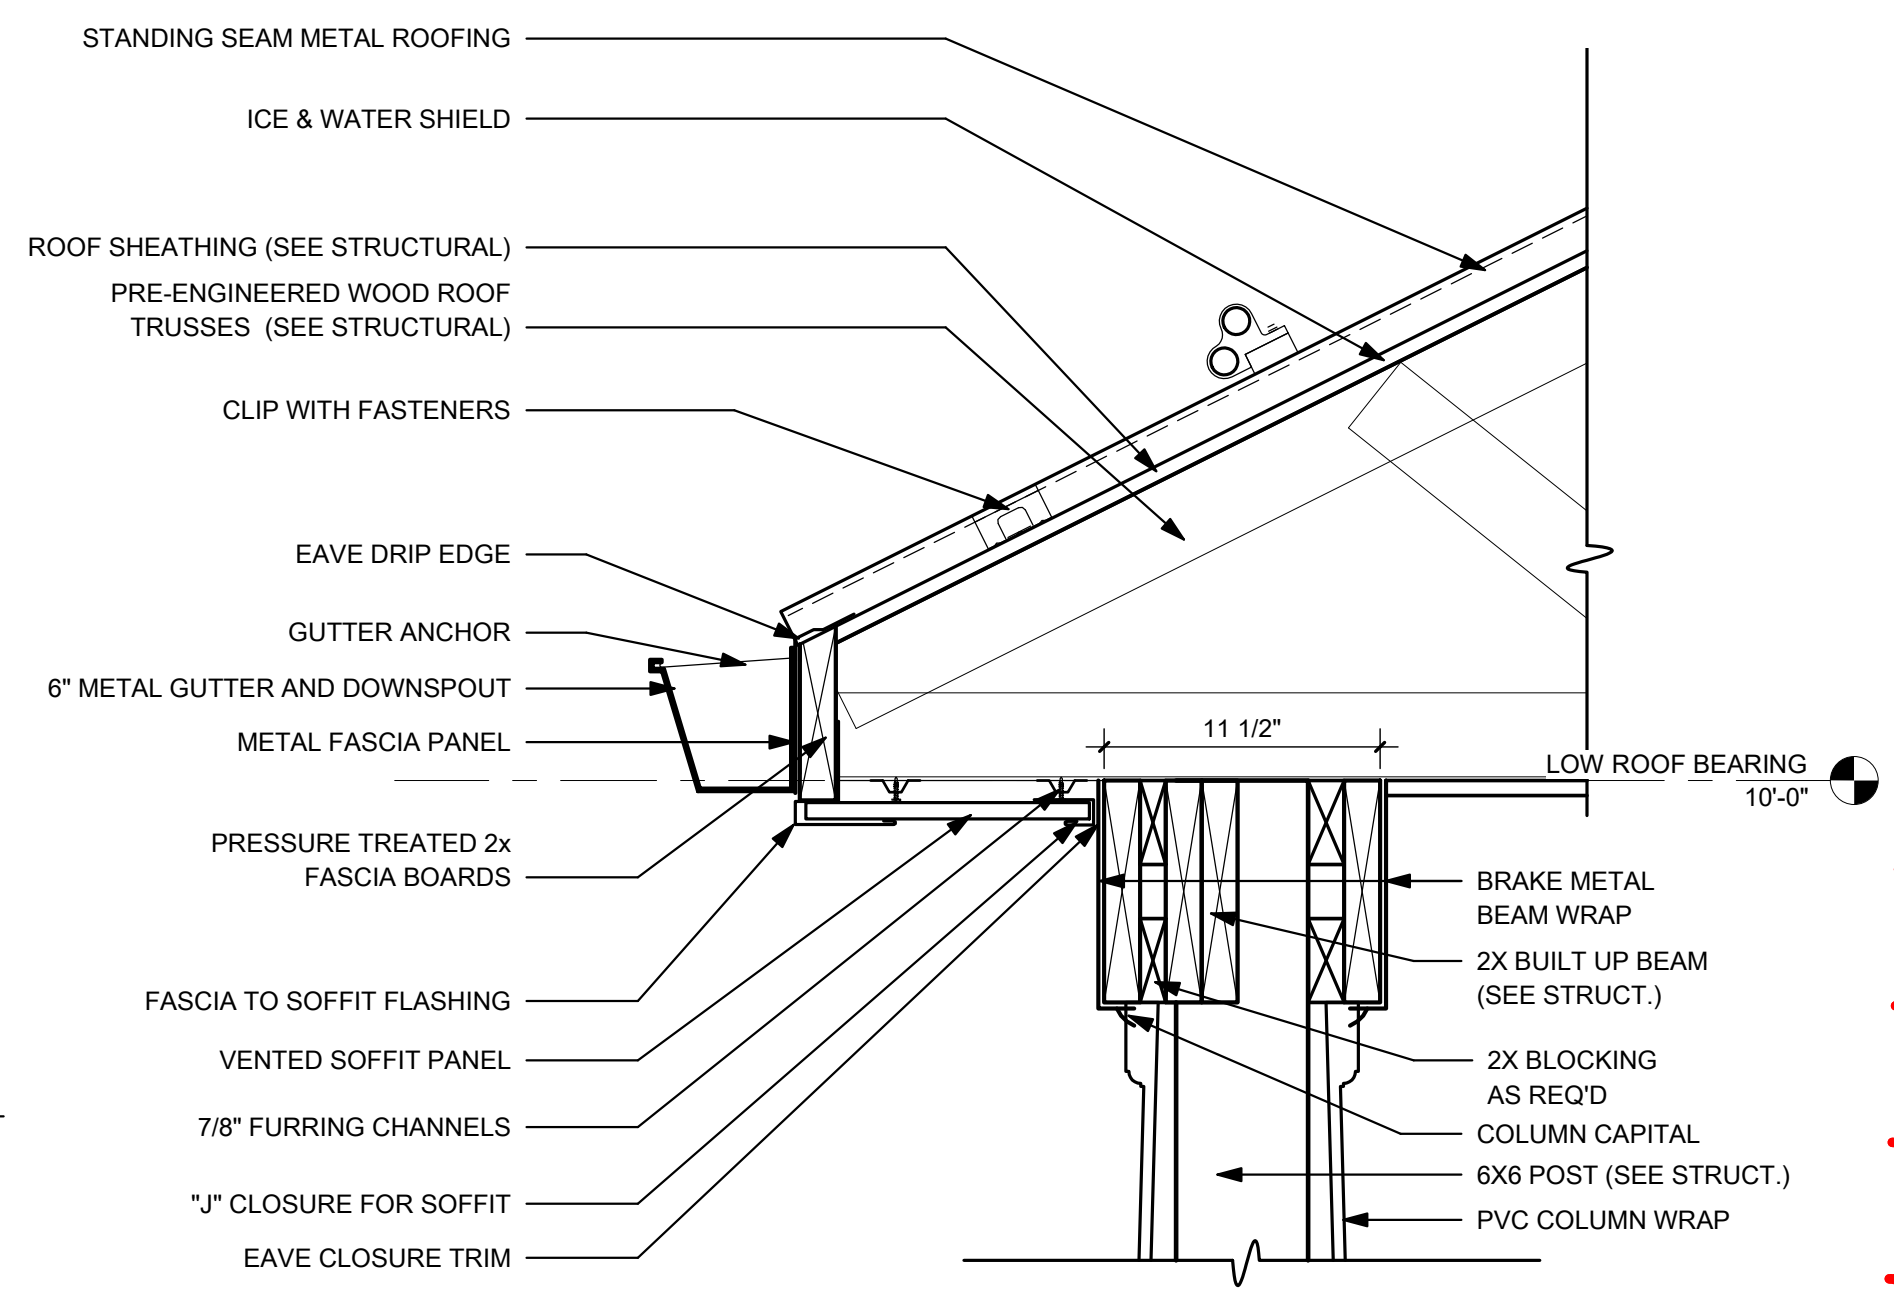

6 DETAIL - COLUMN @ PORCH
 A5.03(R) 1 1/2" = 1'-0"

| NO. | BY | DATE | DESCRIPTION |
|-----|----|------|-------------|
| 3 | | | |

BROOKE COUNTY EMS
 BROOKE COUNTY COMMISSION
 3031 PLEASANT AVE, WELLSBURG WV 26070
 FEBRUARY 24, 2023
 CONSTRUCTION DOCUMENTS

DRAWN: DS DATE: 02/24/2023
 CHECKED: PMF DATE: 02/24/2023

PROJECT No. T60-11009.00

ROOF DETAILS


SHEET No.

A5.03(R)


LAYOUT TAB: ROOF DETAILS
 CAD FILE: R:\0001761-11009-00-Brooke EMS\Brooke County Commission - Design\Rev\02020302 - Brooke EMS_CD_2022.rvt
 PLOT DATE/TIME: 4/4/2023 10:05:08 AM
 USER: DS

DOOR, FRAME, & HARDWARE SCHEDULE


| # | DOOR | | | | FRAME | | | | ASSEMBLY | | REMARKS | | |
|------|------|--------|--------|-----------|----------|--------|------------|----------------|--------------|-------------|---------|--------------|----------------|
| | TYPE | WIDTH | HEIGHT | THICKNESS | MATERIAL | FINISH | FRAME TYPE | FRAME MATERIAL | FRAME FINISH | FIRE RATING | | HARDWARE SET | ACCESS CONTROL |
| 101 | FG | 3'-0" | 7'-0" | 1 3/4" | ALUM | FF | SF1 | ALUM | FF | | 01 | | |
| 101B | FG | 3'-0" | 7'-0" | 1 3/4" | ALUM | FF | 1 | H.M. | P | | 02 | Yes | |
| 102 | N | 3'-0" | 7'-0" | 1 3/4" | HM | P | 1 | H.M. | P | | 15 | | |
| 103 | F | 3'-0" | 7'-0" | 1 3/4" | HM | P | 1 | H.M. | P | | 17 | | |
| 104 | F | 3'-0" | 7'-0" | 1 3/4" | HM | P | 1 | H.M. | P | | 17 | | |
| 105 | F | 3'-0" | 7'-0" | 1 3/4" | HM | P | 1 | H.M. | P | | 12 | | |
| 106 | N | 3'-0" | 7'-0" | 1 3/4" | HM | P | 1 | H.M. | P | | 15 | | |
| 107 | N | 3'-0" | 7'-0" | 1 3/4" | HM | P | 1 | H.M. | P | | 14 | | |
| 108 | F | 3'-0" | 7'-0" | 1 3/4" | HM | P | 1 | H.M. | P | | 05 | | |
| 109 | F | 3'-0" | 7'-0" | 1 3/4" | HM | P | 1 | H.M. | P | | 06 | | |
| 110 | F | 3'-0" | 7'-0" | 1 3/4" | HM | P | 1 | H.M. | P | | 17 | | |
| 111A | HG | 3'-0" | 7'-0" | 1 3/4" | HM | P | 1 | H.M. | P | | 07 | | |
| 111B | HG | 3'-0" | 6'-8" | 1 3/4" | HM | P | 1 | H.M. | P | | 03 | | |
| 112 | F | 3'-0" | 7'-0" | 1 3/4" | HM | P | 1 | H.M. | P | | 11 | | |
| 113 | F | 3'-0" | 7'-0" | 1 3/4" | HM | P | 1 | H.M. | P | | 13 | | |
| 114 | F | 3'-0" | 7'-0" | 1 3/4" | HM | P | 1 | H.M. | P | | 13 | | |
| 115 | F | 3'-0" | 7'-0" | 1 3/4" | HM | P | 1 | H.M. | P | | 11 | | |
| 116 | F | 3'-0" | 7'-0" | 1 3/4" | HM | P | 1 | H.M. | P | 90 MIN | 18 | | |
| 117 | F | 3'-0" | 7'-0" | 1 3/4" | HM | P | 1 | H.M. | P | 90 MIN | 18 | | |
| 118 | F | 3'-0" | 7'-0" | 1 3/4" | HM | P | 1 | H.M. | P | 90 MIN | 18 | | |
| 119 | F | 3'-0" | 7'-0" | 1 3/4" | HM | P | 1 | H.M. | P | 90 MIN | 18 | | |
| 120 | HG | 3'-0" | 7'-0" | 1 3/4" | HM | P | 1 | H.M. | P | | 10 | Yes | |
| 121A | F | 3'-0" | 7'-0" | 1 3/4" | HM | P | 2 | H.M. | P | 90 MIN | 08 | | |
| 121B | F | 3'-0" | 7'-0" | 1 3/4" | HM | P | 2 | H.M. | P | 90 MIN | 09 | | |
| 121C | HG | 3'-0" | 7'-0" | 1 3/4" | HM | P | 1 | H.M. | P | | 10 | Yes | |
| 121D | OH | 12'-0" | 12'-0" | 1 3/8" | STL | FF | | | | | 16 | | |
| 121E | OH | 12'-0" | 12'-0" | 1 3/8" | STL | FF | | | | | 16 | | |
| 121F | OH | 12'-0" | 12'-0" | 1 3/8" | STL | FF | | | | | 16 | | |
| 121G | OH | 12'-0" | 12'-0" | 1 3/8" | STL | FF | | | | | 16 | | |
| 121H | OH | 12'-0" | 12'-0" | 1 3/8" | STL | FF | | | | | 16 | | |
| 121I | HG | 3'-0" | 7'-0" | 1 3/4" | HM | P | 1 | H.M. | P | | 10 | Yes | |
| 122 | F | 3'-0" | 7'-0" | 1 3/4" | HM | P | 2 | H.M. | P | | 17 | | |
| 123 | F | 3'-0" | 7'-0" | 1 3/4" | HM | P | 2 | H.M. | P | | 04 | | |
| 201 | F | 3'-0" | 6'-8" | 1 3/4" | HM | P | 1 | H.M. | P | | 10 | Yes | |

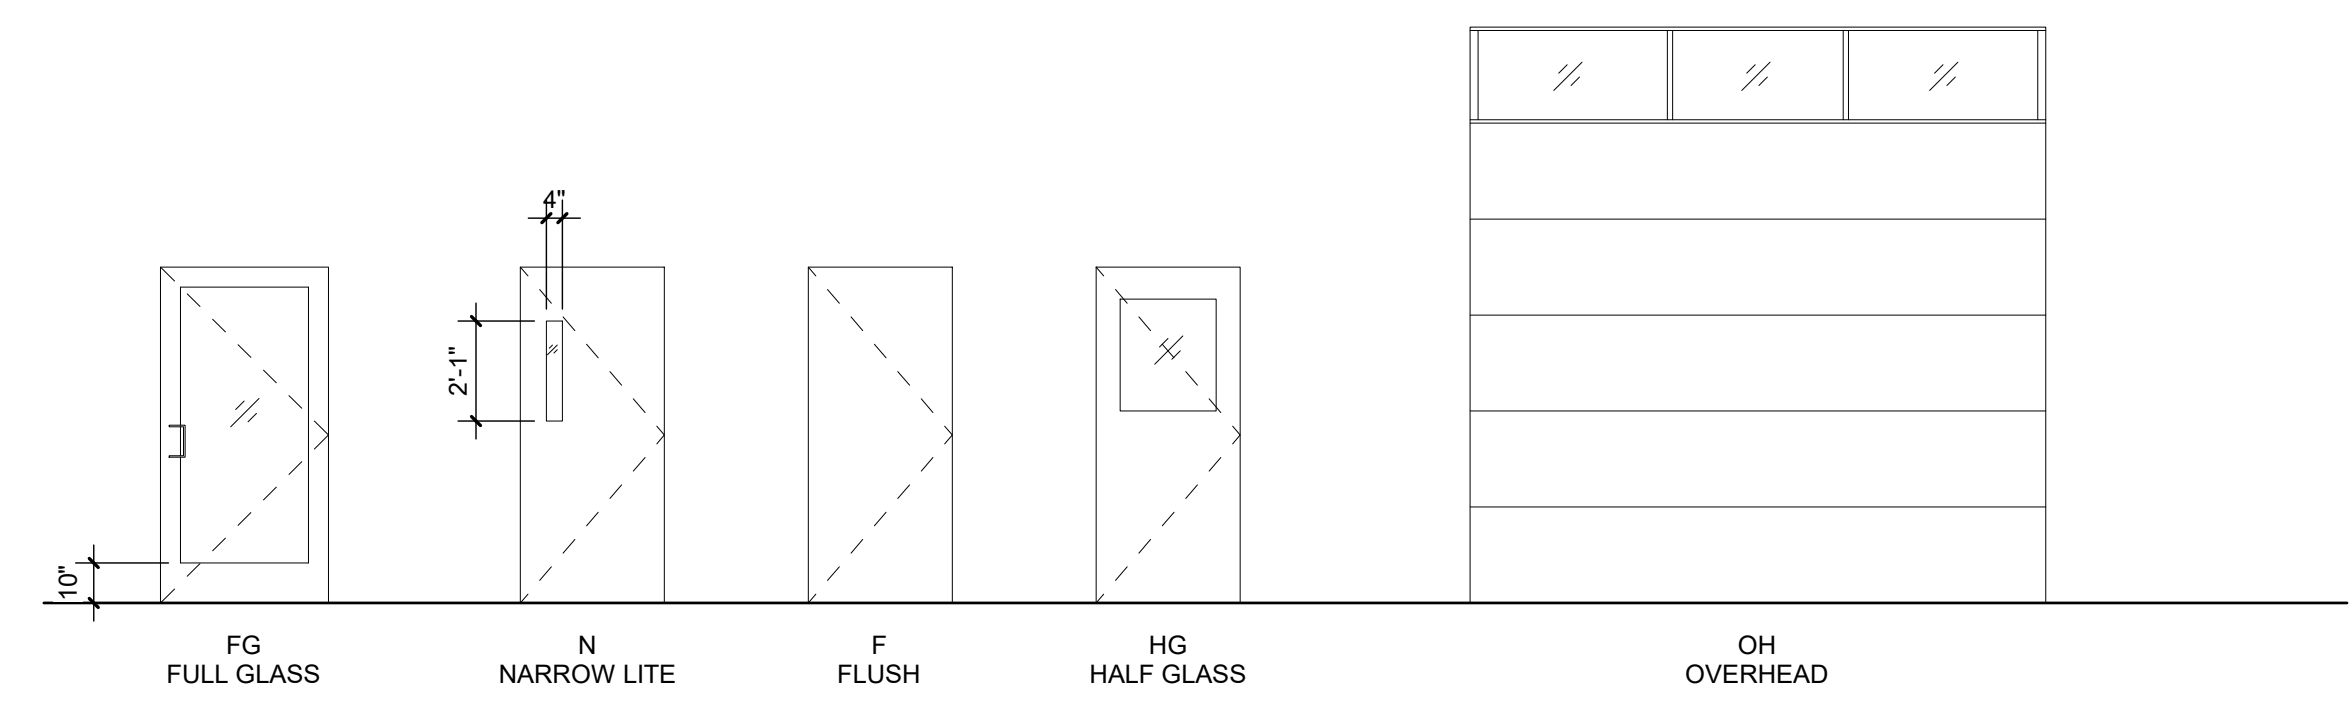

DOOR TYPE LEGEND
1/4" = 1'-0"

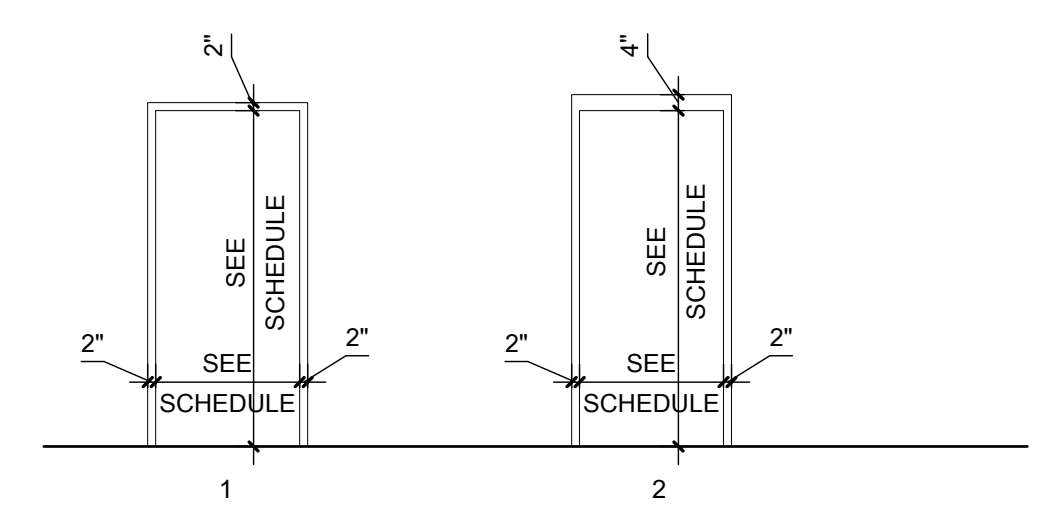

FRAME TYPE LEGEND
1/4" = 1'-0"

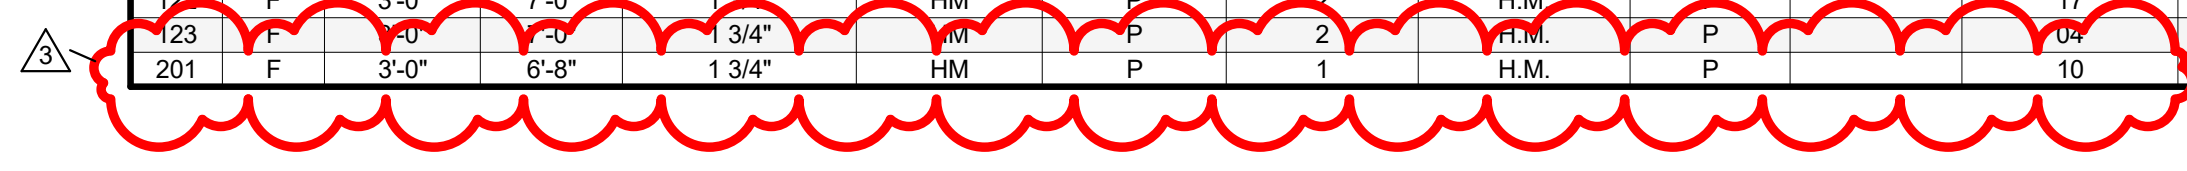

| No. | BY | DATE | DESCRIPTION |
|-----|----|------|-------------|
| 3 | | | |

BROOKE COUNTY EMS
BROOKE COUNTY COMMISSION
3031 PLEASANT AVE, WELLSBURG WV 26070
FEBRUARY 24, 2023
CONSTRUCTION DOCUMENTS

DRAWN: DS DATE: 02/24/2023
CHECKED: PMF DATE: 02/24/2023

PROJECT No. T66-11009.00

SCHEDULES & DIAGRAMS

SHEET No.

A6.01(R)

THE INFORMATION CONTAINED HEREIN IS THE SOLE PROPERTY OF THE THRASHER GROUP, INC. REPRODUCTION OF THESE DOCUMENTS IN WHOLE, OR IN PART FOR ANY REASON WITHOUT PRIOR WRITTEN PERMISSION IS STRICTLY PROHIBITED. COPYRIGHT © 2022 THE THRASHER GROUP, INC.




NOTE:
 1) SEE SITE PLAN ELECTRICAL (E-SITE) FOR PARKING LOT LIGHT POLES AND CONDUIT
 2) SEE ELECTRICAL DETAILS FOR TRANSFORMER PAD

| Inlet Name | Inlet Details | Inlet Center Location |
|------------|--|---------------------------------|
| 1-5 | RIM = 692.93' 12" INV IN = 690.38' | N:655327.4849 E:1659404.6633 |
| 1-4 | RIM = 693.38' 12" INV IN = 690.65' 12" INV OUT = 690.55' | N:655314.4948 E:1659434.5829 |
| 1-2 | RIM = 694.02' 12" INV IN = 691.30' 12" INV OUT = 691.20' | N:655227.0688 E:1659449.7744 |
| 1-1 | RIM = 694.05' 12" INV OUT = 691.50' | N:655186.6292 E:1659451.9642 |
| 1-3 | RIM = 694.14' 12" INV IN = 691.03' 12" INV OUT = 690.93' | N:655257.3533 E:1659436.2111 |

| Inlet Name | Inlet Details | Inlet Center Location |
|------------|---|---------------------------------|
| EX-1 | RIM = 694.13' 6" INV IN = 690.30' 8" INV OUT = 677.94' | N:655115.3997 E:1659417.9969 |
| S-1 | RIM = 694.18' 4" INV IN = 690.54' 4" INV IN = 690.54' 6" INV OUT = 690.44' | N:655120.7166 E:1659413.1250 |
| S-2 | RIM = 693.88' 4" INV IN = 691.50' 4" INV OUT = 691.50' | N:655171.9278 E:1659401.9636 |
| S-3 | RIM = 693.88' 4" INV IN = 691.50' 4" INV OUT = 691.50' | N:655171.8544 E:1659400.4000 |
| S-4 | RIM = 694.02' 4" INV IN = 691.07' 4" INV OUT = 690.97' | N:655129.5331 E:1659403.3973 |


CAD FILE: R:\060\T60-11009.00-Brooke EMS-Brooke County Commission-Drawing\Civil\11009-SITE PLAN.dwg
 PLOT DATE/TIME: 4/4/2023 10:45 AM
 LAYOUT: C2.01-SITE PLAN
 USER: bruce deproot

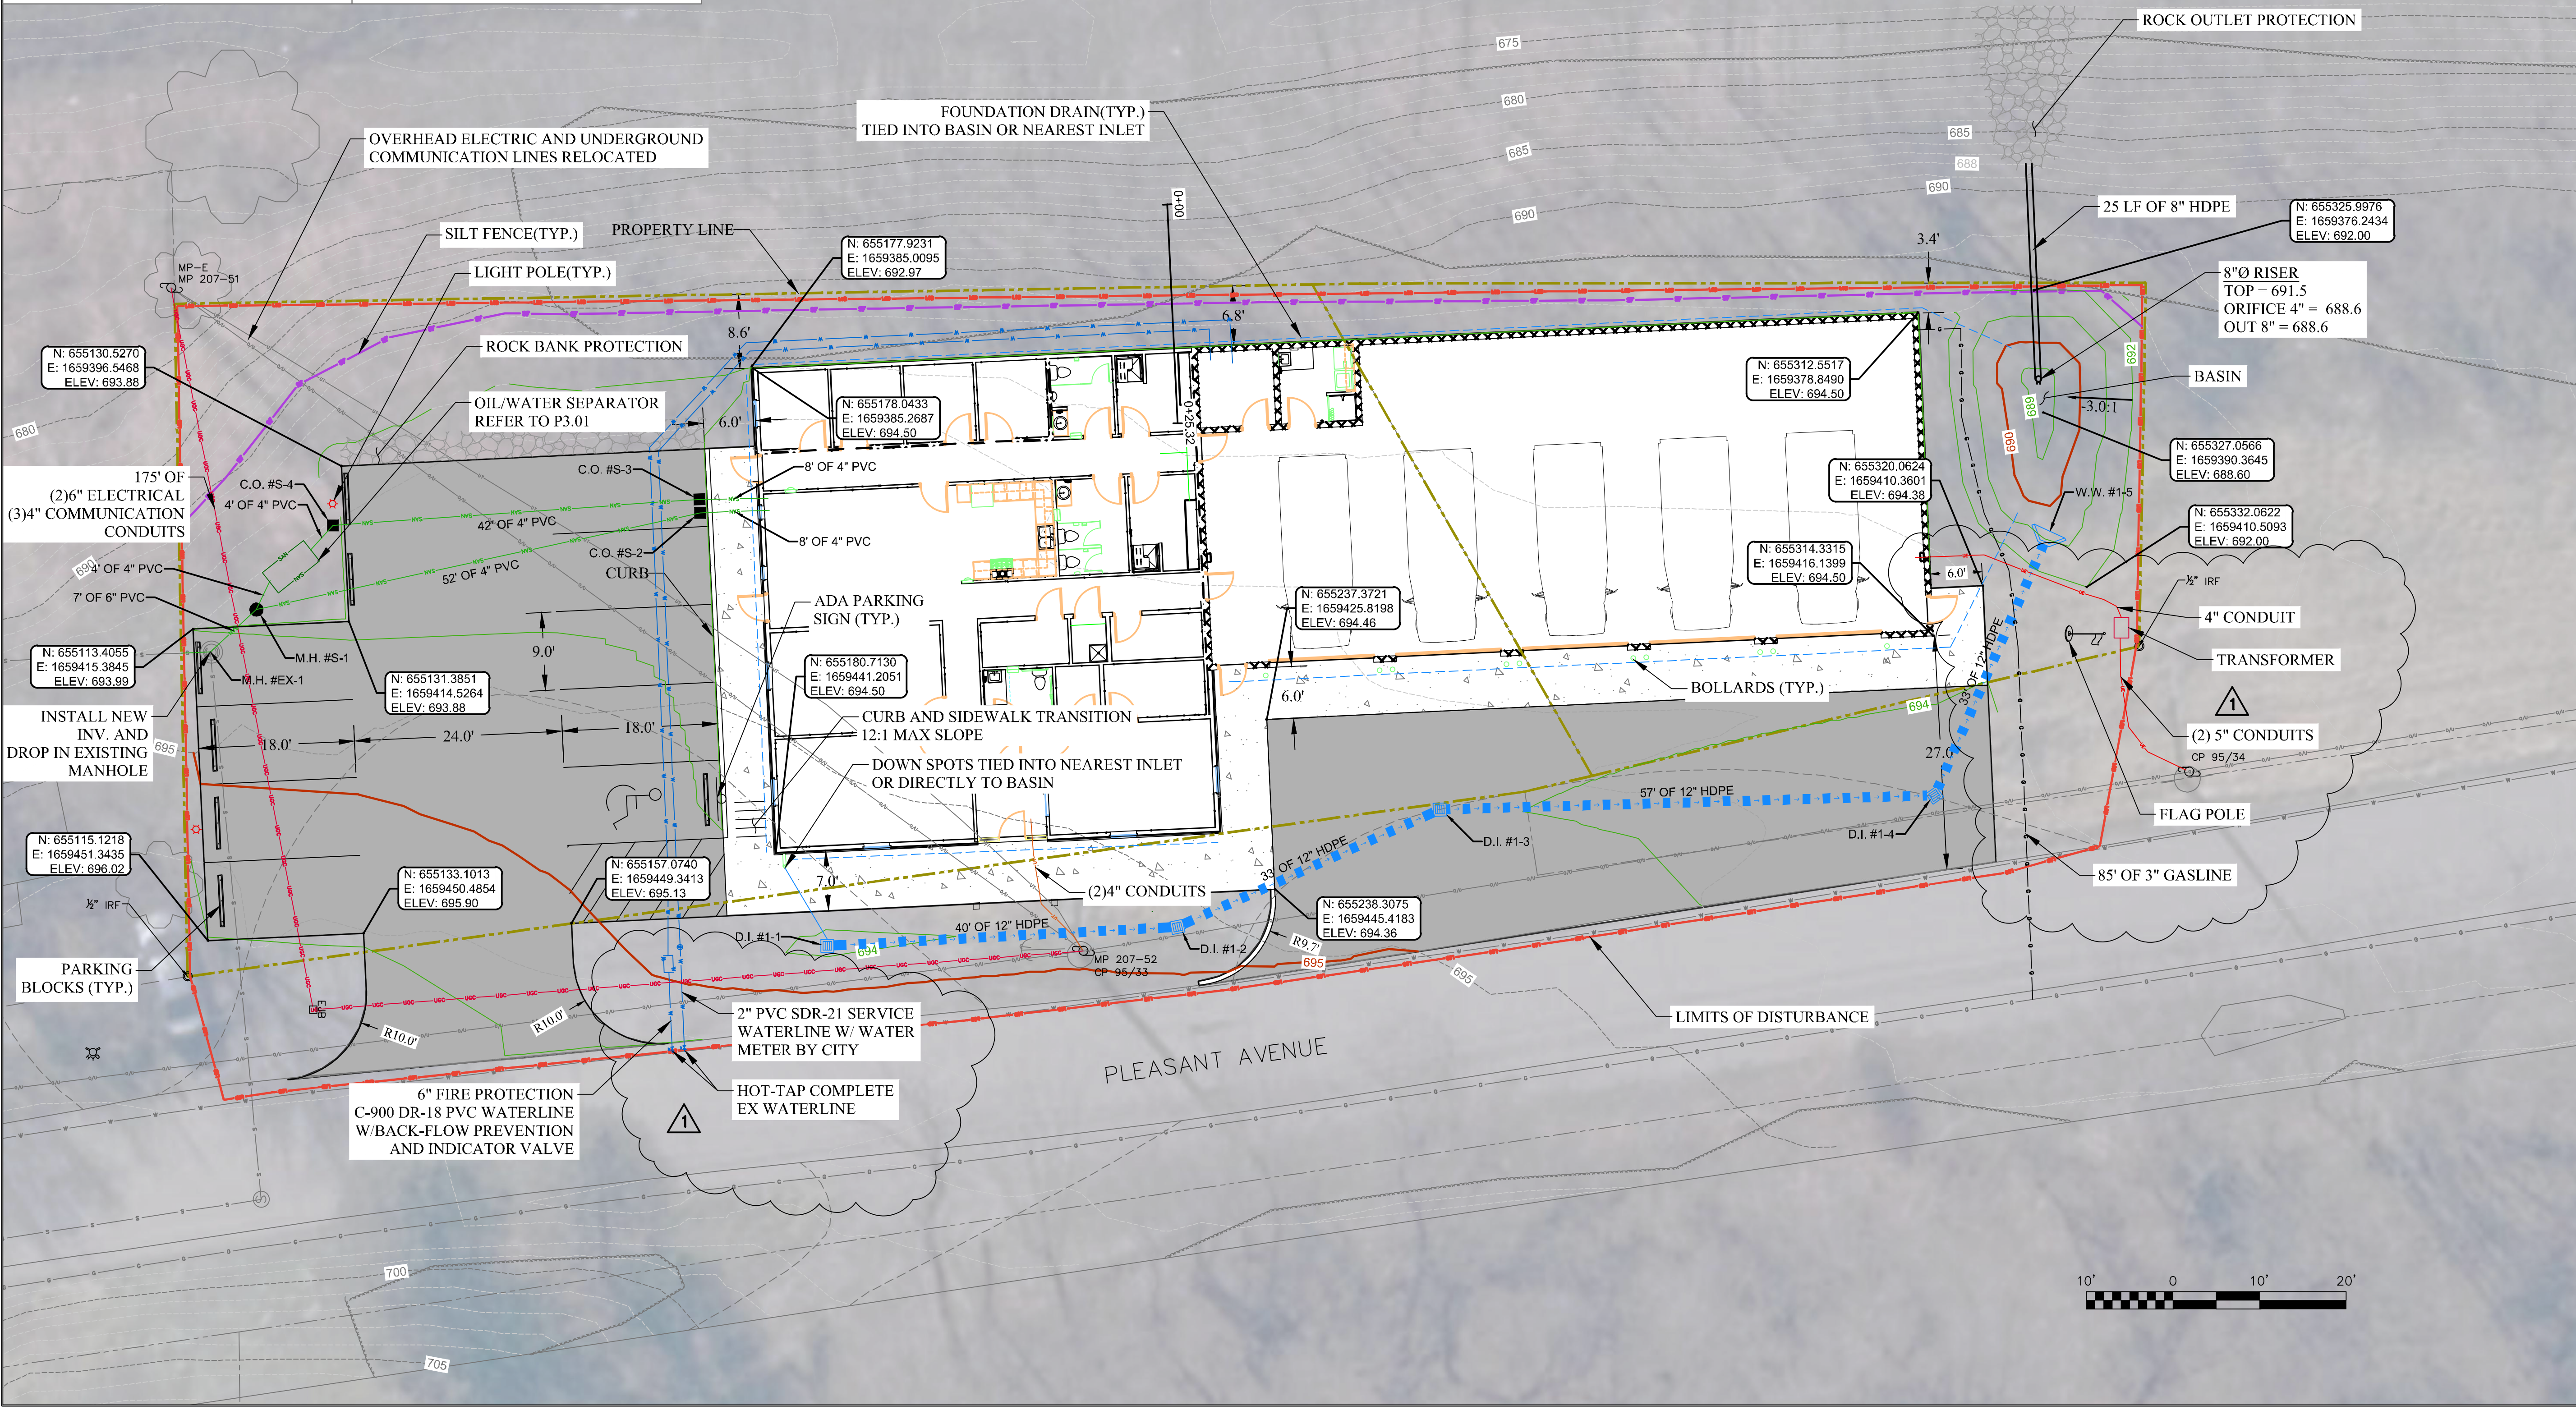

| NO. | DATE | DESCRIPTION |
|-----|----------|--|
| 1 | 4-4-2023 | ELECTRIC LOCATION AND WATERLINE TYPE CHANGES |

BROOKE COUNTY EMS
 BROOKE COUNTY COMMISSION
 3031 PLEASANT AVE., WELLSBURG, WV 26070
 02/24/2023
 CONSTRUCTION DOCUMENTS

DRAWN: DATE:
 CHECKED: DATE:
 APPROVED: DATE:
 PROJECT No. T60-11009
 SHEET No. **C2.01 R**

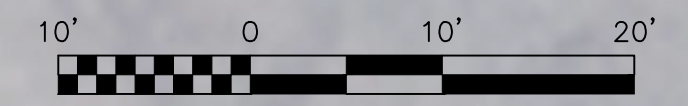

General Notes:

- 1. Design Code: International Building Code, 2018 Edition.
2. No provisions have been made for future horizontal or vertical expansion.
3. General Contractor shall verify all dimensions and conditions related to existing construction, existing services, and the site.
4. Construction loads shall not exceed design live loads. Shoring and re-shoring is the responsibility of the General Contractor.
5. The project is only stable in its completed form. The requirement for any and all bracing, shoring, or temporary supports and the planning sequences requiring them is the responsibility of the contractor.

Arrow Engineering's Scope of Services:
Arrow Engineering has been engaged as the structural engineer of record for this project. All modifications to the structure outside of what is explicitly shown herein, including interpretations of things not detailed on these drawings, must be reviewed by Arrow.

Design Data:

Table with 2 columns: Wind/Risk Category and Value. Includes Basic Design Wind Speed (121 mph), Risk Category (B), Wind exposure classification (B), Internal Pressure Coefficient (+0.18), and Exterior C&C Pressure (25 psf).

Live Loads:

Table with 2 columns: Commercial/Assembly Areas and Common Spaces and Value. Includes First Floor Corridors (100 psf), Fire Escapes (100 psf), Offices (50 psf), Typical Roof (20 psf), Light Storage (20 psf), and Attic Space above Ambulance Bays (125 psf).

Snow Load Data:

Table with 2 columns: Ground Snow Load (25 psf), Flat Roof Snow Load (24 psf), Snow Exposure Factor (1.0), Thermal Factor (1.0), Snow Load Importance Factor (1.2), and Slope Factor (1.0).

Seismic Load Data:

Table with 2 columns: Risk Category and Seismic Parameters. Includes Risk Category IV, Seismic Importance Factor (1.5), Mapped Spectral Response Accel. Parameters (Ss=0.091, S1=0.047, S0.5=0.097, S0.1=0.075), Seismic Site Class (D), Seismic Design Class (A), CF Shear Walls, Structure Weight (210 kip), Response Modification Coefficient (1.0), Seismic Response Coefficient (0.022), and Seismic Procedure Used (ELFP).

Rain Load Data:

Table with 2 columns: 15-Minute Rainfall Intensity (6.27 in./hr) and 60-Minute Rainfall Intensity (3.22 in./hr).

Flood Design Data:

Table with 2 columns: Flood Design Class and Bottom Elevation of lowest horiz. member (noncoastal) (~1100 ft).

Construction Means & Methods:

- 1. Contractor assumes responsibility for job site conditions, including safety of all persons, property, and condition of materials, during the course of work and for the duration of the project.
2. The structural engineers work as presented in these documents represents the finished structure.
3. Observation visits to the site by structural engineer shall not include inspection of any item and a third party inspector shall complete all required inspections of the site.
4. The means and methods of construction rest solely in the responsibility of the contractor and the structural engineer has no control over or charge of these items nor shall not be responsible in any way for construction means, methods, techniques, sequences, or procedures, or safety or safety precautions and programs in connection with any construction activities, since these are solely contractor's responsibility.

Construction Means & Methods (cont.):

- 1. The structural engineer will not be held responsible for the contractor's schedule or ability to carry out any construction activities in accordance with the contract documents or their own agreed upon timeline with the owner.
2. As excavation occurs on the project site, unforeseen conditions may become evident.
3. The General Contractor shall provide a shop drawing submittal schedule for anticipated submittals at least two weeks prior to submittal of the first set of shop drawings.

Shop Drawing and Submittal Requirements:

- 1. The project manual shall govern all submittal requirements.
2. The general contractor shall review, check, and stamp "Approved" all shop drawings prior to submitting them to the Architect.
3. The General Contractor shall provide a shop drawing submittal schedule for anticipated submittals at least two weeks prior to submittal of the first set of shop drawings.
4. Submittals including shop drawings must be approved prior to the start of fabrication.
5. Reproducing Arrow's drawings in whole or in part for use in shop drawings is cause for rejection of the entire submittal.
6. Electronic copies of Arrow's drawings may be available on a case-by-case basis for an additional charge.

An outline summary of the expected submittals and shop drawings is provided below (the requirements of the project manual, if provided, govern):
- Concrete Mix Design
- Concrete Compressive Strength Test Results
- Rebar Shop Drawings
- Structural Steel Shop Drawings
- Wood Truss Drawings / Certification
- Exterior Stair Shop Drawings
- Railing Shop Drawings

Performance and Quality Requirements:

- 1. No provision of any referenced standard specification, manual or code (whether or not specifically incorporated by reference in the contract documents) shall be effective to change the duties and responsibilities of owner, contractor, engineer, supplier, or any of their consultants, agents, or employees from those set forth in the contract documents.
2. Contractor shall review the project site and contract documents and warrants that it has the capacity to complete the project as planned for the project budget and within the timeline allotted to the owner.
3. Contract documents include those which are published directly by Arrow Engineering including by not limited to, the structural documents (drawings and specifications).
4. Reference to standard specifications or any technical society, organization, or association or to codes of local or state authorities, shall mean the latest standard, code, specification or tentative specification adopted at the date of taking bids, unless specifically stated otherwise.
5. Where a conflict occurs within the contract documents to any recognizable material specification or building code, the strictest requirement shall govern.
6. Contractor shall obtain and coordinate edge of slab and roof deck edge dimensions with other disciplines (which may include vendor supplied information only available after bidding), opening locations and size, depressed slab locations and extents, slab slopes, curb locations, and non-structural wall locations.
7. The responsibility for all means, methods, sequences, techniques, and procedures used during construction is the responsibility of the contractor.
8. Contractor has sole responsibility to comply with all OSHA regulations.
9. The following list of items are not the responsibility of Arrow Engineering and have not been included in the scope of work (unless noted otherwise).

- Steel, concrete pan, or timber framed stairs and their connections
- Guardrail and handrail
- Cold formed metal framing
- Furnishing and finishes
- Storage or shelf systems
- Waterproofing or thermal envelope details below or above grade
- Elevator rail and hoist coordination requirements

Foundation and Footings:

- 1. Foundation design is based on assumptions of the existing site conditions.
2. As excavation occurs on the project site, unforeseen conditions may become evident.
3. The foundations for this project are spread and/or continuous bearing footings.
4. Contractor is responsible for notifying Arrow Engineering of any unusual soil conditions that are in variance with the test borings which also includes ground water, substandard bearing material, or obstructions.

- 5. All below grade foundation walls are to be considered stable only when supported at the next floor level and backfilling against them until such framing is in place is prohibited unless otherwise noted.
6. The backfill behind all foundation walls has been assumed to be 'dry' granular type with a maximum density of 75 pcf.
7. "Wet setting" of reinforcing or anchor bolts is prohibited.

- 8. The subgrade under slabs-on-grade and foundations must be compacted to 98% of optimum laboratory density in accordance with ASTM D698 Standard Proctor Method.
9. Contractor shall locate all underground utilities prior to beginning excavation.

- 10. When excavations approach the ground water level, the water level shall be continuously lowered by an acceptable dewatering system so that the water level is maintained continuously a minimum of 2'-0" below the excavation.
11. Reinforcing bar lap splices and anchorage lengths shall conform with ACI 318-14.
12. Top layer of reinforcing steel in slabs and footings shall be considered top bars regardless of thickness of concrete below the bars.

Post-Installed Anchors:

- 1. Basis of design for all post-installed concrete anchors are Hilti HUS-EZ Screw Anchors or Hilti Kwik Bolt 3 Expansion Anchors (as specified) UNO.
2. Post-installed anchors shall only be used where specified on these drawings.
3. Basis of design assumes all post-installed anchors set in fully cured concrete.
4. Post-installed anchors may interfere with existing rebar.
5. All holes for anchors shall be prepared per manufacturer's instructions.
6. All installers of post installed anchors must be qualified per the American Concrete Institute's (ACI) standard 318 "Building Code and Commentary".

Structural Concrete:

- 1. Cast-in-place concrete work shall conform to the American Concrete Institute 318-14.
2. The air content of all concrete exposed to freezing and thawing or where required to be watertight shall be 4.5%-7.5%.
3. The water to cement ratio for all concrete subjected to freezing and thawing in most conditions or required to be watertight shall have a maximum water-cement ratio of 0.45.
4. Maximum aggregate size shall be 1 1/2", well graded, well-shaped (not elongated, flat, or slippery), and free of clay, dirt, and excess fines.
5. All cement shall be type 1 unless noted.
6. The maximum slump of any concrete shall be less than 3" unless noted.
7. All reinforcing to be ASTM A615, Grade 60.
8. The welded wire fabric used in floor slabs shall be ASTM A185.
9. All reinforcing shall be located a minimum amount of 'cover' from the surface according to the following:
10. Provide joints in all slabs-on-grade at a maximum spacing of 30 times the thickness of the slab.
11. Reinforcing bar lap splices and anchorage lengths shall conform with ACI 318-14.
12. Top layer of reinforcing steel in slabs and footings shall be considered top bars regardless of thickness of concrete below the bars.
13. Provide standard lap splice at all horizontal bars in corners and intersections.
14. Where not explicitly defined, all slabs and walls shall have minimum reinforcement per ACI 318-14 accounted for in their construction.

Structural Abbreviations:

Table with 2 columns: Abbreviation and Full Name. Includes @ (ANCHOR BOLT), B/ELEV (BOTTOM OF BEAM ELEVATION), C-C (CENTER TO CENTER), DTL (DETAIL), EA (EACH), ELEV (ELEVATION), EQ (EQUAL), EQUIP (EQUIPMENT), E.S. (EACH SIDE), E.W. (EACH WAY), EX. (EXISTING), EXT. (EXTERIOR), FNDN (FOUNDATION), F.F. (FINISH FLOOR), F.F.E. (FINISH FLOOR ELEVATION), F.S. (FOOTING STEP), FTG. (FOOTING), GALV. (GALVANIZED), GR. (GRADE), HORIZ. (HORIZONTAL), H.P. (HIGH POINT), HT. (HEIGHT), I/F. (INSIDE FACE), INT. (INTERIOR), JST. (JOIST), JT. (JOINT), K*FT (KIP FEET), KLF (KIP PER LINEAL FOOT), KSF (KIPS PER SQUARE FOOT), KSI (KIPS PER SQUARE INCH), LBS (POUND), LL (LIVE LOAD), LLV (LONG LEG VERTICAL), LLH (LONG LEG HORIZONTAL), LONG. (LONGITUDINAL), MAX. (MAXIMUM), MECH. (MECHANICAL), MEZZ. (MEZZANINE), MFR. (MANUFACTURER), MIN. (MINIMUM), MISCELLANEOUS (MISCELLANEOUS), NIC (NOT IN CONTRACT), NS (NEAR SIDE), NTS (NTS), NO. (NUMBER), OC (ON CENTER), O/F (OUTSIDE FACE), PERIM. (PERIMETER), PL. (PLATE), PSF (POUNDS PER SQUARE FOOT), PSI (POUNDS PER SQUARE INCH), PIP. (POURED IN PLACE), QTY. (QUANTITY), RAD. (RADIUS), REF. (REFERENCE), REINF. (REINFORCED), REQD. (REQUIRED), REV. (REVISION), SIM. (SIMILAR), SLV (SHORT LEG VERTICAL), SOG (SHORT LEG HORIZONTAL), SLAB ON GRADE (SLAB ON GRADE), SP. (SOUTHERN PINE), SPA. (SPACING), SPEC. (SPECIFICATION), SQ. (SQUARE), SQ. FT. (SQUARE FOOT), SQ. IN. (SQUARE INCH), STD. (STANDARD), STL. (STEEL), STRUC. (STRUCTURAL), SYMMET. (SYMMETRICAL), T/B (TOP AND BOTTOM), T/ELEV. (TOP OF BEAM ELEVATION), T/O (TOP OF THICKNESS), TRANS. (TRANSVERSE), TYP. (TYPICAL), UNO. (UNLESS NOTED OTHERWISE), VERT. (VERTICAL), VEF (VERTICAL EACH FACE), VIF (VERTICAL INSIDE FACE), VIF. (VERIFY IN FIELD), W/ (WITH), W/O (WITHOUT), WL. (WIND LOAD), W.P. (WORK POINT), WT. (WEIGHT), WWF (WELDED WIRE FABRIC).

Masonry:

- 8. All reinforcing bars shall be ASTM A615, Grade 60.
9. Lay each block with full mortar coverage on head, bed (face shells), and webs, unless otherwise noted.
10. All masonry walls shall have a continuous bond beam course set at the top of each wall, at each intersecting floor level, or at 12' maximum spacing.
11. Grout solid all air spaces and the cells of all blocks below grade.

- 12. Any opening in masonry shall have a lintel placed at the top of it and bear a minimum of 4" on each side.
13. Minimum quality assurance requirements shall be per Table 1.15.2, ACI 530/ASCE5/TMS402.

- 14. Lap splices in masonry shall conform to TMS 402/ACI 530/ASCE 5 Section 2.1.9.7.1.1. The minimum length of lap splices for reinforcing bars in tension or compression, ld, shall be:

Table with 2 columns: Bar Size and ld Value. Includes #3 bar - 11", #4 bar - 18", #5 bar - 29", #6 bar - 41", #7 bar - 53", #8 bar - 72", #9 bar - 92".

- 15. All reinforcement welding shall conform to AWS D1.4. Welded splices shall be of ASTM A706 steel reinforcement. Reinforcement larger than No. 9 (M #9) shall be spliced using mechanical connections in accordance with section 2.1.9.7.3.

Structural and Miscellaneous Steel:

- 1. All structural steel work shall be done according to the "Specifications for the Design, Fabrication, and Erection of Structural Steel Buildings" (14th Edition) of the AISC.
2. Structural steel shall conform to the following:
- Wide flange shapes and WT's: ASTM A992, Fy = 50 ksi
- Channels, Angles, Plates: ASTM A36, Fy = 36 ksi
- HSS Square Tubes: ASTM A500 Gr. C, Fy = 50 ksi
- HSS Round Tubes: ASTM A500 Gr. C, Fy = 46 ksi
- Pipe: ASTM A53, Fy = 35 ksi

- 3. For any connection not explicitly detailed on the drawings, the responsibility for connection design shall be delegated to the Connection Design Engineer employed by the fabricator or owner.
4. Connections requiring axial reaction capacity shall be designed to develop the limiting axial capacity of the member in either compression or tension.
5. All bolts shall be ASTM A307 or ASTM A325 type per specified connection criteria of either slip-critical or bearing type.

Connection Shear Reaction Table:

Table with 2 columns: Bolt Size and Capacity. Includes W8's = 10 kips, W10's = 12 kips, W12's = 16 kips, W14's = 18 kips, W16's = 20 kips, W18's = 22 kips, W21's = 24 kips, W24's = 26 kips.

- 6. The CDE shall submit to the EOR a copy of the sealed design calculations for all delegated connections with the fabricator's shop drawings for approval prior to the fabricator beginning any fabrication work.
7. All bolted connections shall be made according to the AISC Manual Part 9.
8. Calculations are not needed for simple shear connections if the method used to achieve those connections are pre-qualified from the tables found in Part 10 of the AISC Steel Construction Manual.

- 9. When the design of simple shear connections as noted above is required to meet minimum shear reaction loads for composite beam connections, the connection shall be designed for the following shear value:
Beam depth > 21"..... 1.5 x Reaction
14" < Beam depth < 21"..... 2.0 x Reaction
Beam depth < 14"..... 2.5 x Reaction

- 10. Hangers, kickers, and miscellaneous equipment connections shall be designed by CDE or equipment supplier to provide for the full allowable tensile capacity of the member or attachment to the equipment.
11. All welding shall be in strict accordance with the standards of the AWS D1.1 and the AISC Manual.
12. All steel to be shop primed or galvanized.
13. No shop or field holes or cuts are to be placed in structural members unless indicated on the contract or shop drawings.

- 14. The structural steel fabricator shall field verify all dimensions prior to fabrication.
15. The structural steel fabricator shall provide for vertical and horizontal adjustment of all support assemblies.
16. Anchor bolts must meet ASTM A1554 gr. 36 specifications and be 3/4" diameter (unless otherwise indicated).
17. Additional miscellaneous structural steel may be required to support other elements specified on the contract drawings.

- 18. Unless directed by the owner with consideration from Arrow Engineering, the steel fabricator shall be certified under the AISC quality Certification Program.



600 WHITE OAKS BLVD.
P.O. BOX 940
BRIDGEPORT, WV 26330
P (304) 624-4108
F (304) 624-7831
www.thrashergroup.com

THE INFORMATION CONTAINED HEREIN IS THE SOLE PROPERTY OF THE THRASHER GROUP, INC. REPRODUCTION OF THESE DOCUMENTS IN WHOLE, OR IN PART FOR ANY REASON WITHOUT PRIOR WRITTEN PERMISSION IS STRICTLY PROHIBITED.
COPYRIGHT © 2021
THE THRASHER GROUP, INC.



304.435.8828 | www.arroweg.com | info@arroweg.com

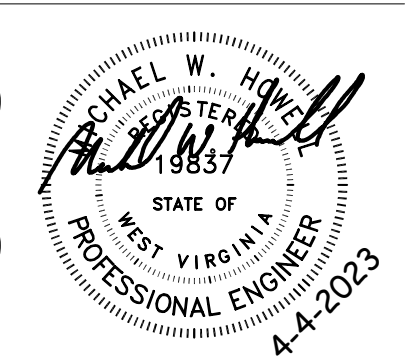


Table with 4 columns: No., Date, By, Description. Includes entry 1 with date 4.4.2023.

4.4.2023

BROOKE COUNTY EMS
BROOKE COUNTY COMMISSION
BROOKE COUNTY, WV
4.4.2023
Construction Drawings

DRAWN: PFB DATE: 4/4/2023
CHECKED: PFB DATE: 4/4/2023
APPROVED: MWH DATE: 4/4/2023

PROJECT No. T66-11009.00

GENERAL NOTES

SHEET No.

S0.01

| REQ'D FOR THIS PROJECT | MATERIAL/ACTIVITY | TYPE OF INSPECTION | REFERENCES | A / E | OWNER'S PROJ INSPECTOR | CONTINUOUS SPECIAL INSPECTION | PERIODIC SPECIAL INSPECTION | FOOTNOTE # |
|------------------------------|---------------------------------------|---|--|-------|------------------------|-------------------------------|-----------------------------|------------|
| SPECIAL CASES | | | | | | | | |
| | VARIABLES | VARIABLES- FOR WORK DEFINED BY THE BUILDING OFFICIAL AS "UNUSUAL IN ITS NATURE" | 1705.1.1 | X | X | | | 1 |
| CONCRETE CONSTRUCTION | | | | | | | | |
| | | | | | | | | 4 |
| X | REINF. STEEL | REINFORCEMENT/ PRESTRESSING TENDONS. VERIFY PLACEMENT | 1705.3, ACI 318: CH. 20, 25.2, 25.3, 26.6.1-26.6.3 | | X | | X | |
| X | REINF. STEEL WELDS | WELD: VERIFY WELDABILITY OF REINF. BARS OTHER THAN ASTM A706 | 1705.3, AWS D1.4, ACI 318: 26.6.4 | | X | | X | |
| X | REINF. STEEL WELDS | WELD: SINGLE-PASS FILLET WELDS MAX 5/16" | 1705.3, AWS D1.4, ACI 318: 26.6.4 | | X | | X | |
| X | REINF. STEEL WELDS | WELD: ALL OTHER WELDS | 1705.3, AWS D1.4, ACI 318: 26.6.4 | | X | X | | |
| X | CONC. CAST ANCHORS | ANCHORS CAST IN CONCRETE | 1705.3, ACI 318: 17.8.2 | | X | | X | |
| X | POST-INSTALLED ANCHORS IN HARDENED CC | INSPECT ADHESIVE ANCHORS INSTALLED IN HORIZONTALLY OR UPWARDLY INCLINED ORIENTATIONS TO RESIST SUSTAINED TENSION LOADS | 1705.3, ACI 318: 17.8.2.4 | | X | X | | |
| X | POST-INSTALLED ANCHORS IN HARDENED CC | INSPECT ALL OTHER MECHANICAL ANCHORS AND ADHESIVE ANCHORS NOT LISTED IN DESCRIPTION ABOVE | 1705.3, ACI 318: 17.8.2 | | X | | X | |
| X | CC MIX | VERIFY USE OF REQ'D DESIGN MIX | 1705.3, ACI 318: CH. 19, 26.4.3, 26.4.4 | | X | | X | |
| X | CC MIX | PRIOR TO CC PLACEMENT, PERFORM STRENGTH TESTS: SLUMP AND AIR CONTENT. DETERMINE TEMP. OF CC | 1705.3, ASTM C31, C172, ACI 318: 26.5, 26.12 | | X | X | | |
| | CC | VERIFY CORRECT CC AND SHOTCRETE PLACEMENT FOR PROPER APPLICATION TECHNIQUES | 1705.3, ACI 318: 26.5 | | X | X | | |
| | CC | VERIFY MAINTENANCE OF CURING TEMP/TECHNIQUES | 1705.3, ACI 318: 26.5.3-26.5.5 | | X | | X | |
| MASONRY CONSTRUCTION | | | | | | | | |
| | | | | | | | | 6 |
| X | MASONRY | INSPECT/TEST GLASS UNIT MASONRY/MASONRY VENEER ACCORDING TO SECTION 2110 OR CH. 14 WHERE THEY ARE PART OF A STRUCTURE CLASSIFIED AS RISK CATEGORY IV SHALL BE PERFORMED ACCORDING TO TMS 602 LEVEL 2. | 1705.4 | | X | | | |
| X | MASONRY | VERTICAL MASONRY FOUNDATION ELEMENTS ACCORDING TO SECTION 1705.4 | 1705.4 | | X | | | |
| SOILS | | | | | | | | |
| | | | | | | | | 7 |
| X | MATERIALS | VERIFY MATERIALS BELOW SHALLOW FOUNDATIONS CAN ACHIEVE BEARING CAPACITY | 1705.6 | | X | | X | |
| X | MATERIALS | VERIFY EXCAVATIONS ARE EXTENDED TO PROPER DEPTH AND HAVE REACHED PROPER MATERIAL | 1705.6 | | X | | X | |
| X | MATERIALS | CLASSIFY AND TEST COMPACTED FILL MATERIALS | 1705.6 | | X | | X | |
| X | MATERIALS | DURING FILL PLACEMENT, VERIFY USE OF PROPER MATERIALS AND PROCEDURES IN ACCORDANCE WITH THE PROVISIONS OF THE APPROVED GEOTECHNICAL REPORT. VERIFY DENSITIES AND LIFT THICKNESSES DURING PLACEMENT AND COMPACTION OF COMPACTED FILL | 1705.6 | | X | X | | |
| X | MATERIALS | VERIFY PROPER SUBGRADE PRIOR TO PLACEMENT OF FILL | 1705.6 | | X | | X | |
| FOUNDATIONS | | | | | | | | |
| X | CAST-IN-PLACE | INSPECT DRILLING OPERATIONS AND MAINTAIN COMPLETE AND ACCURATE RECORDS FOR EACH ELEMENT | 1705.8 | | X | X | | |
| X | CAST-IN-PLACE | VERIFY PLACEMENT LOCATIONS/PLUMBNESS, ELEMENT DIAMETERS, LENGTHS, EMBEDMENT INTO BEDROCK AND ADEQUATE END-BEARING STRATA CAPACITY. RECORD CC/GROUT VOLUMES. | 1705.8 | | X | X | | |
| X | CAST-IN-PLACE, CC | PERFORM ADDITIONAL SPECIAL INSPECTIONS ACCORDING TO SEC. 1705.3 | 1705.8 | | X | | | |
| FABRICATED ITEMS | | | | | | | | |
| X | FABRICATED ITEMS | PERFORM ADDITIONAL SPECIAL INSPECTIONS ACCORDING TO SEC. 1704.2.5 | 1705.11 | | X | | | |
| STEEL CONSTRUCTION | | | | | | | | |
| | | | | | | | | 2,3 |
| X | STR. STEEL ELEMENTS | VERIFY AISC 360 QUALITY ASSURANCE REQUIREMENTS ARE MET FOR BUILDING, STRUCTURE, AND PORTIONS THEREOF | 1705.2.1 | | X | | X | |
| X | OW STEEL JOISTS/GIRDERS | END CONNECTIONS- WELDING OR BOLTED | 1705.2.3, 2207.1 | | X | | X | |
| X | OW STEEL JOISTS/GIRDERS | STANDARD BRIDGING | 1705.2.3, 2207.1 | | X | | X | |
| WOOD CONSTRUCTION | | | | | | | | |
| X | METAL-PLATE TRUSSES | VERIFY MEMBER BRACING AND TEMPORARY BRACING WAS INSTALLED ACCORDING TO APPROVED TRUSS SUBMITTAL PACKAGE. | 1705.5.2 | | X | | | |

FOOTNOTES:

- SPECIAL CASES INCLUDE PROPOSED WORK THAT IS, IN THE OPINION OF THE BUILDING OFFICIAL, UNUSUAL IN ITS NATURE, SUCH AS, BUT NOT LIMITED TO THE FOLLOWING EXAMPLES: MATERIALS AND SYSTEMS THAT ARE ALTERNATIVES TO MATERIALS AND SYSTEMS PRESCRIBED BY THIS CODE, UNUSUAL DESIGN APPLICATIONS OF MATERIALS DESCRIBED IN THIS CODE, AND/OR MATERIALS AND SYSTEMS REQUIRED TO BE INSTALLED IN ACCORDANCE WITH ADDITIONAL MANUFACTURER'S INSTRUCTIONS THAT PRESCRIBE REQUIREMENTS NOT CONTAINED IN THIS CODE OR IN STANDARDS REFERENCED BY THIS CODE.
- EXCEPTIONS: SPECIAL INSPECTIONS SHALL NOT BE REQUIRED FOR 1.) ISOLATED SPREAD CC FOOTINGS OF BUILDINGS 3 STORIES OR LESS ABOVE GRADE PLANE THAT ARE FULLY SUPPORTED ON EARTH OR ROCK. 2.) CONTINUOUS CC FOOTINGS SUPPORTING WALLS OF BUILDINGS 3 STORIES OR LESS ABOVE GRADE PLANE THAT ARE FULLY SUPPORTED ON EARTH OR ROCK WHERE THE FOOTINGS SUPPORT WALLS OF LIGHT-FRAME CONSTRUCTION, THE FOOTINGS ARE DESIGNED IN ACCORDANCE WITH T.1807.1.6.2, OR THE STRUCTURAL DESIGN OF THE FOOTING IS BASED ON THE SPECIFIED COMPRESSIVE STRENGTH NOT MORE THAN 2,500 PSI, REGARDLESS OF COMPRESSIVE STRENGTH SPECIFIED IN THE APPROVED CONSTRUCTION DOCS OR USED IN THE FOOTING CONSTRUCTION. 3.) NONSTRUCTURAL CC SLABS SUPPORTED DIRECTLY ON THE GROUND, INCLUDING PRESTRESSED SLABS ON GRADE, WHERE THE EFFECTIVE PRESTRESS IN THE CC IS LESS THAN 150 PSI. 4.) CC FOUNDATION WALLS CONSTRUCTED IN ACCORDANCE WITH T.1807.1.6.2. 5.) CC PATIOS, DRIVEWAYS AND SIDEWALKS, ON GRADE.
- EXCEPTIONS: 1.) EMPIRICALLY DESIGNED MASONRY, GLASS UNIT MASONRY OR MASONRY VENEER DESIGNED IN ACCORDANCE WITH SECTION 2109, 2110 OR CH.14, RESPECTFULLY, WHERE THEY ARE PART OF A STRUCTURE CLASSIFIED AS RISK CATEGORY 1,2, OR 3. 2.) MASONRY FOUNDATION WALLS CONSTRUCTED IN ACCORDANCE WITH T.1807.1.6.3(1), 1807.1.6.3(2), 1807.1.6.3(3), OR 1807.1.6.3(4) 3.) MASONRY FIREPLACES, MASONRY HEATERS OR MASONRY CHIMNEYS INSTALLED OR CONSTRUCTED IN ACCORDANCE WITH SECTION 2111, 2112, OR 2113, RESPECTIVELY.
- EXCEPTION: WHERE SECTION 1803 DOES NOT REQUIRE REPORTING OF MATERIALS AND PROCEDURES FOR FILL PLACEMENT, THE SPECIAL INSPECTOR SHALL VERIFY THAT THE IN-PLACE DRY DENSITY OF THE COMPACTED FILL IS NOT LESS THAN 90 PERCENT OF THE MAXIMUM DRY DENSITY AT OPTIMUM MOISTURE CONTENT DETERMINED IN ACCORDANCE WITH ASTM D1557.
- THESE SPECIAL INSPECTIONS ARE REQUIRED FOR (UNLESS EXEMPTED BY THE EXEPTIONS IN SECTION 1704.2): BUILDINGS/STRUCTURES IN WIND EXPOSURE CATEGORY B WHERE V IS 150 MPH OR GREATER, OR IN WIND EXPOSURE CATEGORY C OR D WHERE V IS 140 MPH OR GREATER
- SPECIAL INSPECTIONS ARE NOT REQUIRED FOR COLD-FORMED STEEL LIGHT FRAME SHEAR WALLS AND DIAPHRAGMS, INCLUDING SCREWING, BOLTING, ANCHORING AND OTHER FASTENING TO COMPONENTS OF THE WINDFORCE RESISTING SYSTEM, WHERE EITHER OF THE FOLLOWING APPLIES: 1.) THE SHEATHING IS GYPSUM OR FIBERBOARD 2.) THE SHEATHING IS WOOD STR. PANEL OR STEEL SHEETS ON ONLY ONE SIDE OF THE SHEAR WALL, SHEAR PANEL, OR DIAPHRAGM ASSEMBLY AND THE FASTENER SPACING OF THE SHEATHING IS MORE THAN 4 INCHES OC
- EXCEPTION: SPECIAL INSPECTIONS ARE NOT REQUIRED FOR 1.) LIGHT FRAME CONSTRUCTION, WHERE THE DESIGN SPECTRAL RESPONSE ACCELERATION AT SHORT PERIODS DOES NOT EXCEED 0.5, AND THE BUILDING HEIGHT DOES NOT EXCEED 35 FT. 2.) THE SEISMIC FORCE RESISTING SYSTEM OF THE STRUCTURE CONSISTS OF REINFORCED MASONRY/CONCRETE, THE DESIGN RESPONSE ACCELERATION AT SHORT PERIODS DOES NOT EXCEED 0.5, AND BUILDING HEIGHT DOES NOT EXCEED 25 FT. 3.) THE STRUCTURE IS A DETACHED ONE OR TWO FAMILY DWELLING NOT EXCEEDING 2 STORIES ABOVE GRADE PLANE AND DOES NOT HAVE ANY OF THE FOLLOWING HORIZONTAL OR VERTICAL IRREGULARITIES IN ACCORDANCE WITH SECTION 12.3 OF ASCE 7: TORSIONAL OR EXTREME TORSIONAL IRREGULARITY, NONPARALLEL SYSTEMS IRREGULARITY, STIFFNESS-SOFT STORY OR STIFFNESS-EXTREME SOFT-STORY IRREGULARITY, DISCONTINUITY IN LATERAL STRENGTH-WEAK STORY IRREGULARITY.

CMU GROUT REQUIREMENTS:

| Grout type a | Maximum grout pour height, ft (m) | Minimum clear width of grout space, in. (mm) b,c | Minimum clear grout space dimensions for grouting cells of hollow units, in. x in. (mm x mm) c,d,e |
|-----------------|-----------------------------------|---|---|
| Fine | 1 (0.30) | 3/4 (19.1) | 1 1/2 x 2 (38.1 x 50.8) |
| Fine | 5.33 (1.63) | 2 (50.8) | 2 x 3 (50.8 x 76.2) |
| Fine | 12.67 (3.86) | 2 1/2 (63.5) | 2 1/2 x 3 (63.5 x 76.2) |
| Fine | 24 (7.32) | 3 (76.2) | 3 x 3 (76.2 x 76.2) |
| Coarse | 1 (0.30) | 1 1/2 (38.1) | 1 1/2 x 3 (38.1 x 76.2) |
| Coarse | 5.33 (1.63) | 2 (50.8) | 2 1/2 x 3 (63.5 x 76.2) |
| Coarse | 12.67 (3.86) | 2 1/2 (63.5) | 3 x 3 (76.2 x 76.2) |
| Coarse | 24 (7.32) | 3 (76.2) | 3 x 4 (76.2 x 102) |

Notes:

- Fine and coarse grouts are defined in ASTM C476.
- For grouting between masonry wythes.
- Minimum clear width of grout space and minimum clear grout space dimension are the net dimension of the space determined by subtracting masonry protrusions and the diameters of horizontal bars from the as-built cross-section of the grout space. Select the grout type and maximum grout pour height based on the minimum clear space.
- Area of vertical reinforcement shall not exceed 6 percent of the area of the grout space.
- Minimum grout space dimension for AAC masonry units shall be 3 in. (76.2 mm) x 3 in. (76.2 mm) or a 3 in. (76.2 mm) diameter cell.

LAYOUT TAB: SPECIAL INSPECTIONS 4/4/2023 8:59:09 AM USER: PFB

PLOT DATE/TIME: 4/4/2023 8:59:09 AM CAD FILE: A:\Projects\2022\18_Thrasher - Boone EMS\Draw - Brooke EMS v2 (OWNER CHANGE).rvt


THRASHER
600 WHITE OAKS BLVD.
P.O. BOX 940
BRIDGEPORT, WV 26330

P (304) 624-4108
F (304) 624-7831

www.thrashergroup.com

THE INFORMATION CONTAINED HEREIN IS THE SOLE PROPERTY OF THE THRASHER GROUP, INC. REPRODUCTION OF THESE DOCUMENTS IN WHOLE OR IN PART FOR ANY REASON WITHOUT PRIOR WRITTEN PERMISSION IS STRICTLY PROHIBITED. COPYRIGHT © 2021 THE THRASHER GROUP, INC.

ARROW
STRUCTURAL ENGINEERING
304.435.8828 | www.arroweg.com | info@arroweg.com

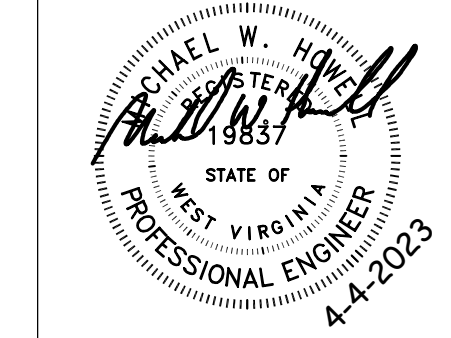

| NO. | BY | DATE | DESCRIPTION |
|-----|----|----------|-------------|
| 1 | | 4.4.2023 | Addendum #3 |

BROOKE COUNTY EMS
BROOKE COUNTY COMMISSION
BROOKE COUNTY, WV
4.4.2023
Construction Drawings


DRAWN: PFB DATE: 4/4/2023
CHECKED: PFB DATE: 4/4/2023
APPROVED: MWH DATE: 4/4/2023

PROJECT No. T60-11009.00

SPECIAL INSPECTIONS

SHEET No.

S0.02

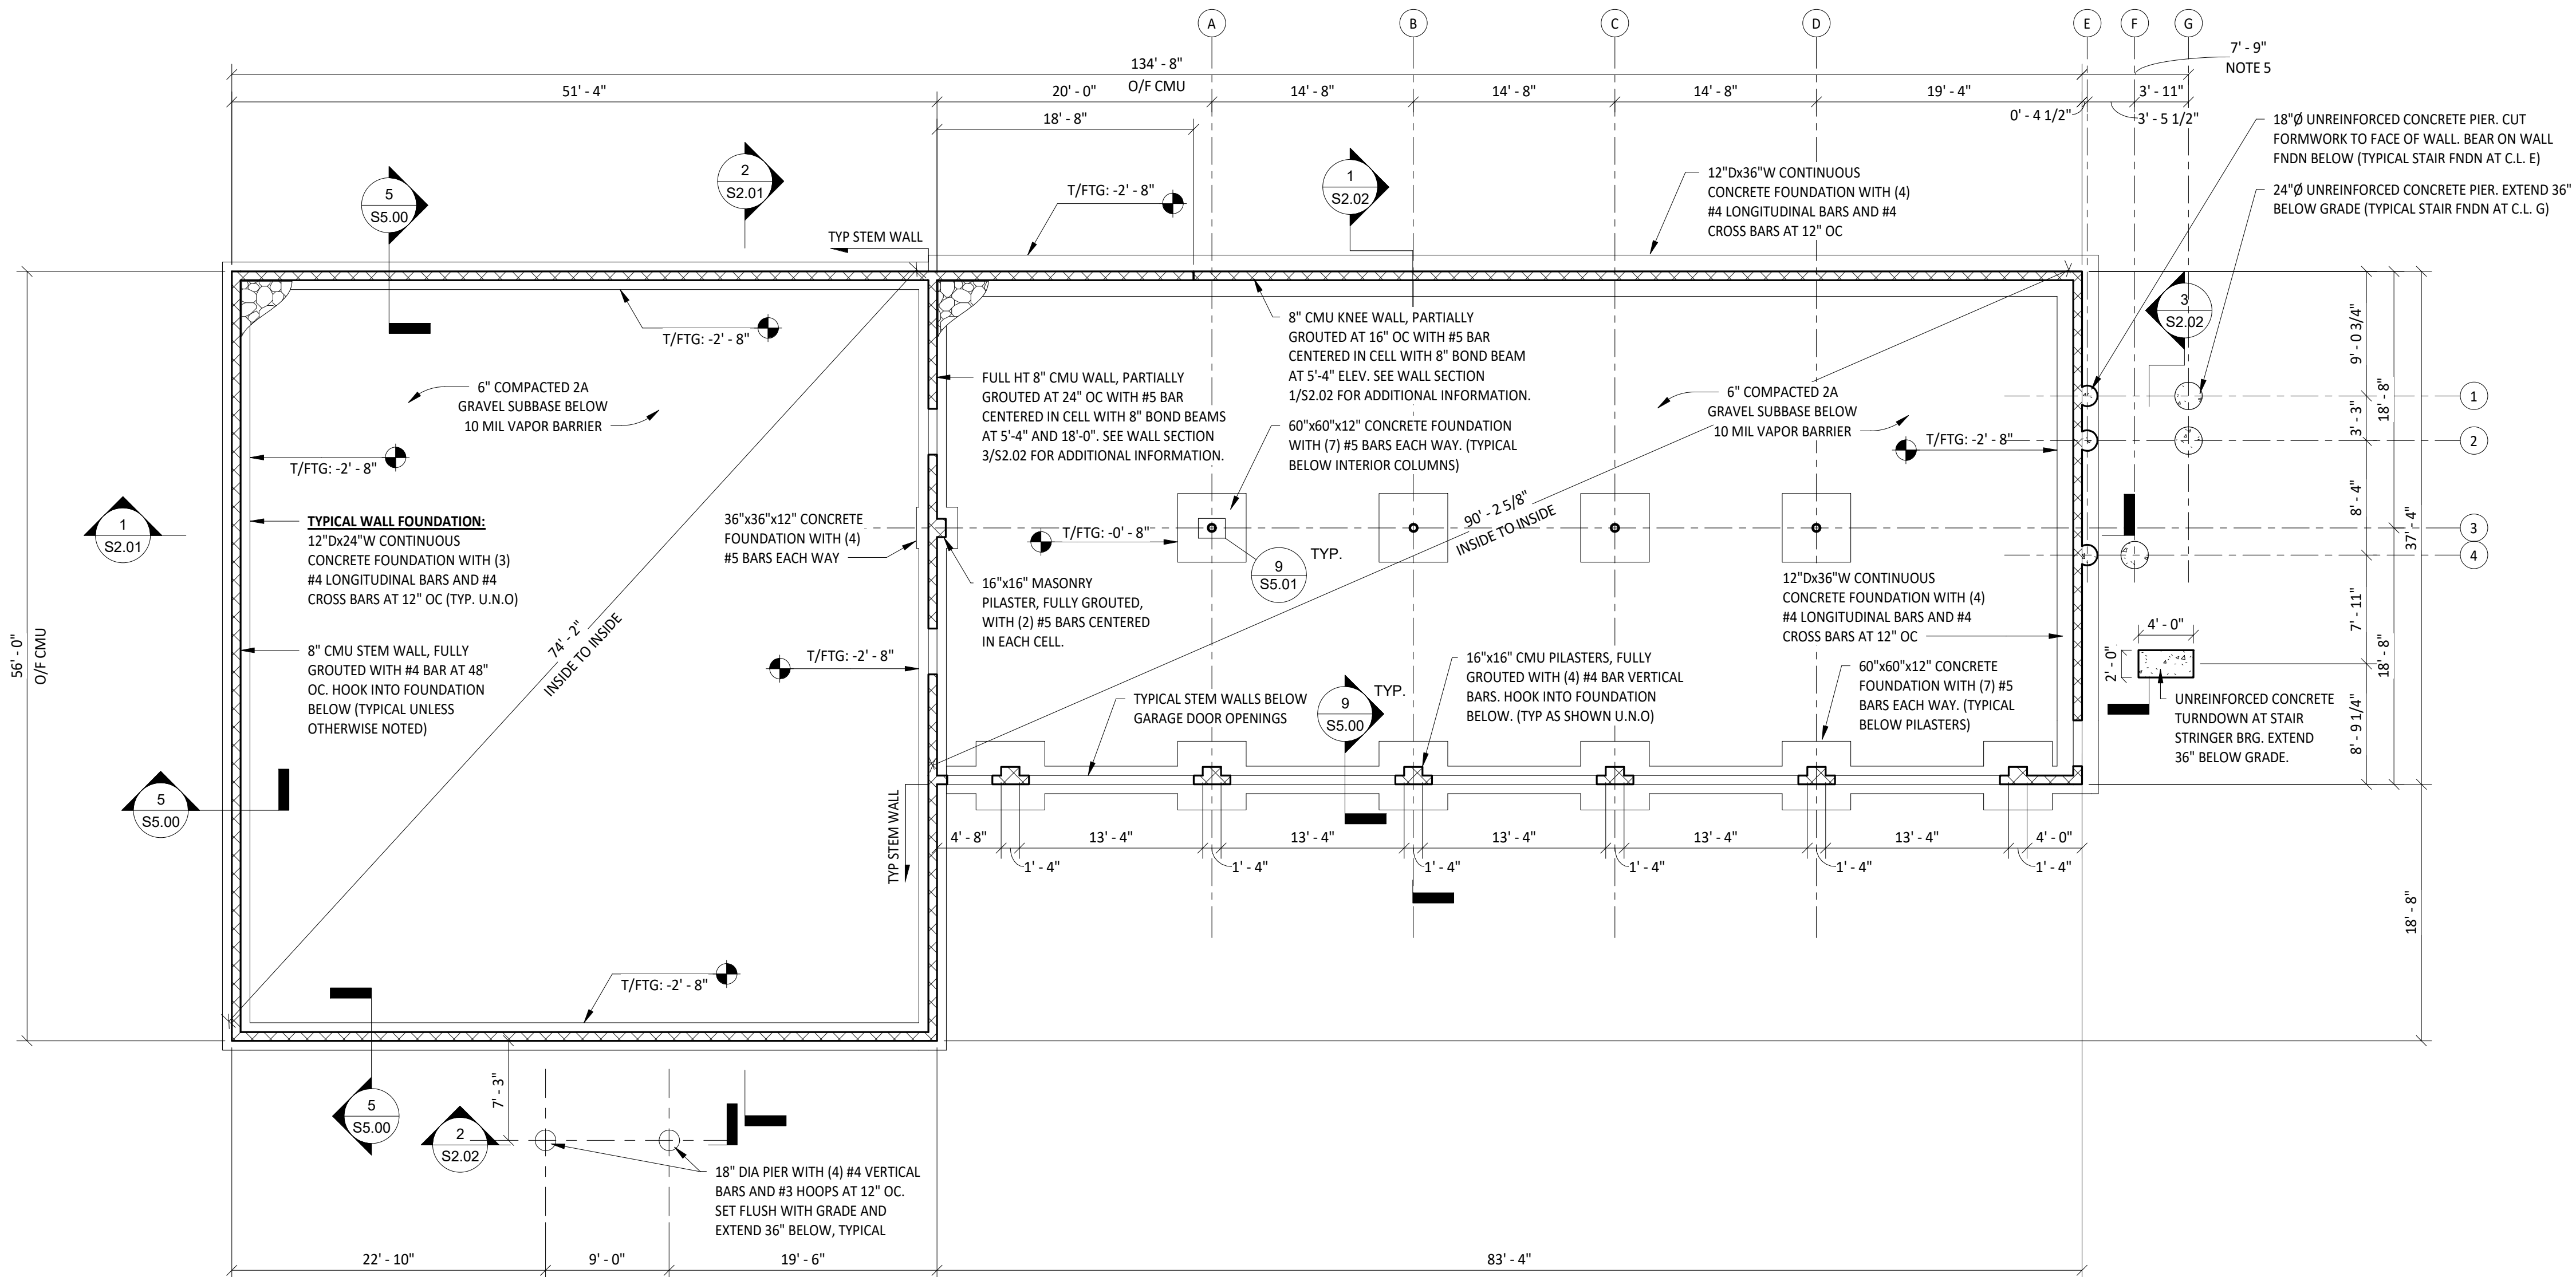

FOUNDATION PLAN
SCALE: 1/8" = 1'-0"
NORTH

- NOTES:
- 1) ALL DIMENSIONS REFERENCE OUTSIDE FACE OF CMU OR CENTERLINE OF PIER UNLESS OTHERWISE NOTED.
 - 2) SEE ADDITIONAL NOTES ON S0.01 AND SPECIAL INSPECTIONS ON S0.02.
 - 3) REFER TO DETAILS ON S5.00, S5.01, AND S5.02.
 - 4) ALL ELEVATIONS REFERENCE FINISH FLOOR AS ELEV 0'-0".
 - 5) COORDINATE EXTERIOR STAIR FOUNDATION LOCATIONS WITH STEEL SHOP DRAWINGS FOR FINAL DIMENSIONS.

| NO. | BY | DATE | DESCRIPTION |
|-----|----|----------|-------------|
| 1 | | 4.4.2023 | Addendum #3 |


BROOKE COUNTY EMS
BROOKE COUNTY COMMISSION
BROOKE COUNTY, WV
4.4.2023
Construction Drawings

DRAWN: PFB DATE: 4/4/2023
CHECKED: PFB DATE: 4/4/2023
APPROVED: MWH DATE: 4/4/2023

PROJECT No. T60-11009.00

FOUNDATION PLAN

SHEET No. **S1.00**

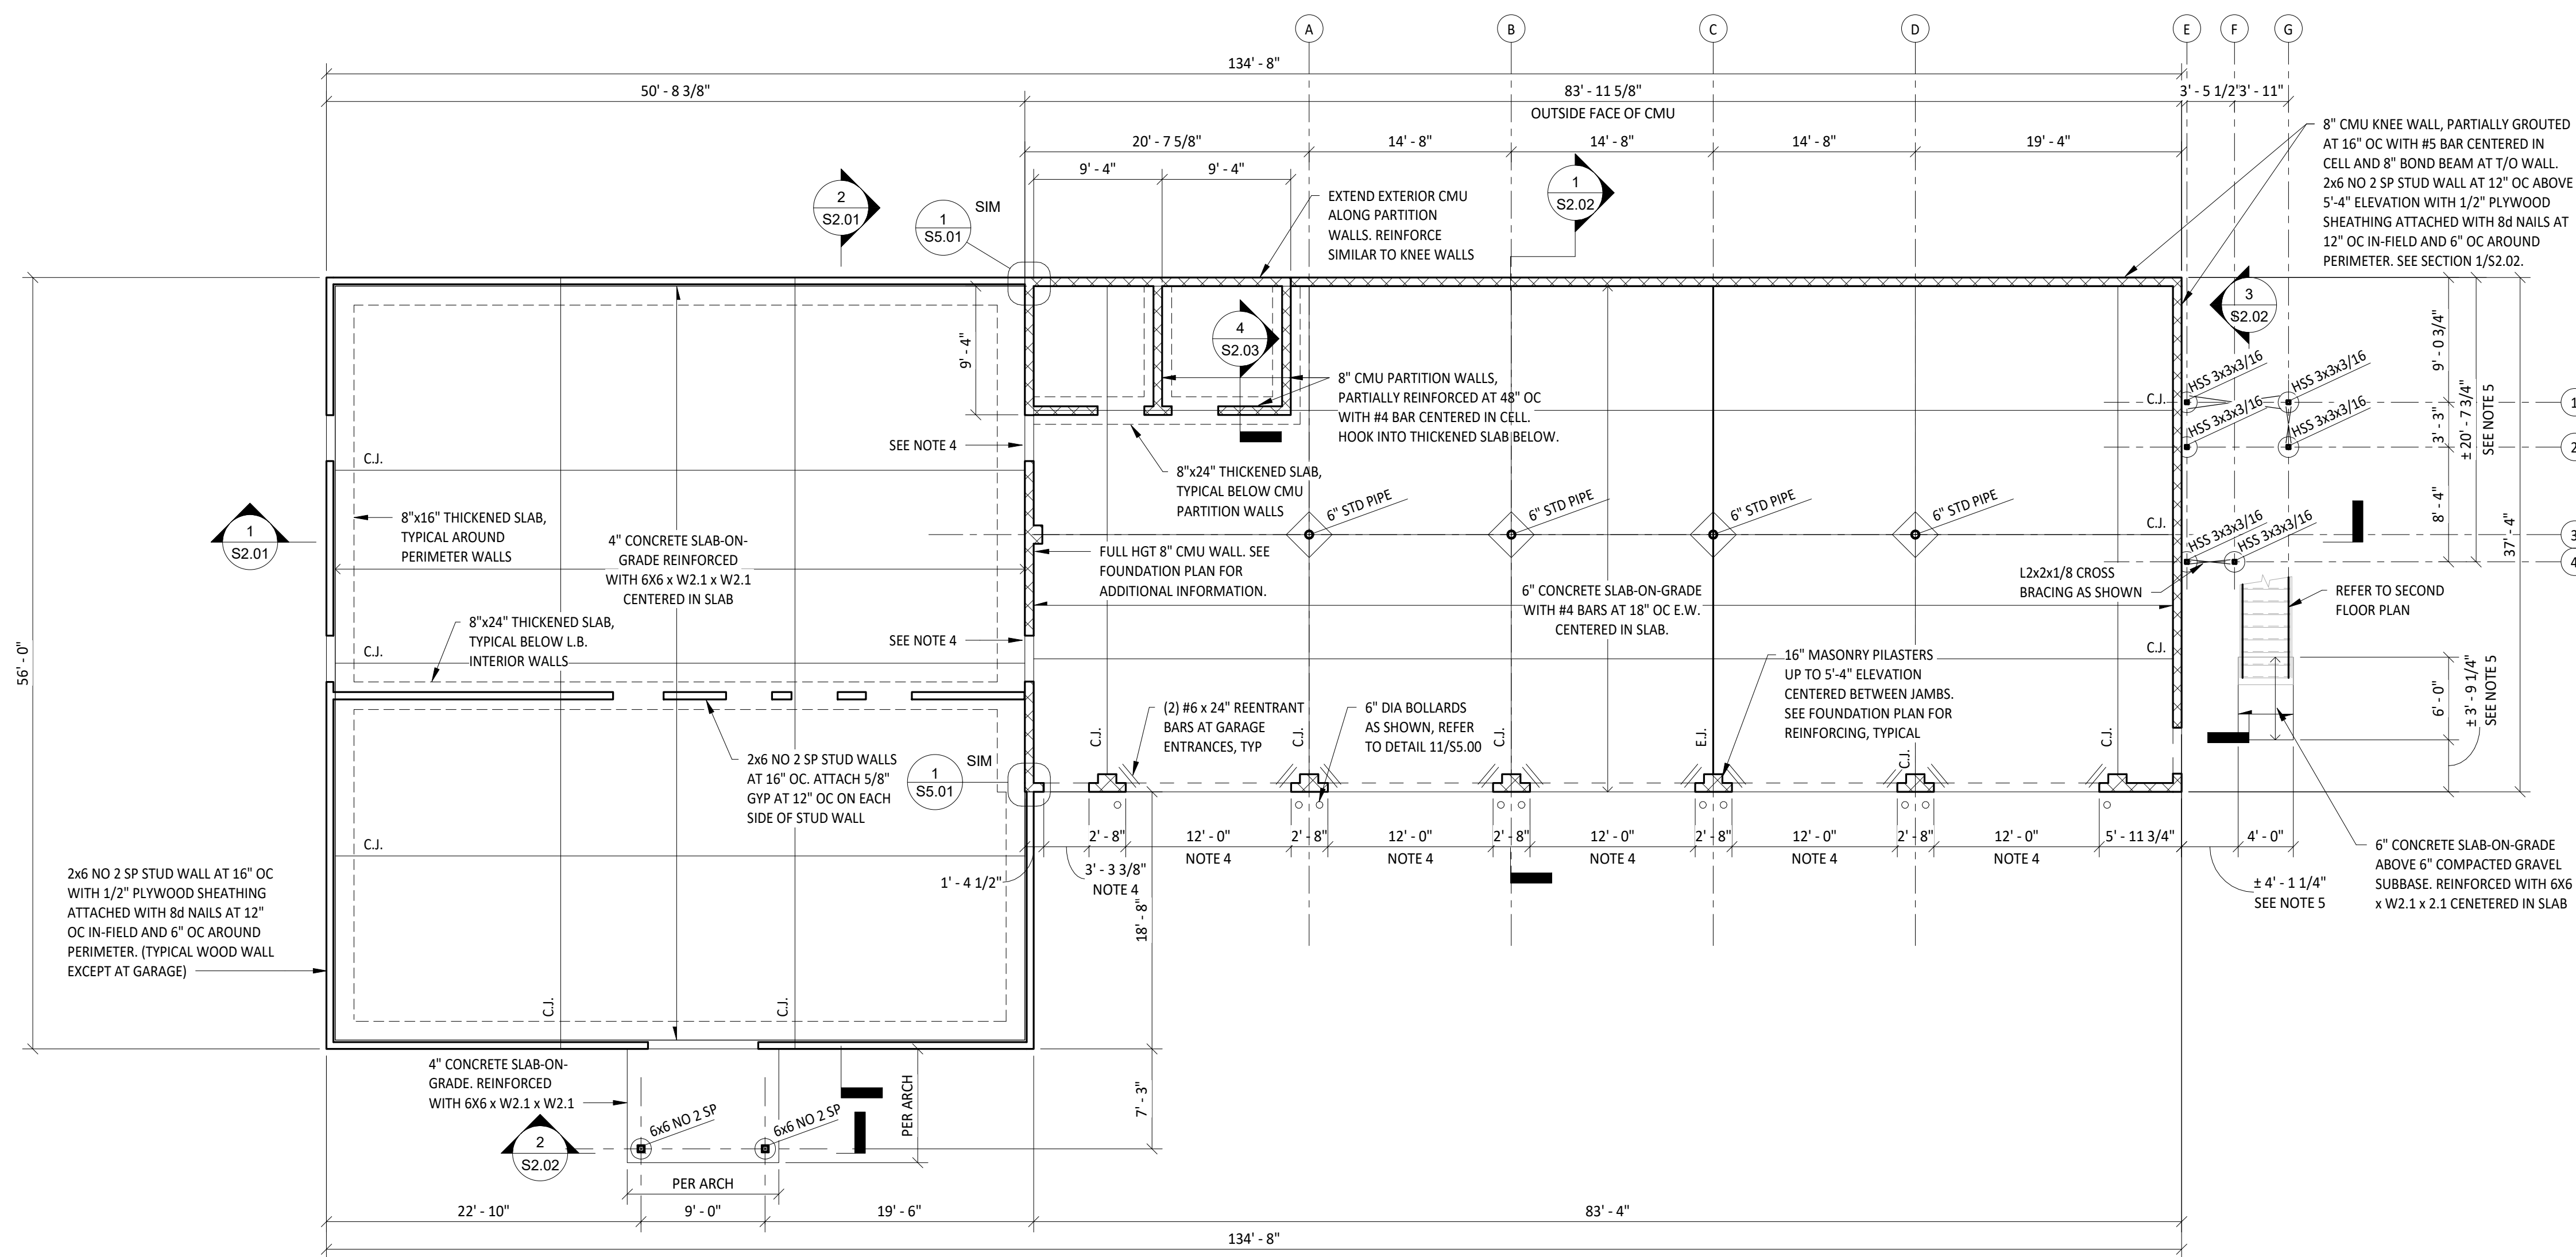

MAIN FLOOR SLAB PLAN
SCALE: 1/8" = 1'-0"
NORTH

- NOTES:
- 1) PROVIDE MINIMUM (2) 2x6 JACK STUDS AND (1) 2x6 KING STUD UNDER ALL BEAMS UNLESS NOTED OTHERWISE.
 - 2) ALL INTERIOR CMU LINTELS SHALL BE 2LSx3.5x1/4 LLV UNLESS OTHERWISE NOTED.
 - 3) ALL EXPOSED MASONRY IS INTENDED TO BE SPLIT-FACE. SEE ARCHITECTURAL DRAWINGS FOR MORE INFORMATION.
 - 4) COORDINATE FINAL LAYOUT AND OPENING SIZES WITH DOOR MANUFACTURER AND ARCHITECTURAL DRAWINGS.
 - 5) FINAL STAIR LAYOUT IS THE RESPONSIBILITY OF THE FABRICATOR. REFER TO ARCHITECTURAL DRAWINGS FOR DESIRED LAYOUT AND RISE/RUN. REFER TO S1.02 FOR STRINGER AND BEAM SIZES. FINAL CONNECTIONS TO BE DESIGNED BY FABRICATOR AND SUBMITTED FOR APPROVAL PRIOR TO FABRICATION.
 - 6) SLOPE CONCRETE IN AMBULANCE BAY TO NEAREST DRAIN OR GARAGE OPENING.
 - 7) SEE ADDITIONAL NOTES ON S0.01 AND SPECIAL INSPECTIONS ON S0.02.
 - 8) REFER TO DETAILS ON S5.00, S5.01, AND S5.02.

| NO. | BY | DATE | DESCRIPTION |
|-----|----|----------|-------------|
| 1 | | 4.4.2023 | Addendum #3 |

BROOKE COUNTY EMS
BROOKE COUNTY COMMISSION
BROOKE COUNTY, WV
4.4.2023
Construction Drawings


DRAWN: PDB DATE: 4/4/2023
CHECKED: PDB DATE: 4/4/2023
APPROVED: MWH DATE: 4/4/2023

PROJECT No. T60-11009.00

MAIN FLOOR SLAB PLAN

SHEET No.

S1.01

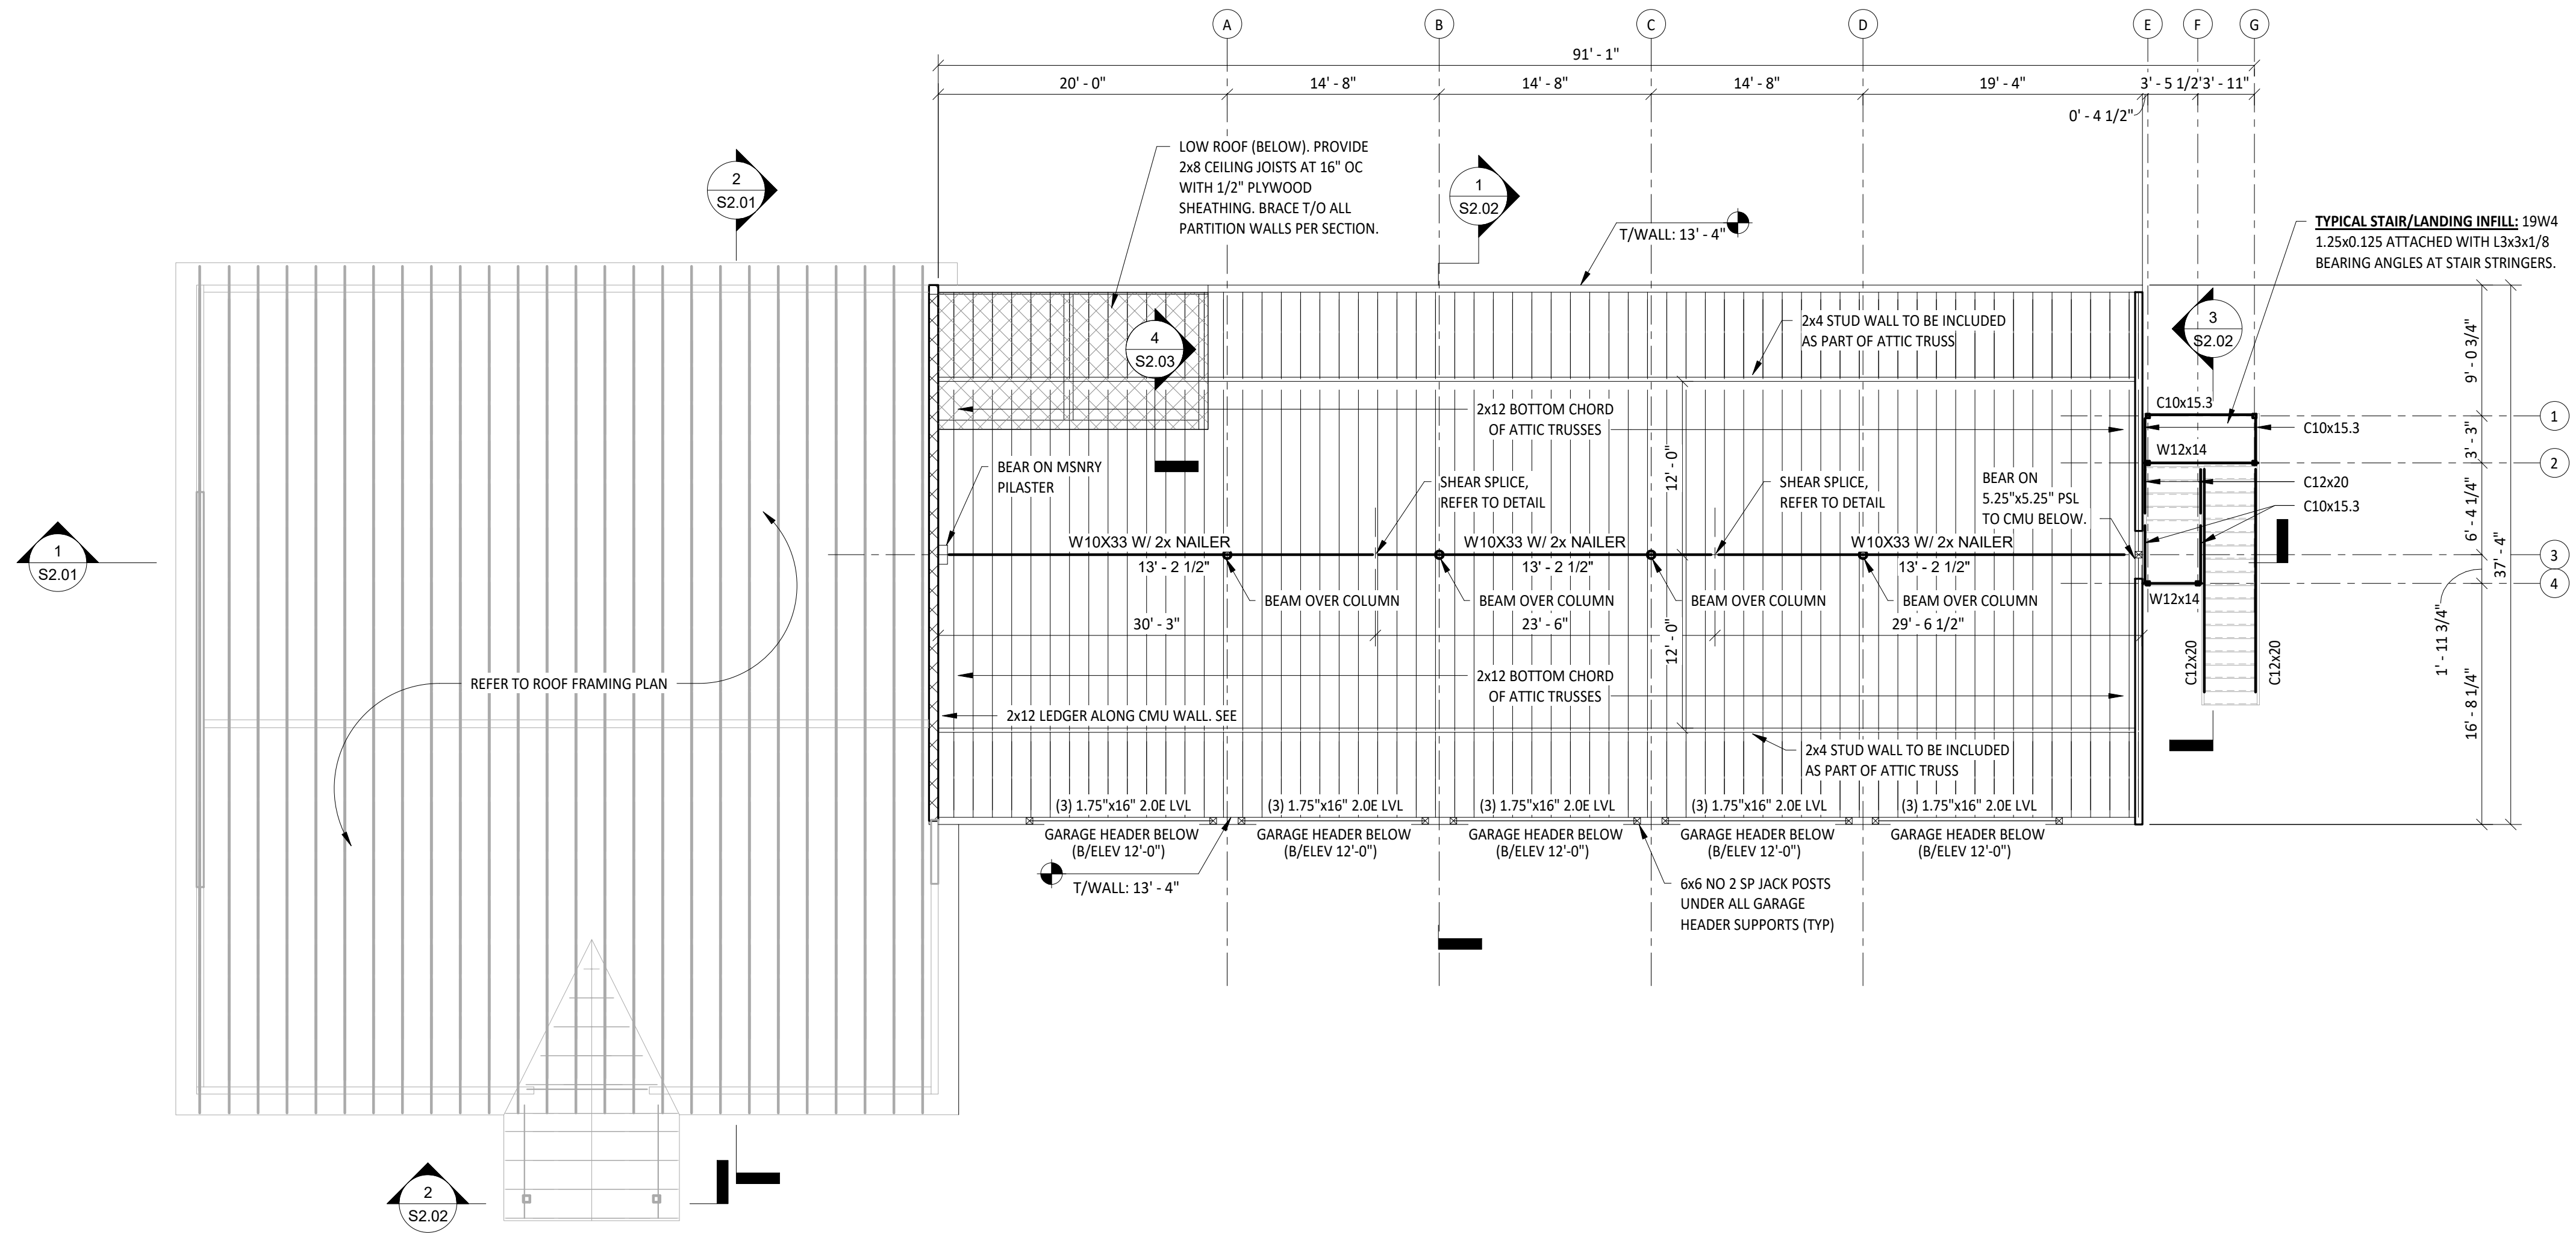

PLAN
NORTH
SECOND FLOOR FRAMING PLAN
SCALE: 1/8" = 1'-0"

- NOTES:
- 1) ALL INTERIOR STRUCTURAL STEEL SHALL BE SHOP PRIMED AND PAINTED PER ARCHITECTURAL DRAWINGS.
 - 2) ALL EXTERIOR STEEL MEMBERS AND CONNECTIONS SHOULD BE HOT-DIPPED GALVANIZED.
 - 3) FINAL STAIR LAYOUT AND DIMENSIONS ARE THE RESPONSIBILITY OF THE FABRICATOR. REFER TO ARCHITECTURAL DRAWINGS FOR DESIRED LAYOUT AND RISE/RUN. FINAL CONNECTIONS TO BE DESIGNED BY FABRICATOR AND SUBMITTED FOR APPROVAL PRIOR TO FABRICATION.
 - 4) SEE ADDITIONAL NOTES ON S0.01 AND SPECIAL INSPECTIONS ON S0.02.
 - 5) REFER TO DETAILS ON S5.00, S5.01, AND S5.02.

| NO. | BY | DATE | DESCRIPTION |
|-----|----|----------|-------------|
| 1 | | 4.4.2023 | Addendum #3 |



BROOKE COUNTY EMS
BROOKE COUNTY COMMISSION
BROOKE COUNTY, WV
4.4.2023
Construction Drawings

DRAWN: Author DATE: 4/4/2023
CHECKED: Checker DATE: 4/4/2023
APPROVED: Approver DATE: 4/4/2023

PROJECT No. T60-11009.00

SECOND FLOOR FRAMING PLAN

SHEET No. **S1.02**

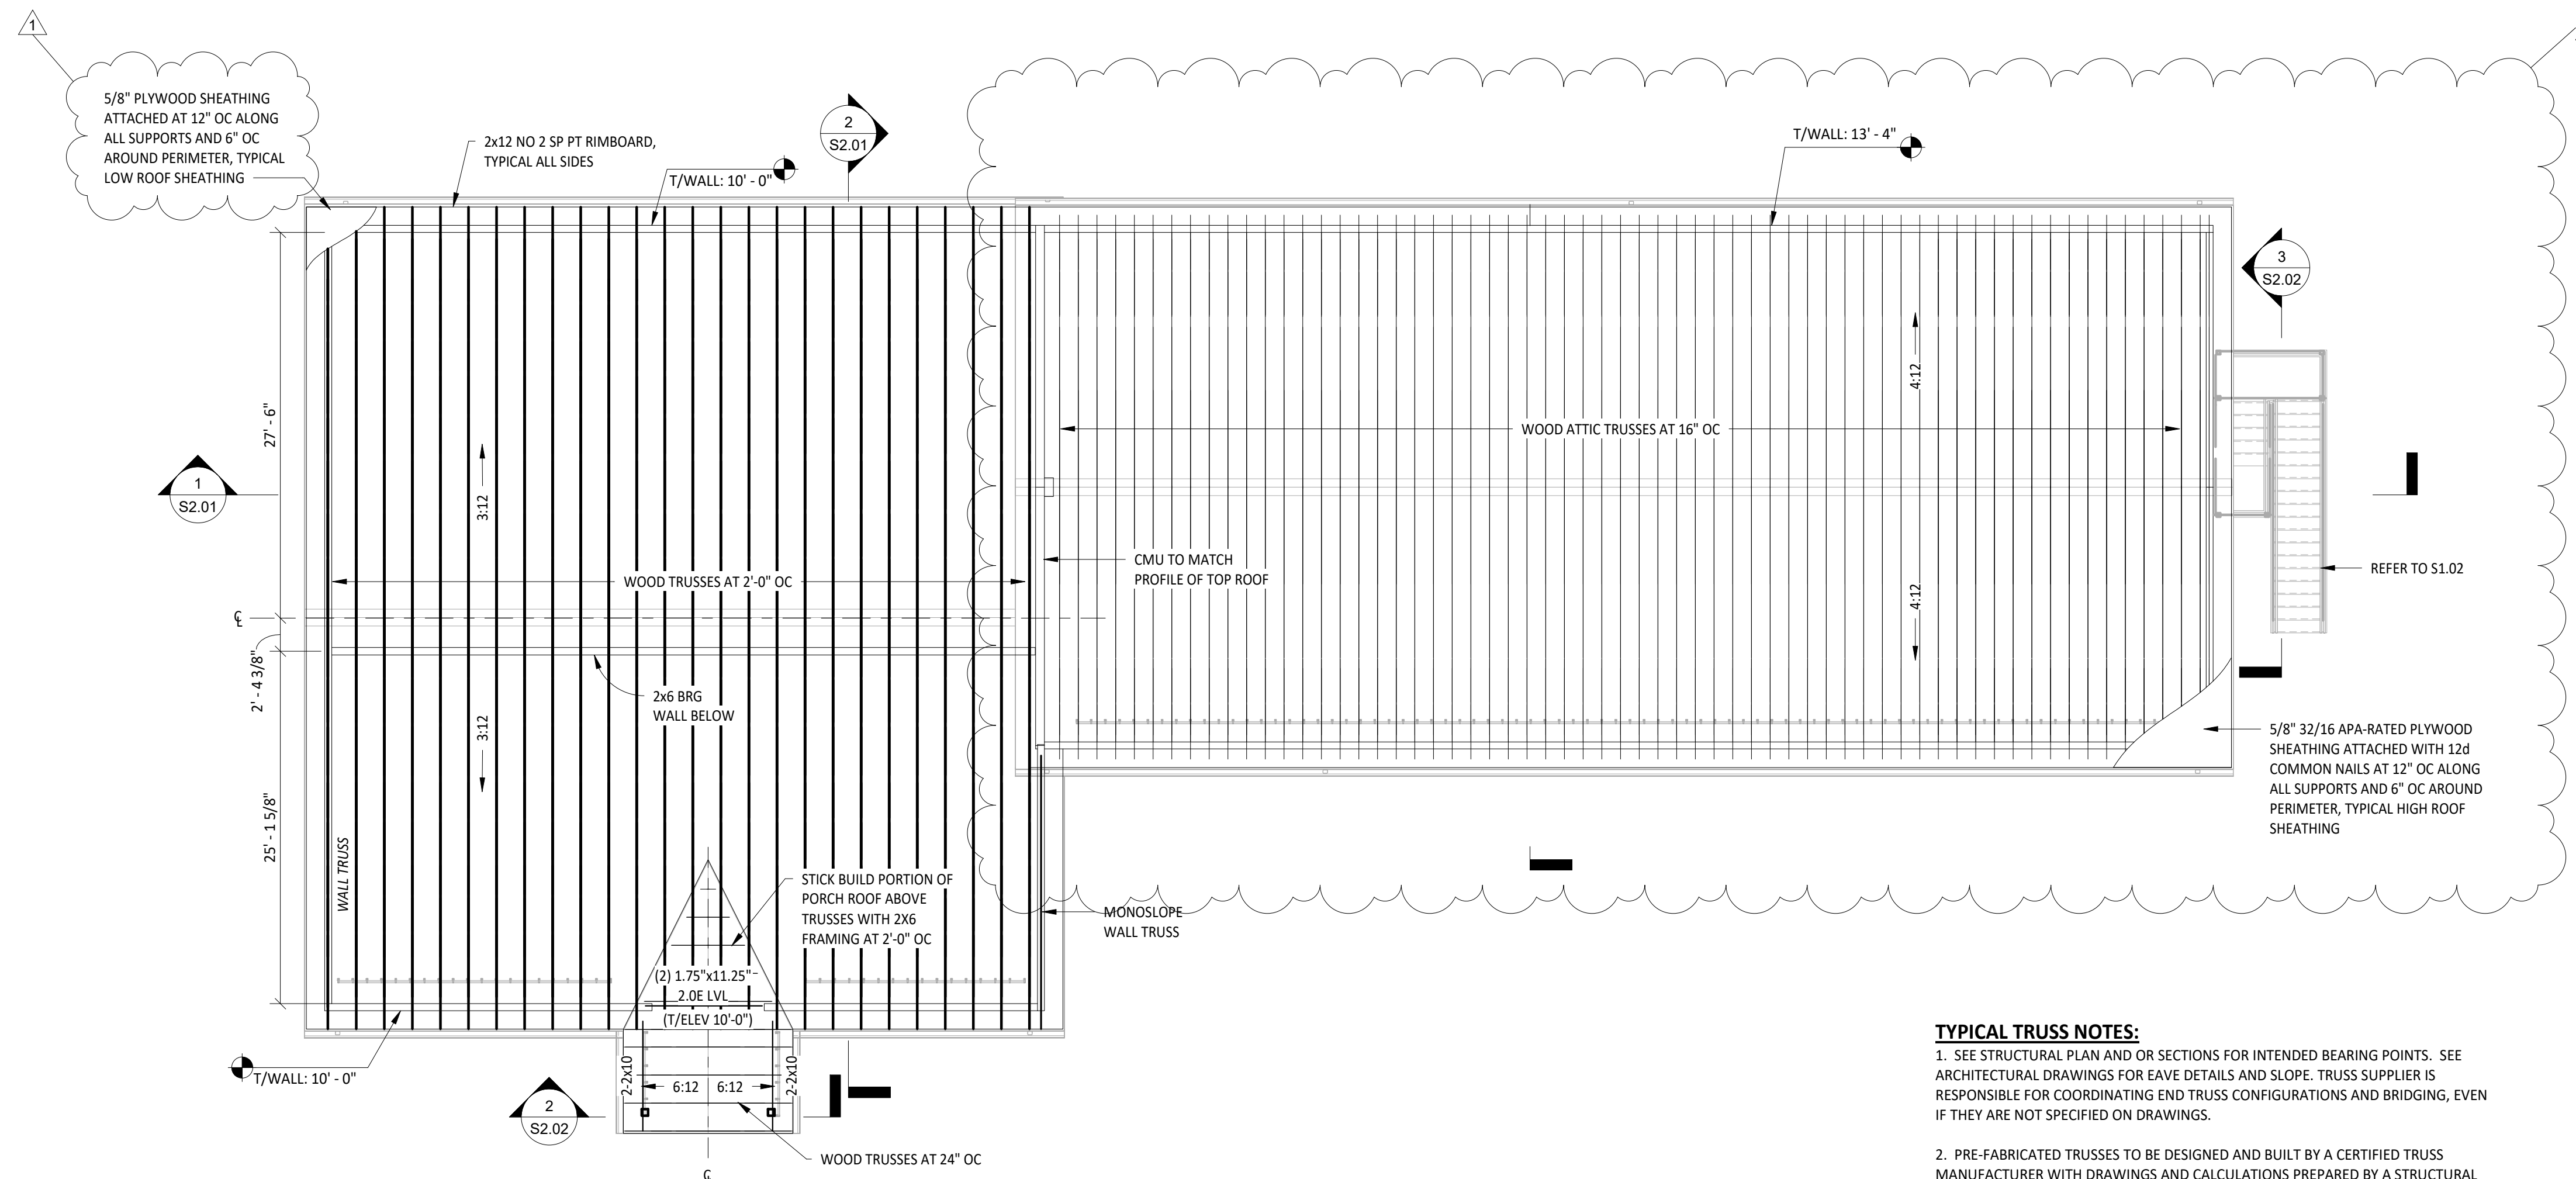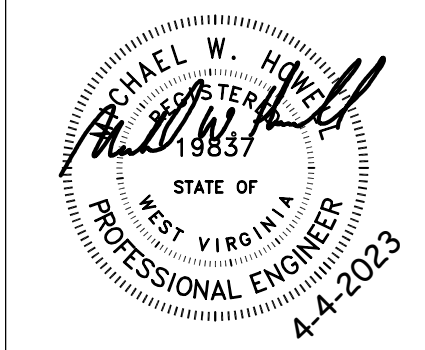

NOTES:

- 1) PROVIDE MINIMUM (2) 2x6 JACK STUDS AND (1) 2x6 KING STUD UNDER ALL BEAMS UNLESS NOTED OTHERWISE.
- 2) ALL INTERIOR CMU LINTELS SHALL BE 2L5x3.5x1/4 LLV UNLESS OTHERWISE NOTED.
- 3) ALL EXPOSED MASONRY IS INTENDED TO BE SPLIT-FACE. SEE ARCHITECTURAL DRAWINGS FOR MORE INFORMATION.
- 4) SEE ADDITIONAL NOTES ON S0.01 AND SPECIAL INSPECTIONS ON S0.02.
- 5) REFER TO DETAILS ON S5.00, S5.01, AND S5.02.

PLAN
ROOF FRAMING PLAN
SCALE: 1/8" = 1'-0"
NORTH

TYPICAL TRUSS NOTES:

1. SEE STRUCTURAL PLAN AND OR SECTIONS FOR INTENDED BEARING POINTS. SEE ARCHITECTURAL DRAWINGS FOR EAVE DETAILS AND SLOPE. TRUSS SUPPLIER IS RESPONSIBLE FOR COORDINATING END TRUSS CONFIGURATIONS AND BRIDGING, EVEN IF THEY ARE NOT SPECIFIED ON DRAWINGS.
2. PRE-FABRICATED TRUSSES TO BE DESIGNED AND BUILT BY A CERTIFIED TRUSS MANUFACTURER WITH DRAWINGS AND CALCULATIONS PREPARED BY A STRUCTURAL ENGINEER REGISTERED IN THE STATE WHERE THE PROJECT IS LOCATED AND SUBMITTED FOR REVIEW PRIOR TO FABRICATION OF WOOD TRUSSES.
3. THE REQUIREMENTS OF THE TRUSS PLATE INSTITUTE HIB-91 "COMMENTARY AND RECOMMENDATIONS FOR HANDLING, INSTALLING, AND BRACING OF METAL PLATE CONNECTED WOOD TRUSSES" SHALL GOVERN ALL BRACING, HANDLING, AND ERECTION OF TRUSSES.
4. TYPICAL ROOF TRUSS DESIGN LOADS (DOES NOT INCLUDE WEIGHT OF TRUSS):
 TOP CHORD DEAD LOAD 12 PSF
 TOP CHORD ROOF LIVE LOAD 20 PSF
 TOP CHORD SNOW LOAD 25 PSF
 BOTTOM CHORD DEAD LOAD 10 PSF
BOTTOM CHORD LIVE LOAD 125 PSF
 CONCENTRATED HVAC LOAD SEE MEP PLANS
5. TRUSS SUPPLIER IS ALSO RESPONSIBLE FOR COORDINATING THE REQUIREMENTS FOR NON-SPECIFIED CONCENTRATED LOADS SHOWN ON OTHER DISCIPLINES DRAWINGS.
6. ALL ATTACHMENTS AND HANGERS MUST BE ENGINEERED AND DESIGNED BY THE TRUSS SUPPLIER AND PROVIDED AS PART OF THE TRUSS SUBMITTAL PACKAGE.

| NO. | BY | DATE | DESCRIPTION |
|-----|----|----------|-------------|
| 1 | | 4.4.2023 | Addendum #3 |

BROOKE COUNTY EMS
BROOKE COUNTY COMMISSION
BROOKE COUNTY, WV
4.4.2023
Construction Drawings


DRAWN: PFB DATE: 4/4/2023
CHECKED: PFB DATE: 4/4/2023
APPROVED: MWH DATE: 4/4/2023

PROJECT No. T60-11009.00


ROOF PLAN

SHEET No.

S1.03

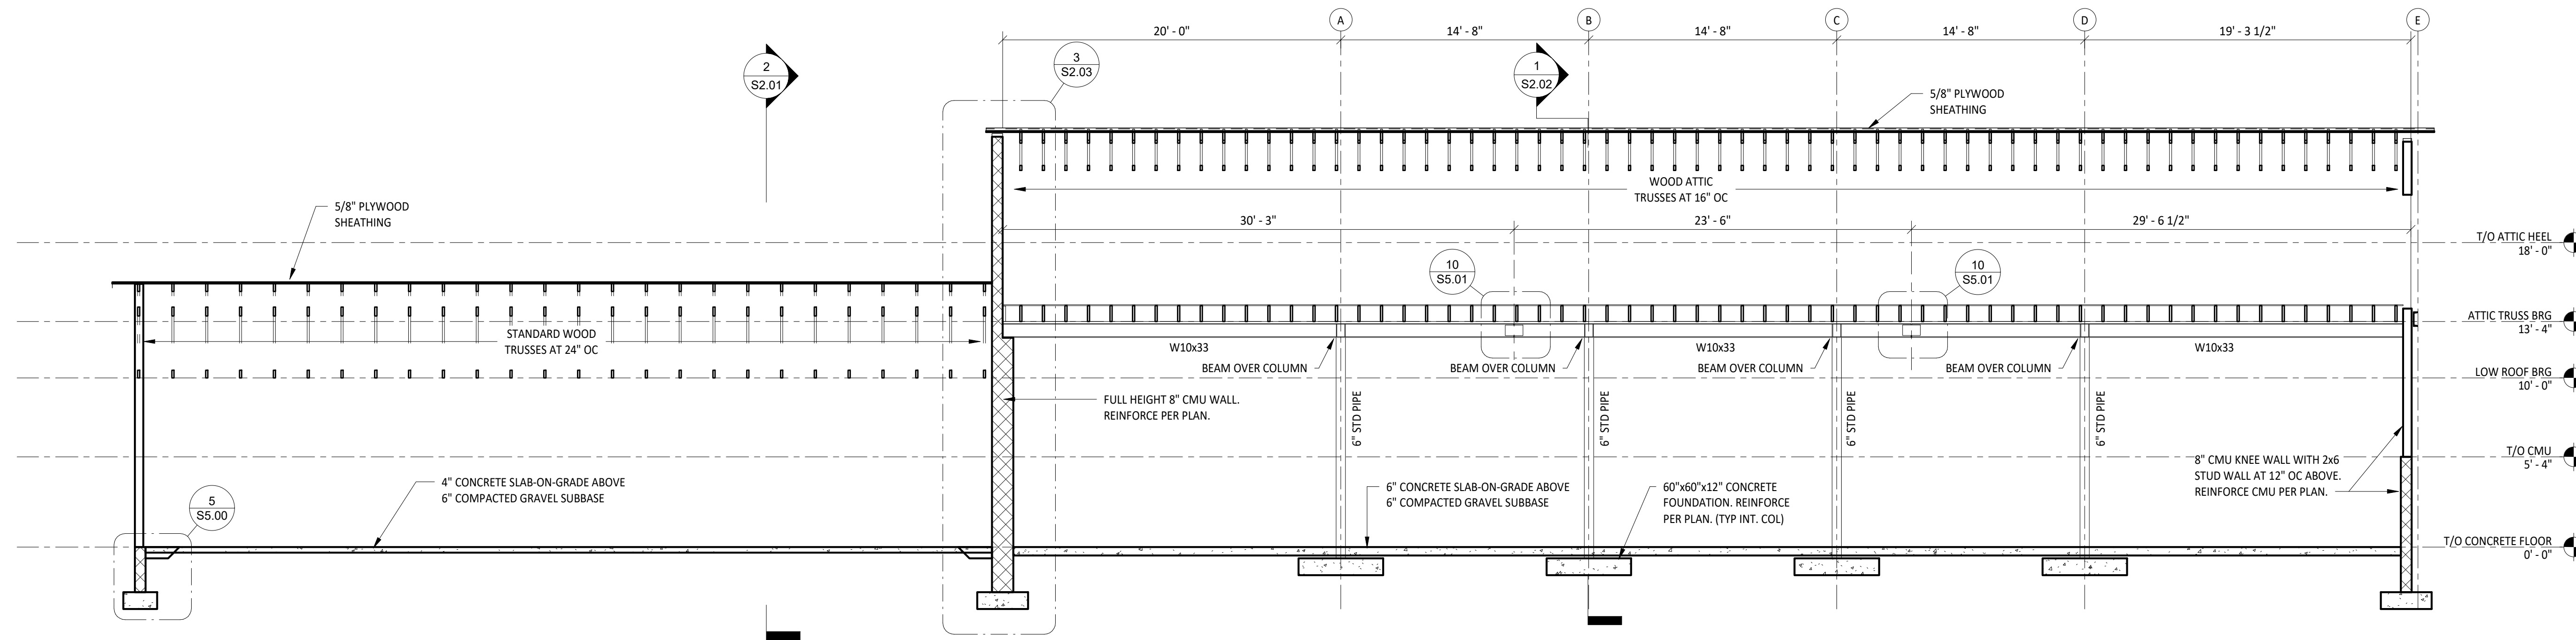

1 LONGITUDINAL SECTION
SCALE: 3/16" = 1'-0"

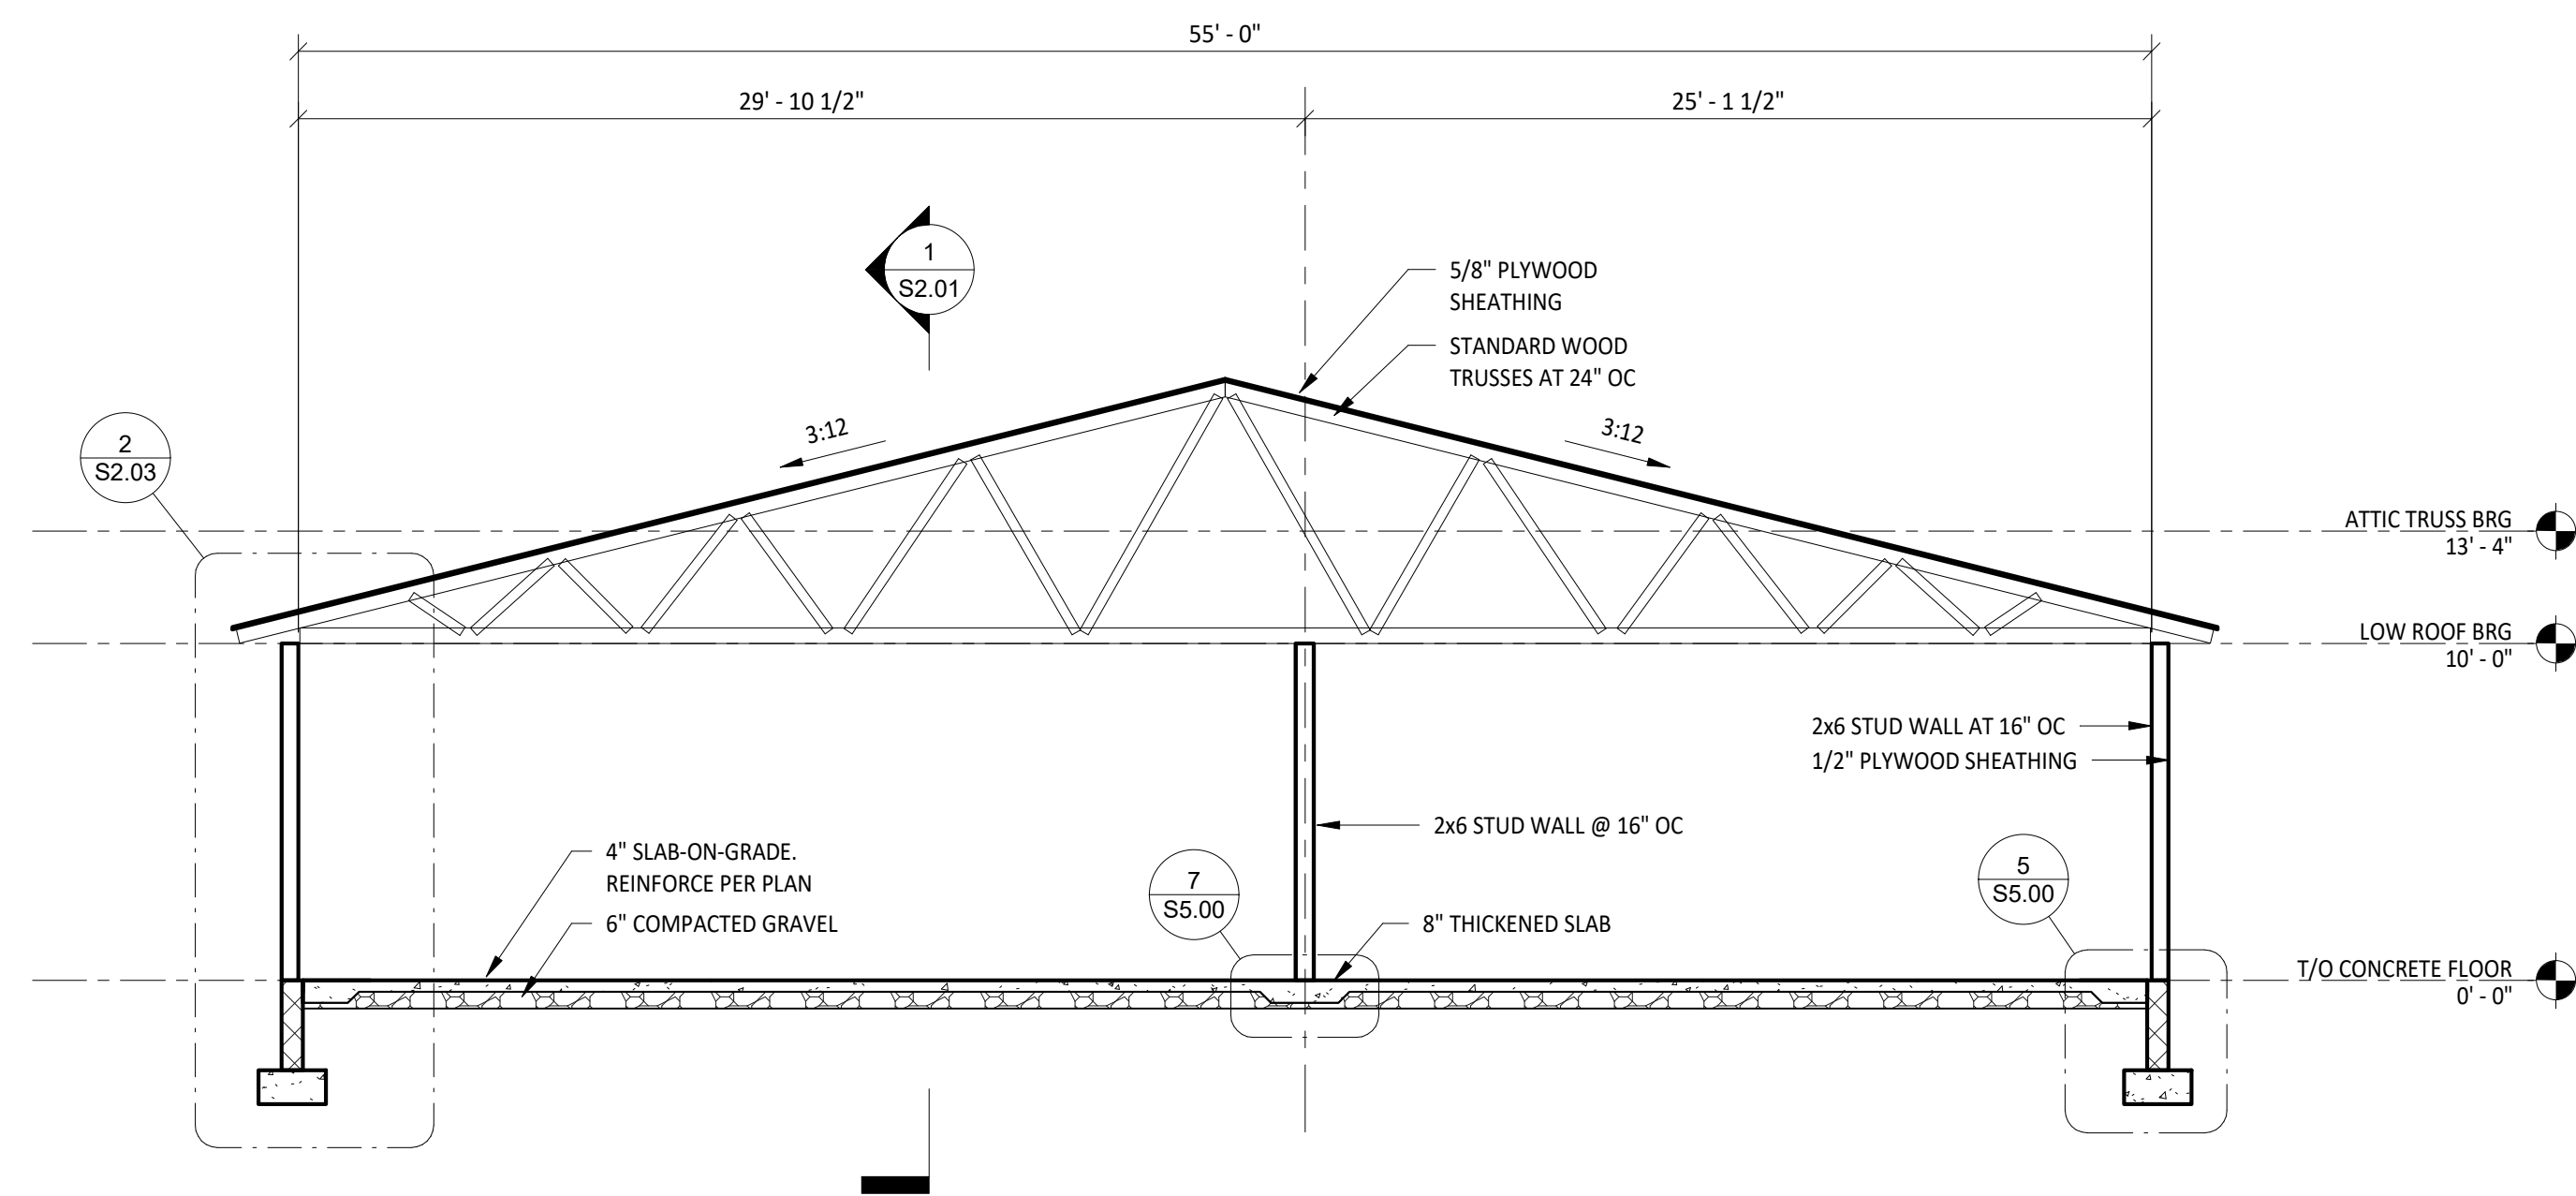

2 RESIDENCE CROSS SECTION
SCALE: 3/16" = 1'-0"

| NO. | BY | DATE | DESCRIPTION |
|-----|----|------|-------------|
| 1 | | | |

BROOKE COUNTY EMS
BROOKE COUNTY COMMISSION
BROOKE COUNTY, WV
4.4.2023
Construction Drawings

DRAWN: PFB DATE: 4/4/2023
CHECKED: PFB DATE: 4/4/2023
APPROVED: MWH DATE: 4/4/2023

PROJECT No. T60-11009.00

BUILDING SECTIONS

SHEET No.

S2.01

METAL STAIRS STANDARDS

Metal Stairs Shall Conform to the Following:

ASTM A 6/A 6M - Standard Specification for General Requirements for Rolled Structural Steel Bars, Plates, Shapes, and Sheet Piling; 2009.

ASTM A 36/A 36M - Standard Specification for Carbon Structural Steel; 2008.

ASTM A 53/A 53M - Standard Specification for Pipe, Steel, Black and Hot-Dipped, Zinc-Coated, Welded and Seamless; 2007.

ASTM A 283/A 283M - Standard Specification for Low and Intermediate Tensile Strength Carbon Steel Plates; 2003 (Reapproved 2007).

ASTM A 325 - Standard Specification for Structural Bolts, Steel, Heat Treated, 120/105 ksi Minimum Tensile Strength; 2009a.

ASTM A 500/A 500M - Standard Specification for Cold-Formed Welded and Seamless Carbon Steel Structural Tubing in Rounds and Shapes; 2010.

ASTM A 501 - Standard Specification for Hot-Formed Welded and Seamless Carbon Steel Structural Tubing; 2007.

ASTM E 985 - Standard Specification for Permanent Metal Railing Systems and Rails for Buildings; 2000 (Reapproved 2006).

AWS A2.4 - Standard Symbols for Welding, Brazing, and Nondestructive Examination; American Welding Society; 2007.

AWS D1.1/D1.1M - Structural Welding Code - Steel; American Welding Society; 2010.

ASTM A123/A123M - Standard Specification for Zinc (Hot-Dipped Galvanized) Coatings on Iron and Steel Products

ANSI/NAAMM MBG 531 - Metal Bar Grating Manual; 2017

Submittals:

Shop Drawings:

Indicate profiles, sizes, connection attachments, reinforcing, anchorage, size and type of fasteners, and accessories.
Indicate welded connections using standard AWS A2.4 welding symbols. Indicate net weld lengths.

Include the design engineer's stamp or seal on each sheet of shop drawings.

Welders' Certificates:

Quality Assurance:

Structural Designer Qualifications:

Professional Structural Engineer experienced in design of this work and licensed in West Virginia, or personnel under direct supervision of such an engineer.

Welder Qualifications:

Show certification of welders employed on the Work, verifying AWS qualification within the previous 12 months.

Products:

Metal Stairs:

Provide stairs of the design specified, complete with landing platforms, vertical and horizontal supports, railings, and guards, fabricated accurately for anchorage to each other and to building structure.

Stairs Treads:

Provide open tread grating for all stairs and landing
Basis of design: Type W-19 with dimple nosing at stair treads

Provide connections, details, and design based on specifications and requirements set by NAAMM MBG 531

Regulatory Requirements:

Provide stairs and railings complying with the most stringent requirements of local, state, and federal regulations; where requirements of the contract documents exceed those of regulations, comply with the contract documents.

Structural Design:

Provide complete stair and railing assemblies complying with the following:

Stair Capacity:

Uniform live load of 100 lb/sq ft and a concentrated load of 300 lb with deflection of stringer or landing framing not to exceed 1/360 of span.

Railing Assemblies:

Comply with ASTM E 985.

At exit stairwells, provide unit stair towers designed for stacking to height of building as a self-supporting structure.

Railing Assemblies:

Comply with ASTM E 985.


Finishes:

Galvanizing of Structural Steel Members:


Galvanize after fabrication to ASTM A123/A123M requirements. Provide minimum 1.7 oz/sq. ft. galvanized coating.

Clean surfaces of rust, grease, and foreign matter prior to finishing.


Touch up primer for galvanized surfaces: SSPC-Paint 20, Type I - Inorganic, complying with VOC limitation of authorities having jurisdiction.

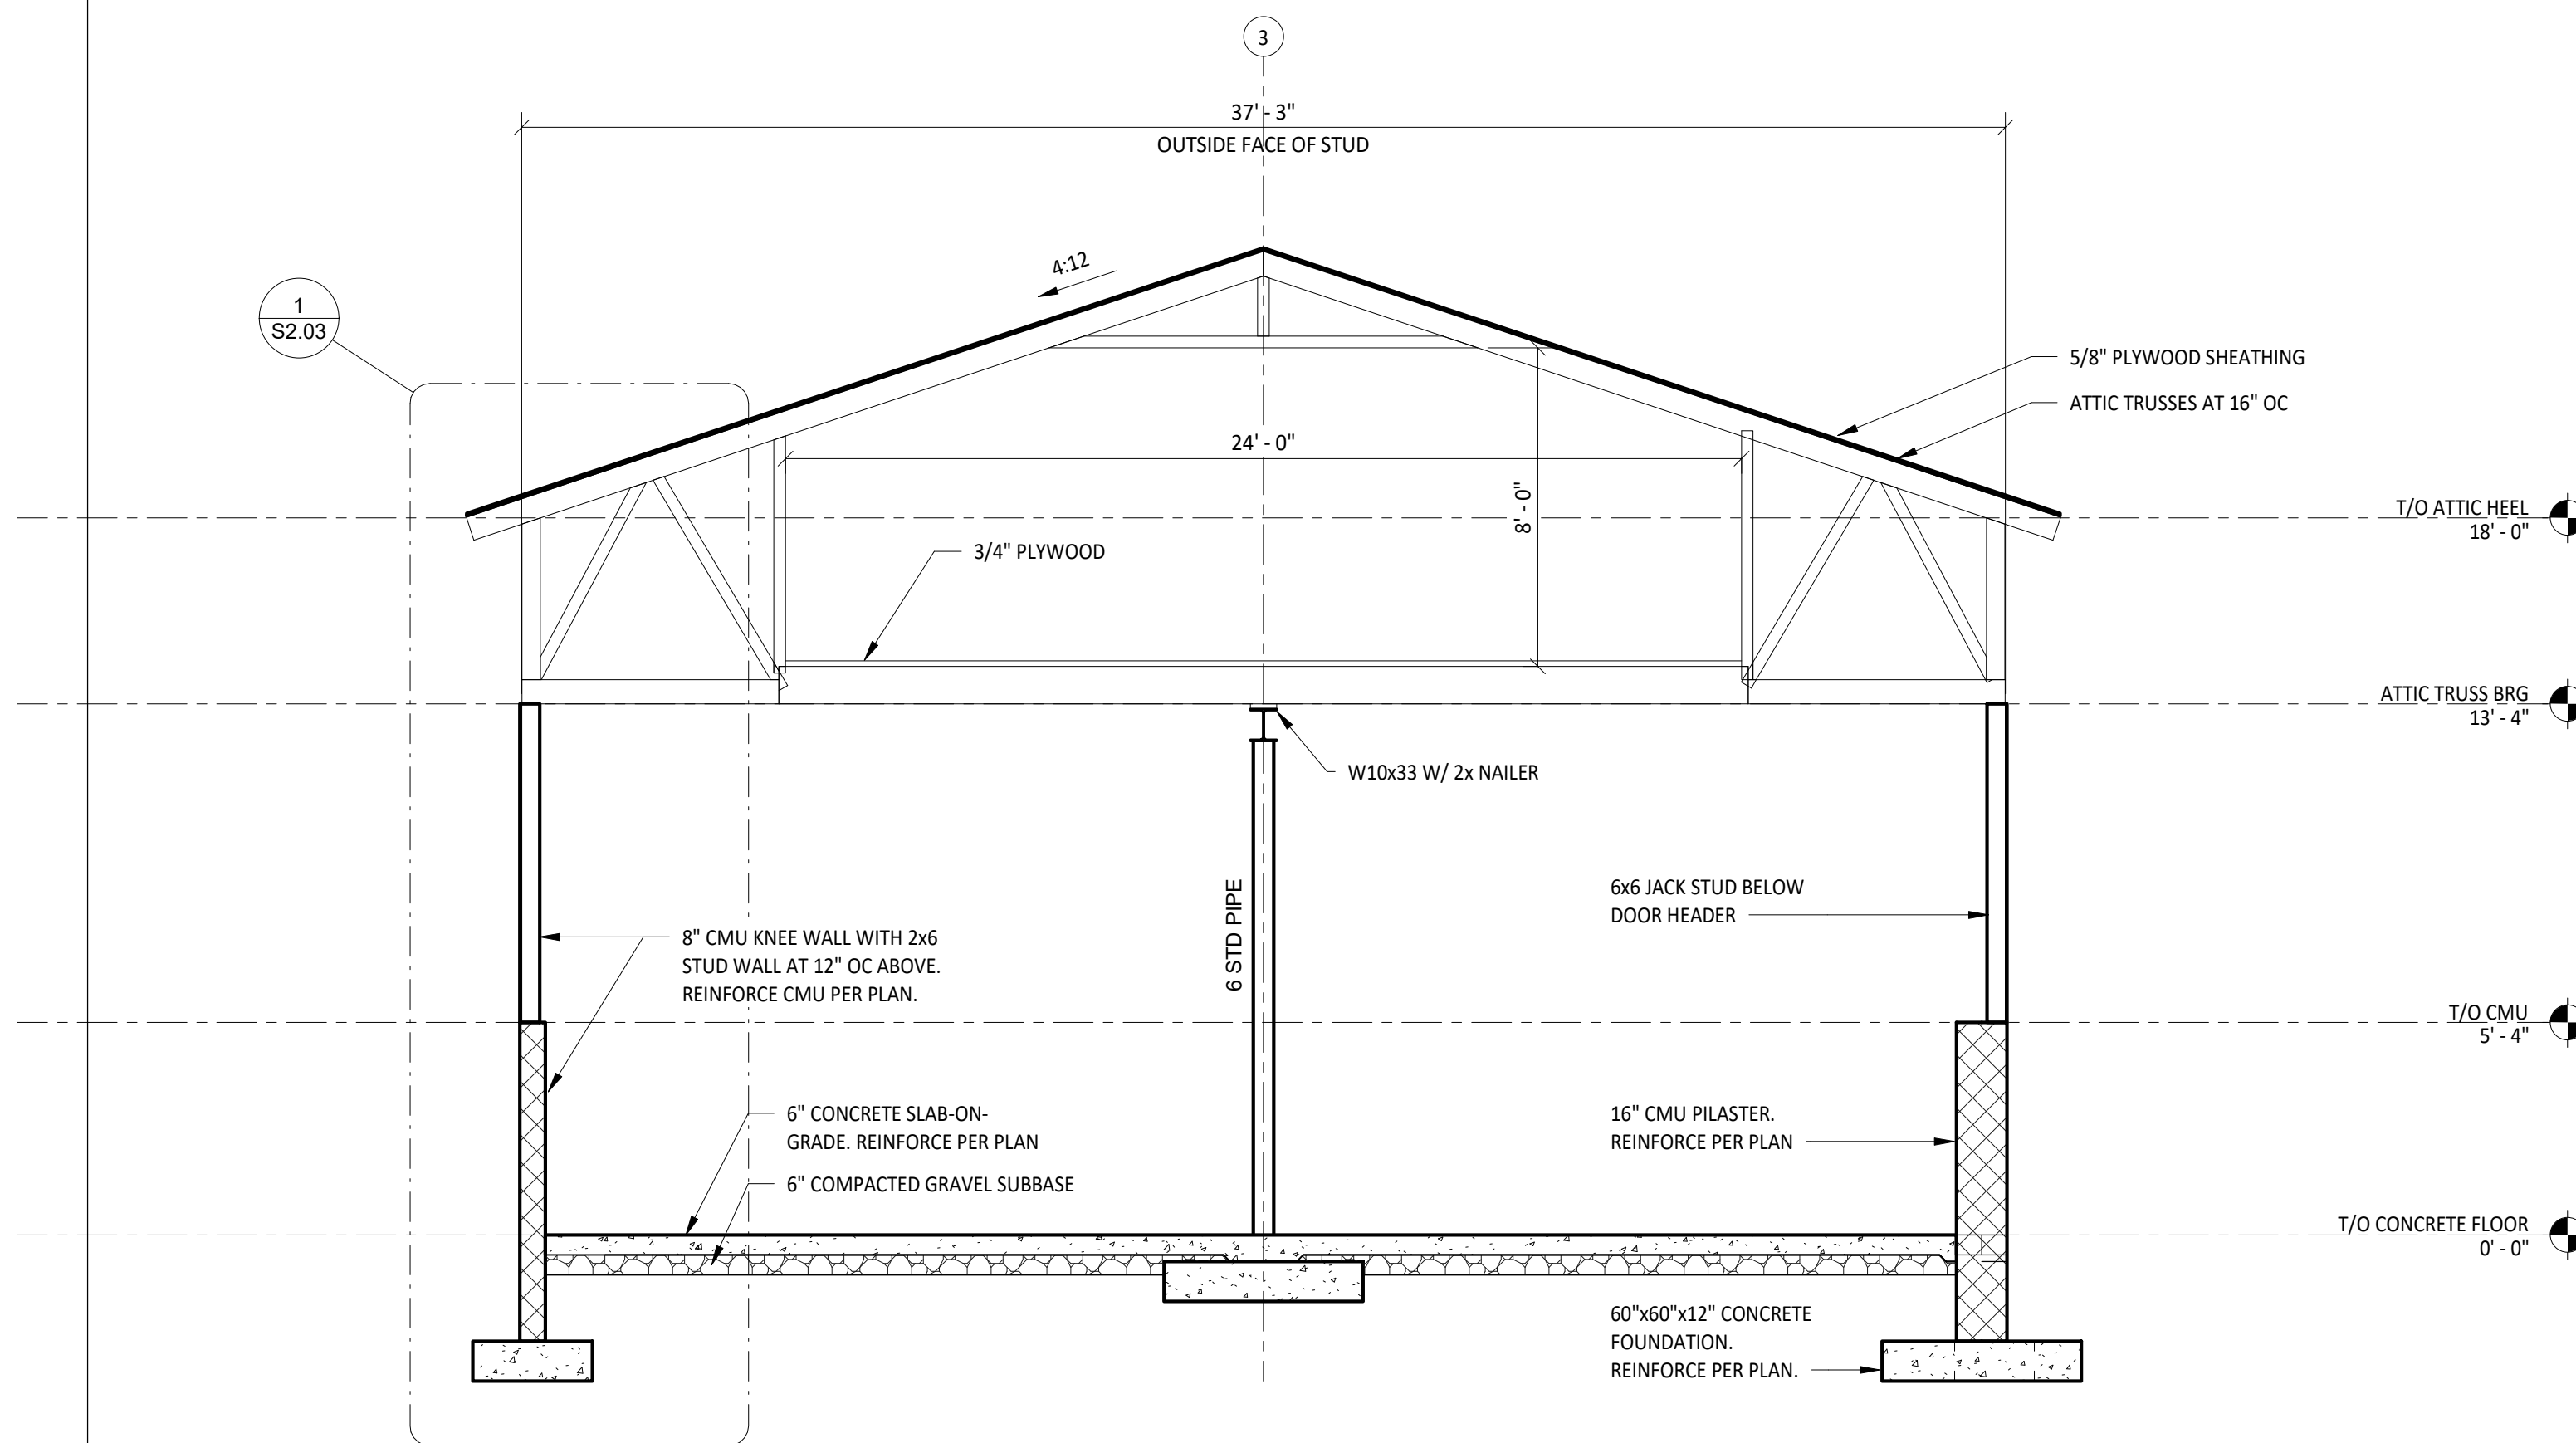

1 APPARATUS BAY CROSS SECTION
SCALE: 1/4" = 1'-0"
NOTES:
1) REFER TO TRUSS NOTES ON S1.03

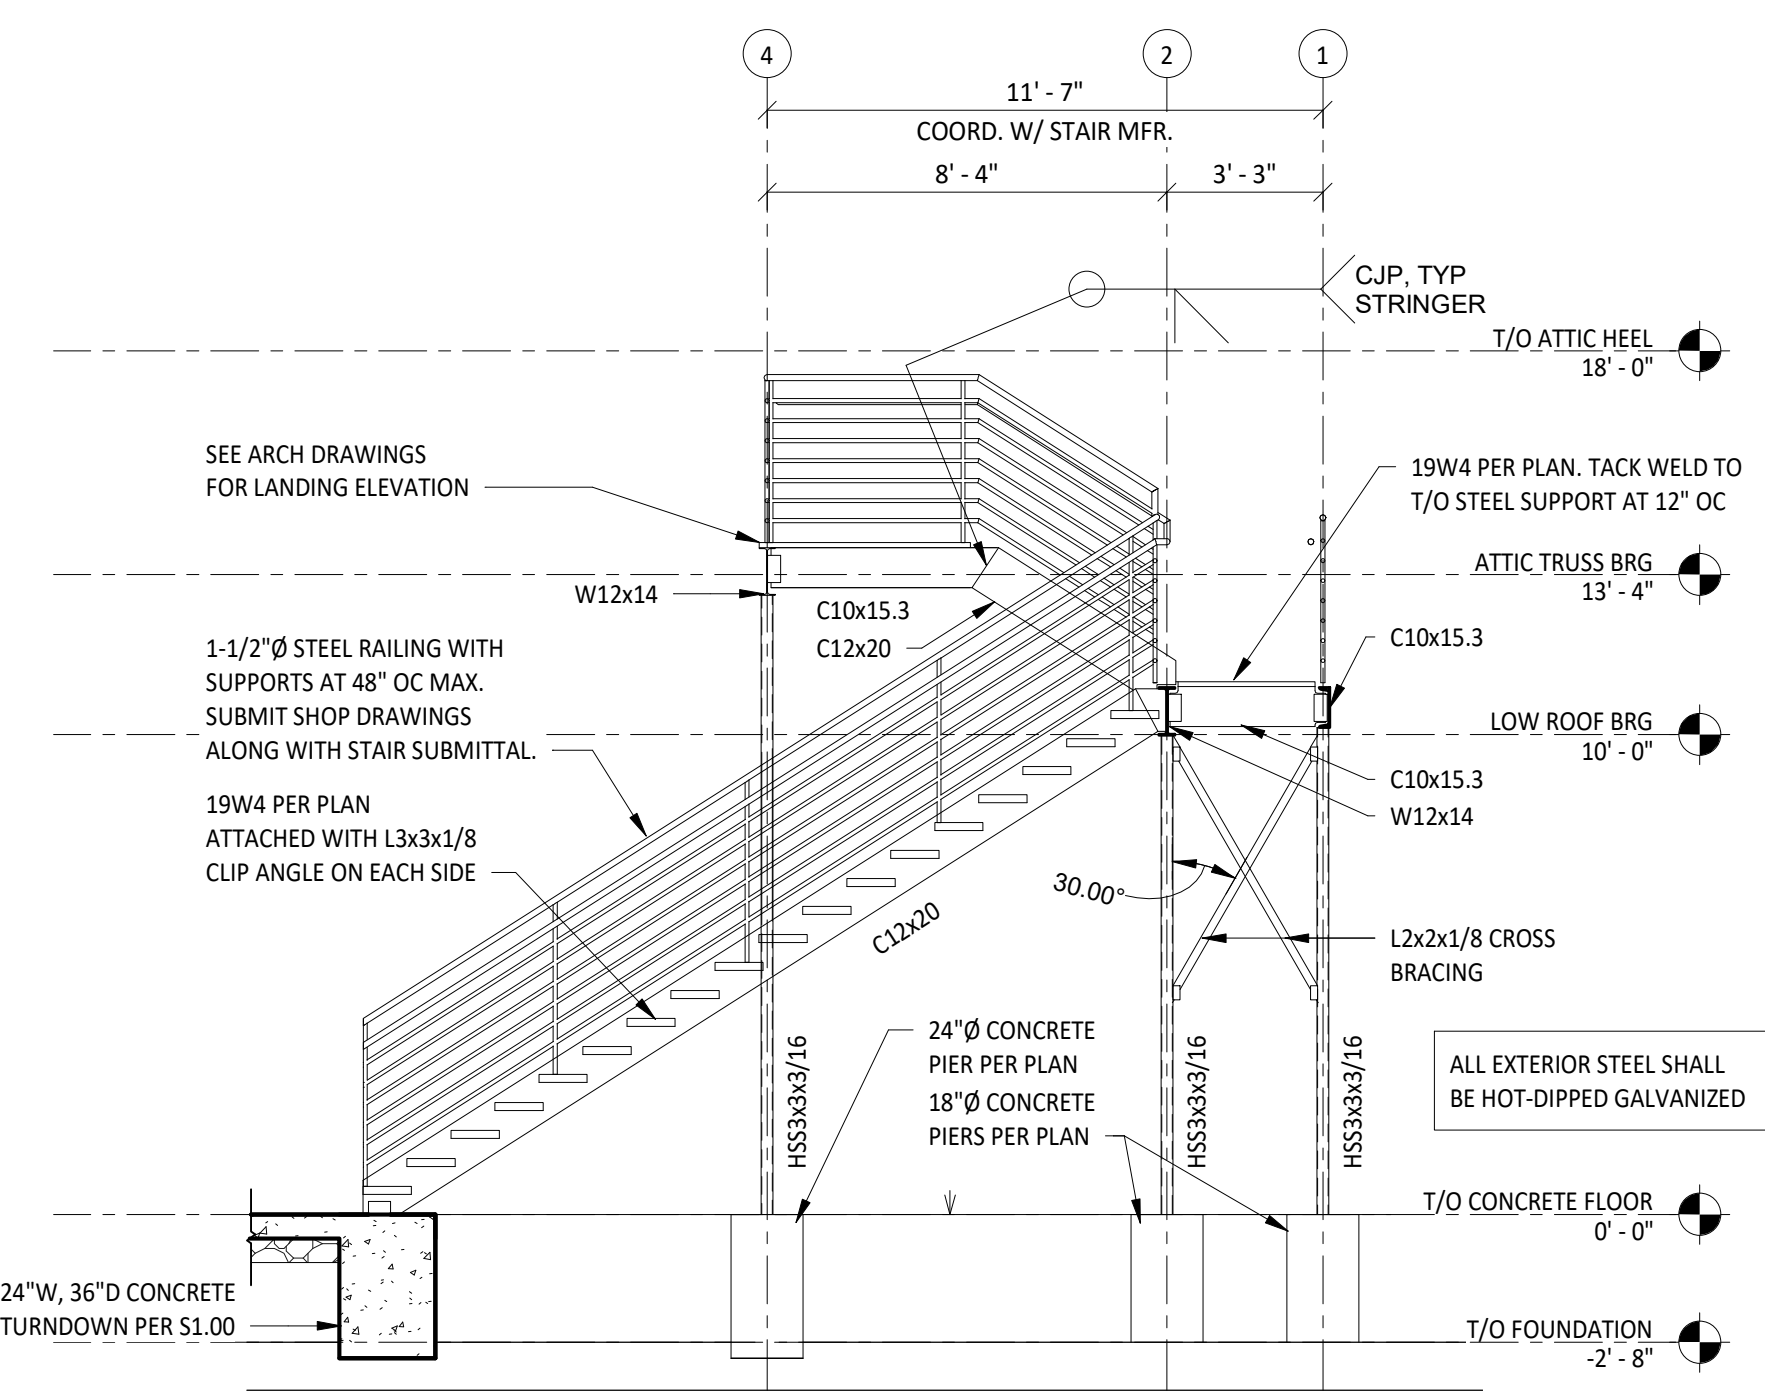

3 EXTERIOR STAIR CROSS SECTION
SCALE: 1/4" = 1'-0"

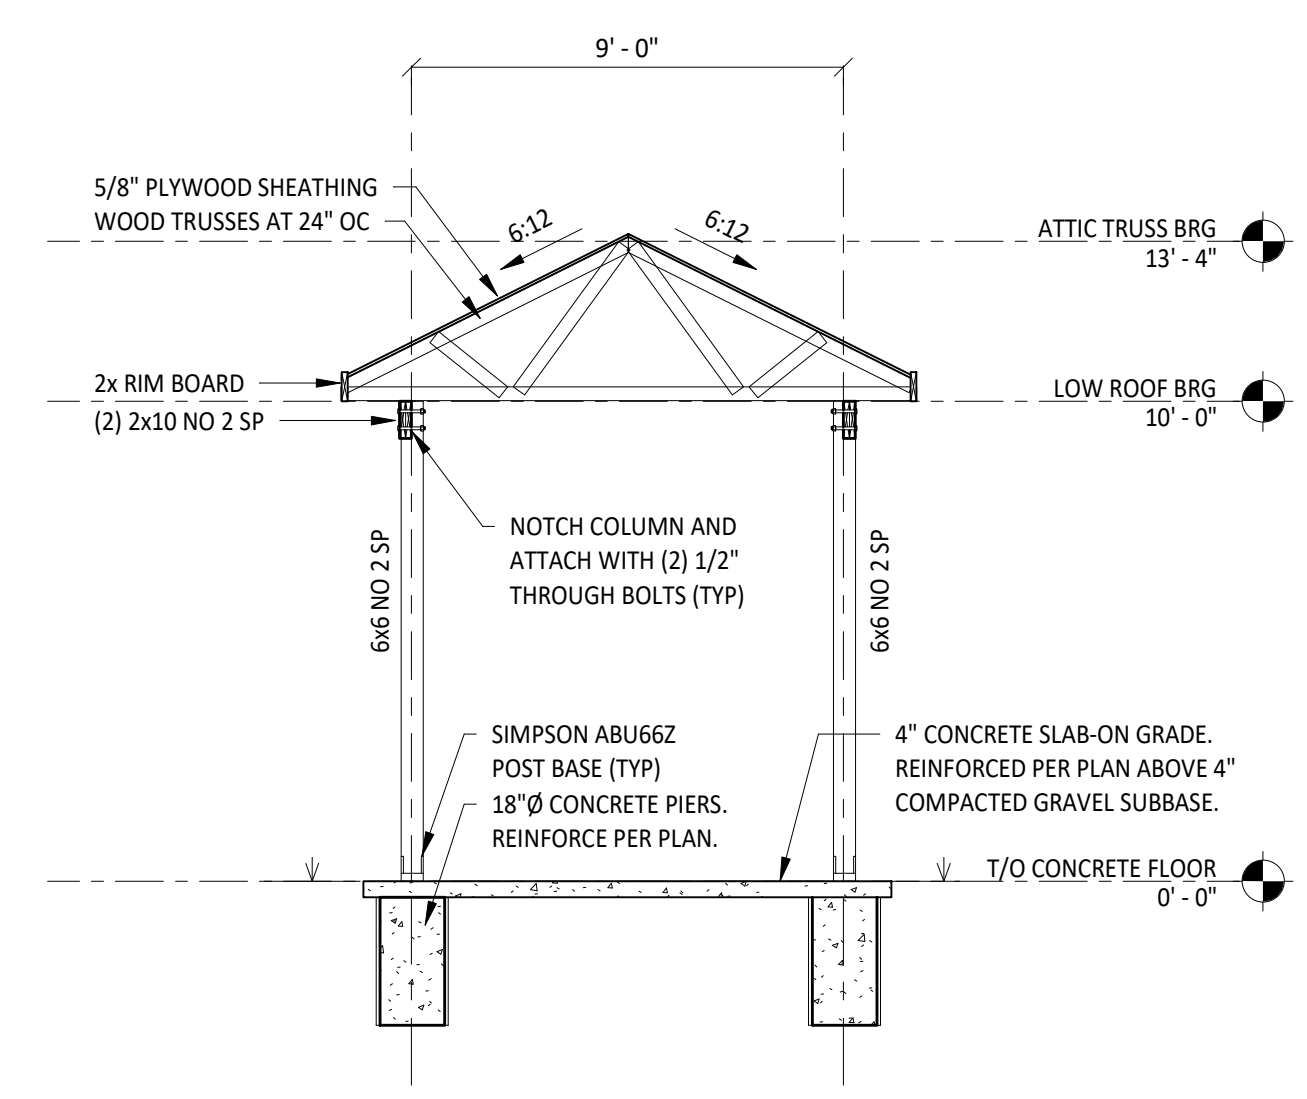

2 FRONT ENTRANCE SECTION
SCALE: 1/4" = 1'-0"

| NO. | BY | DATE | DESCRIPTION |
|-----|----|------|-------------|
| 1 | | | |

BROOKE COUNTY EMS
BROOKE COUNTY COMMISSION
BROOKE COUNTY, WV
4-4-2023
Construction Drawings

DRAWN: PFB DATE: 4/4/2023
CHECKED: PFB DATE: 4/4/2023
APPROVED: MWH DATE: 4/4/2023

PROJECT No. T60-11009.00

BUILDING SECTIONS

SHEET No. **S2.02**

| NO. | BY | DATE | DESCRIPTION |
|-----|----|------|-------------|
| 1 | | | |

BROOKE COUNTY EMS
BROOKE COUNTY COMMISSION
BROOKE COUNTY, WV
4.4.2023
Construction Drawings

DRAWN: PFB DATE: 4/4/2023
CHECKED: PFB DATE: 4/4/2023
APPROVED: MWH DATE: 4/4/2023


PROJECT No. T60-11009.00

WALL SECTIONS


SHEET No.

S2.03


LAYOUT TAB WALL SECTIONS PLOT DATE/TIME: 4/4/2023 10:00:00 AM USER: PFB PROJECT: 20221215_Thrasher - Broke EMS@wv.thrasher.com

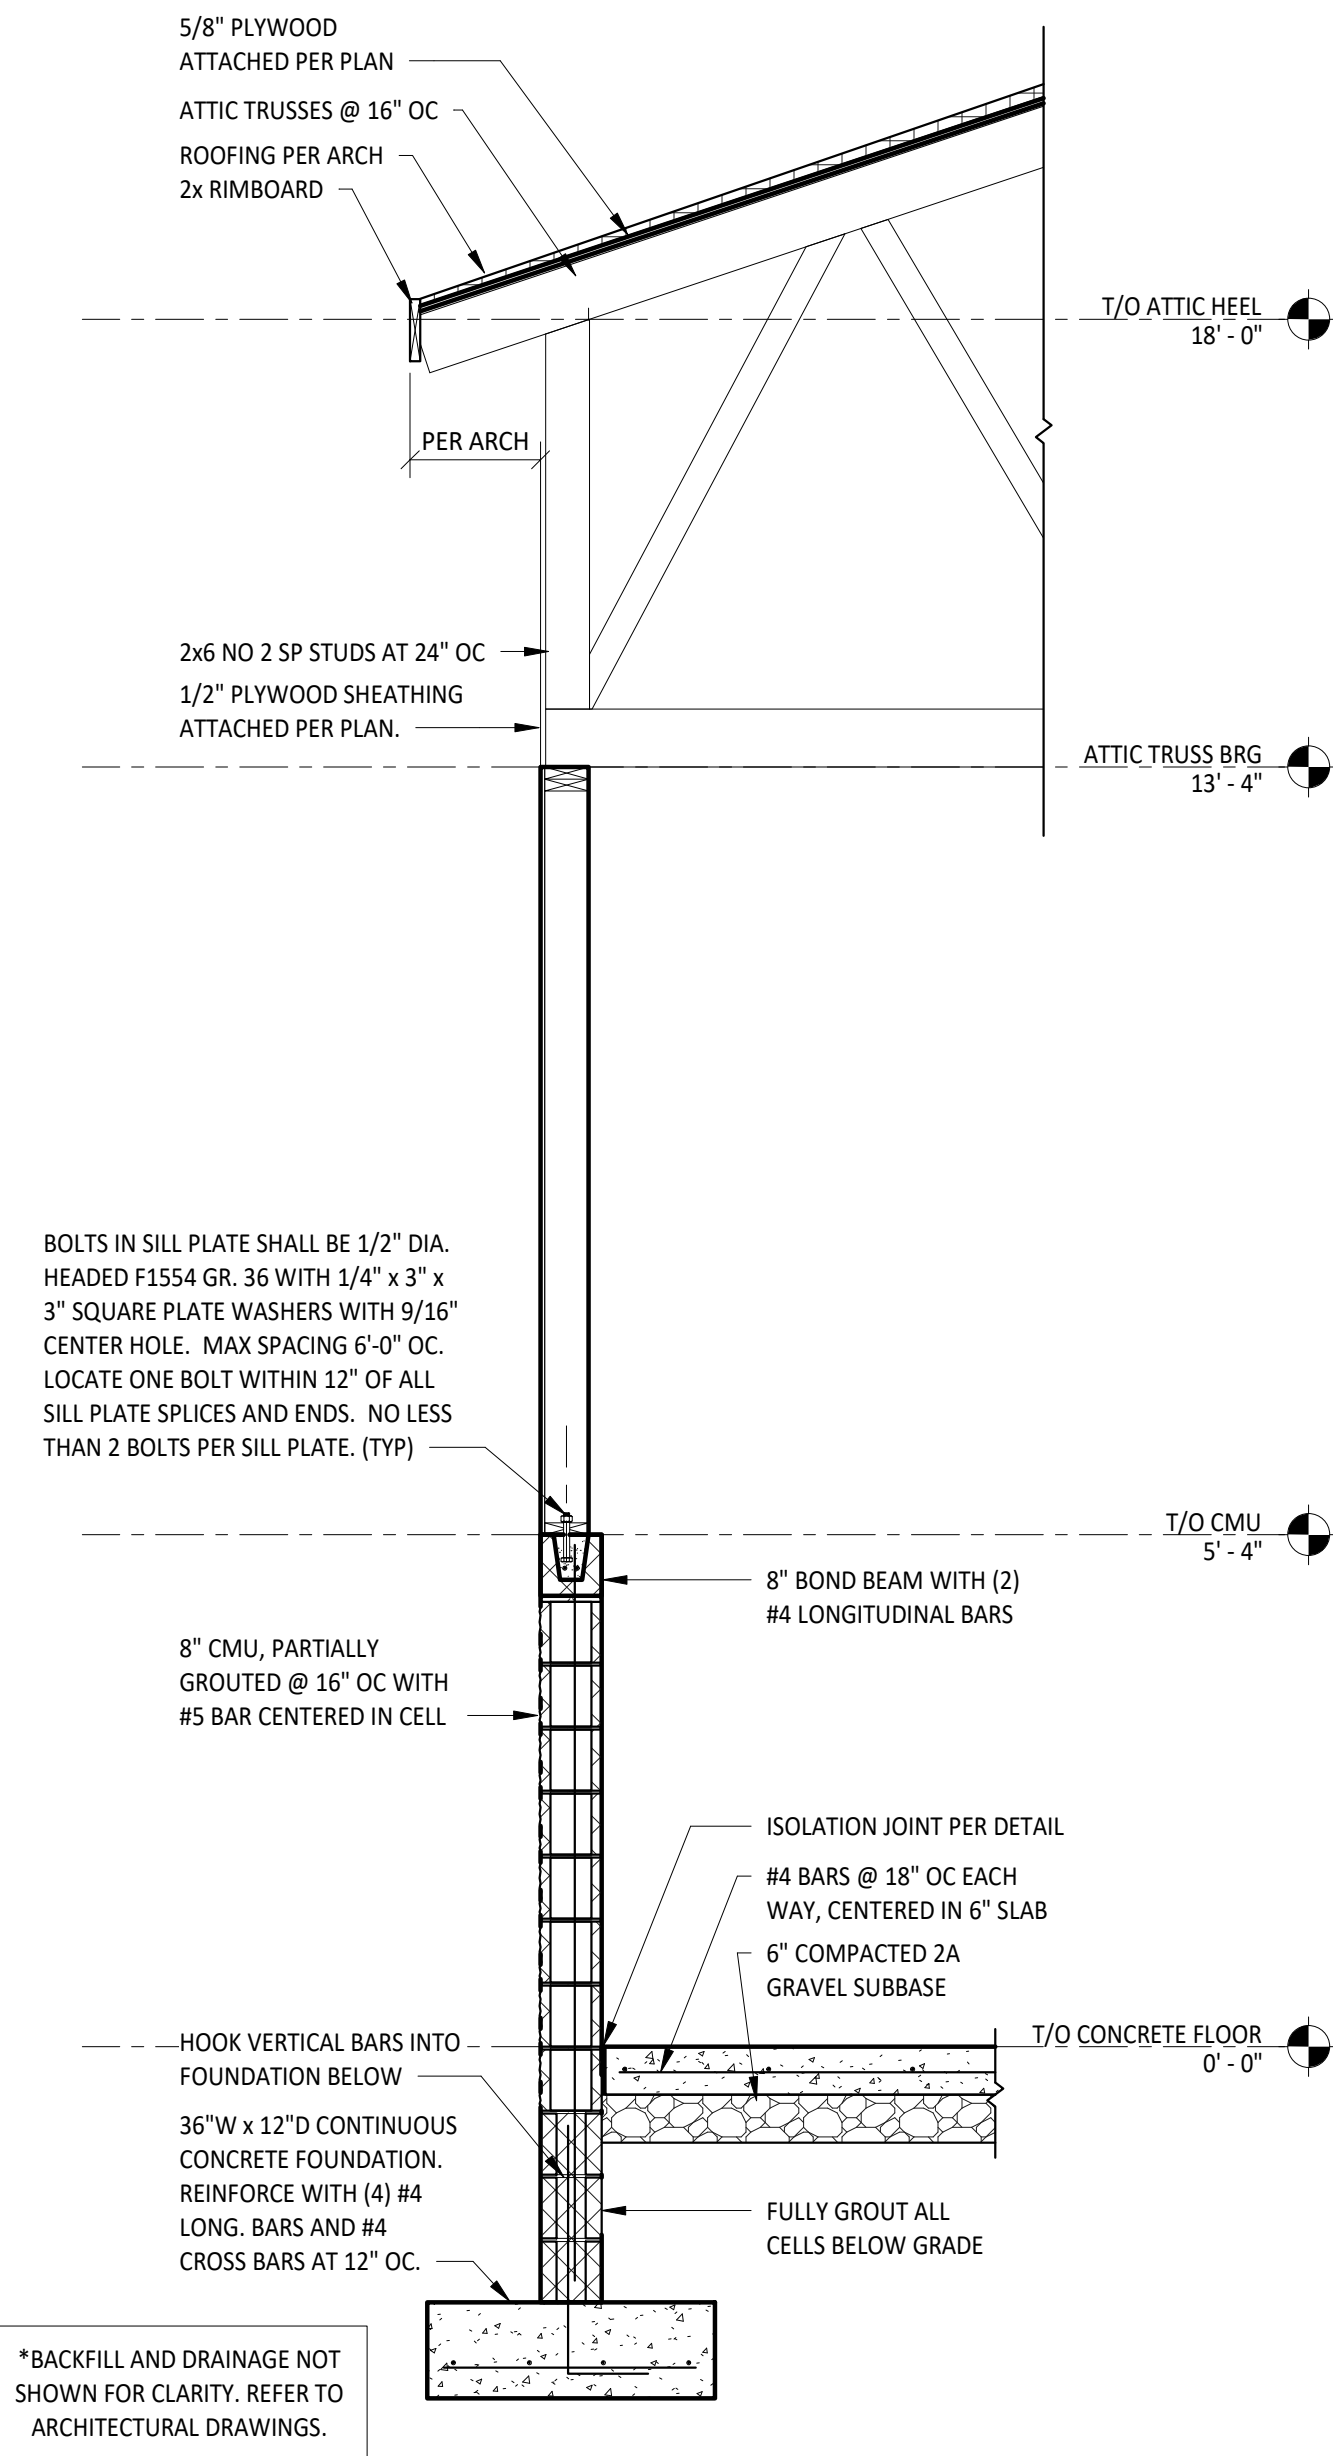


1 APPARATUS BAY WALL SECTION
SCALE: 1/2" = 1'-0"

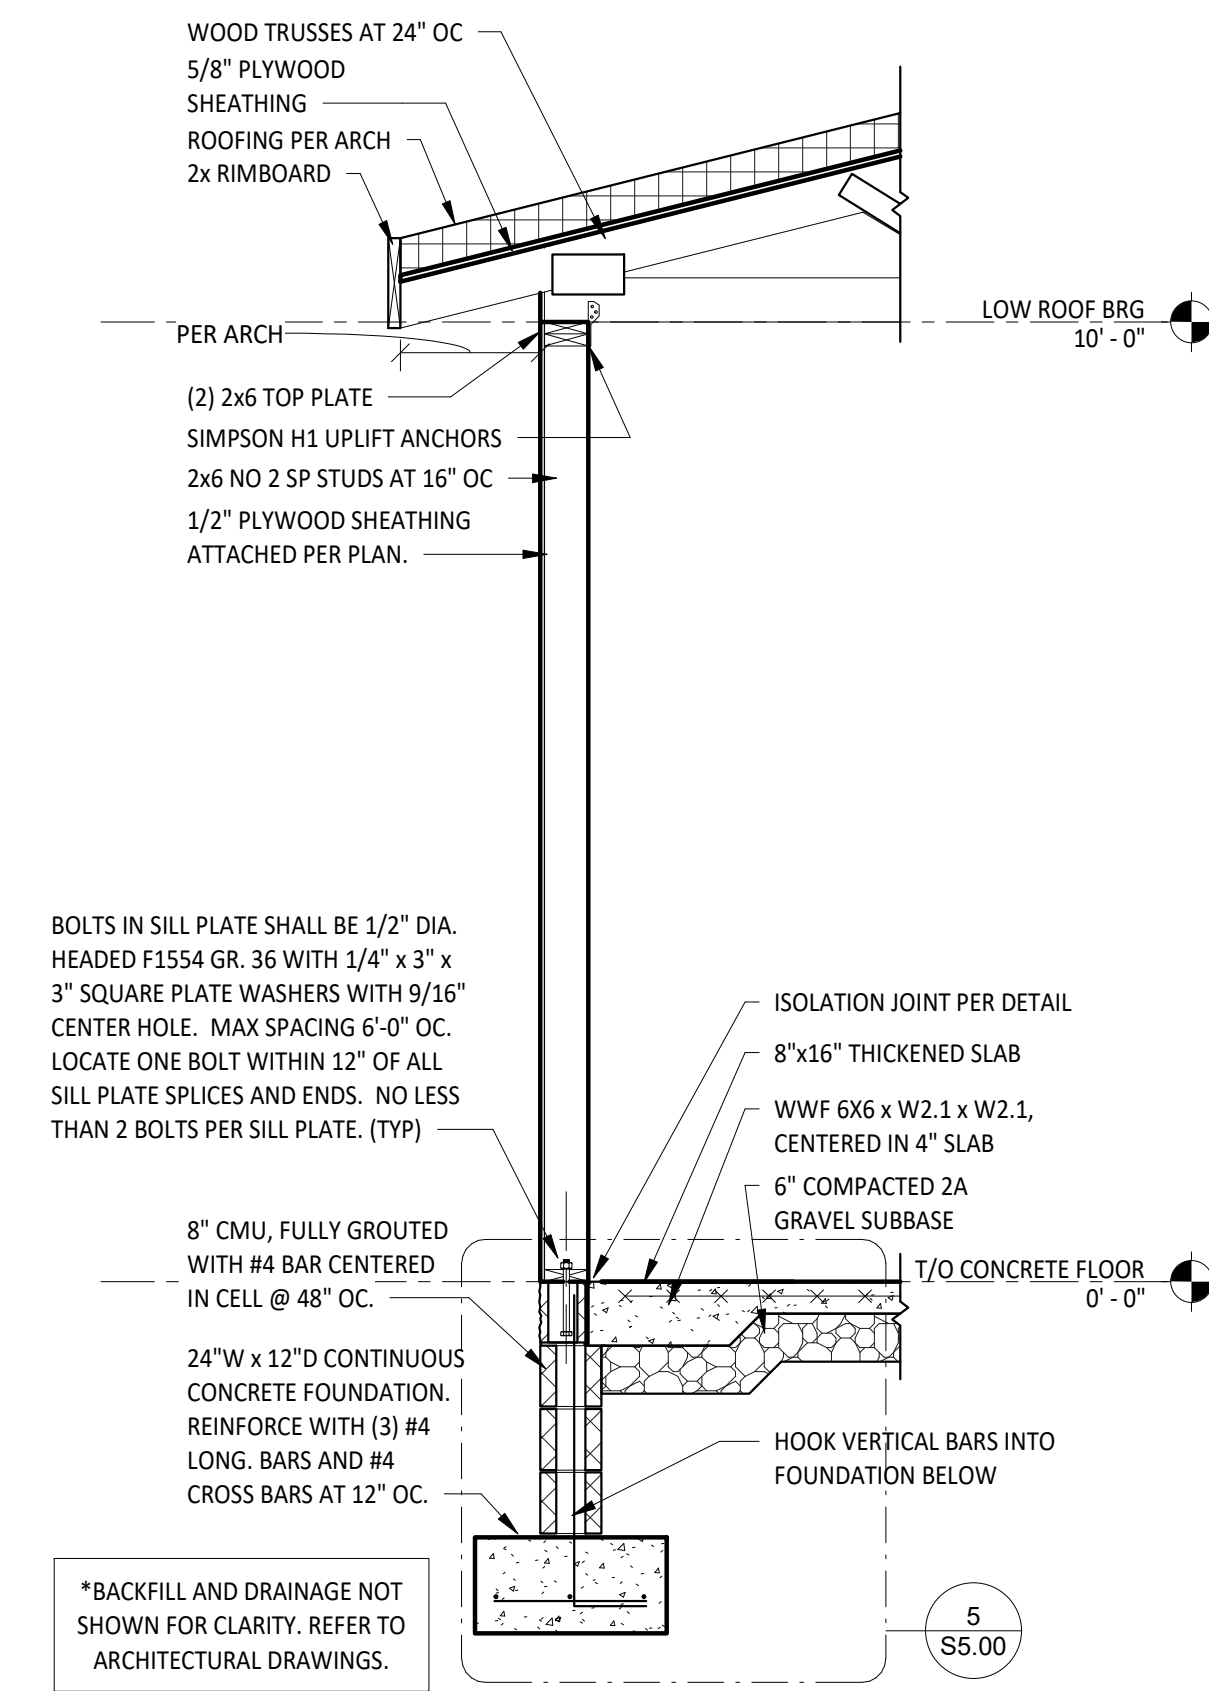

2 RESIDENCE WALL SECTION
SCALE: 1/2" = 1'-0"

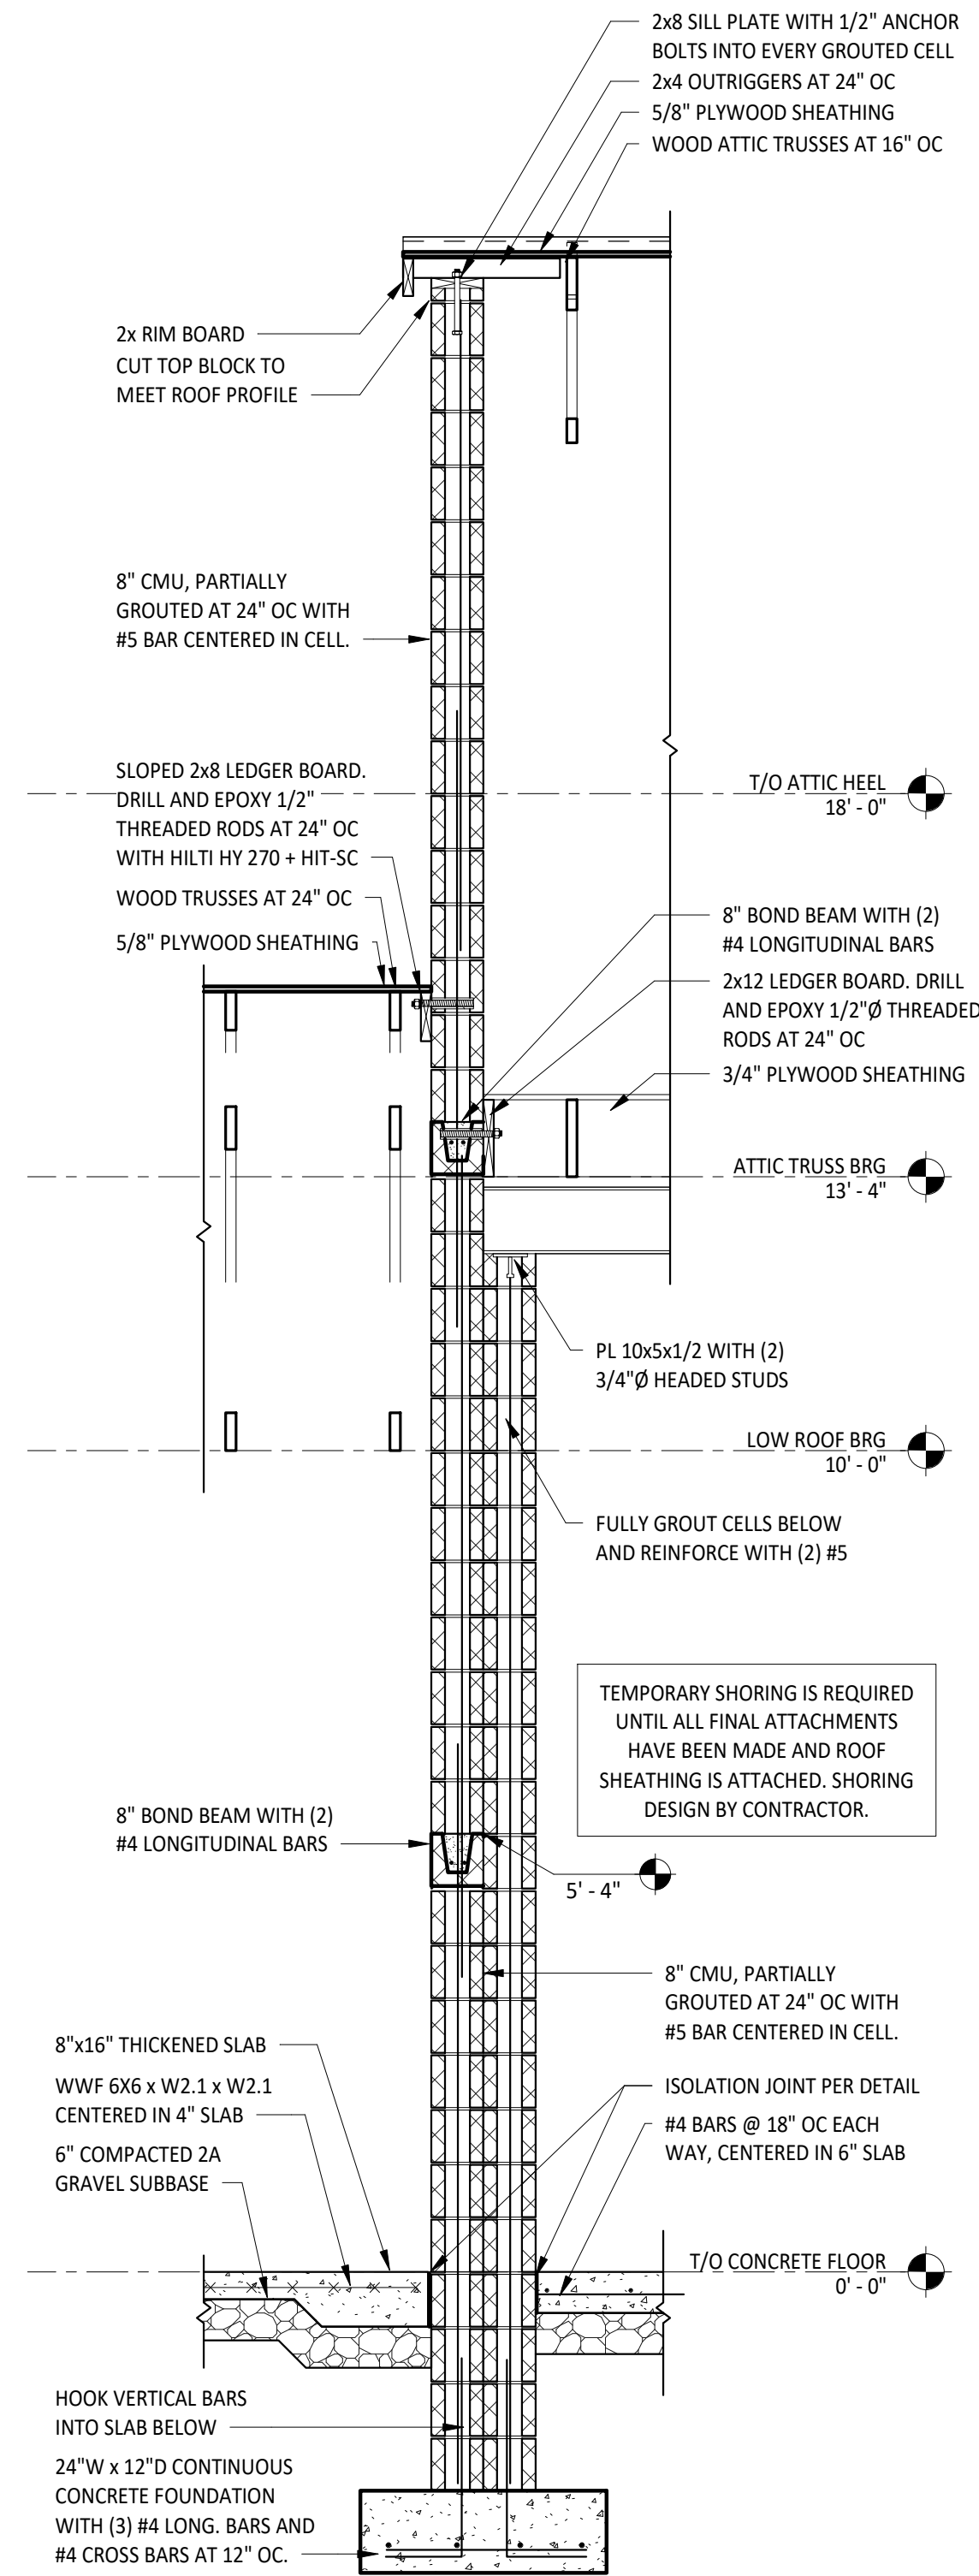

3 DEMISING WALL SECTION
SCALE: 1/2" = 1'-0"

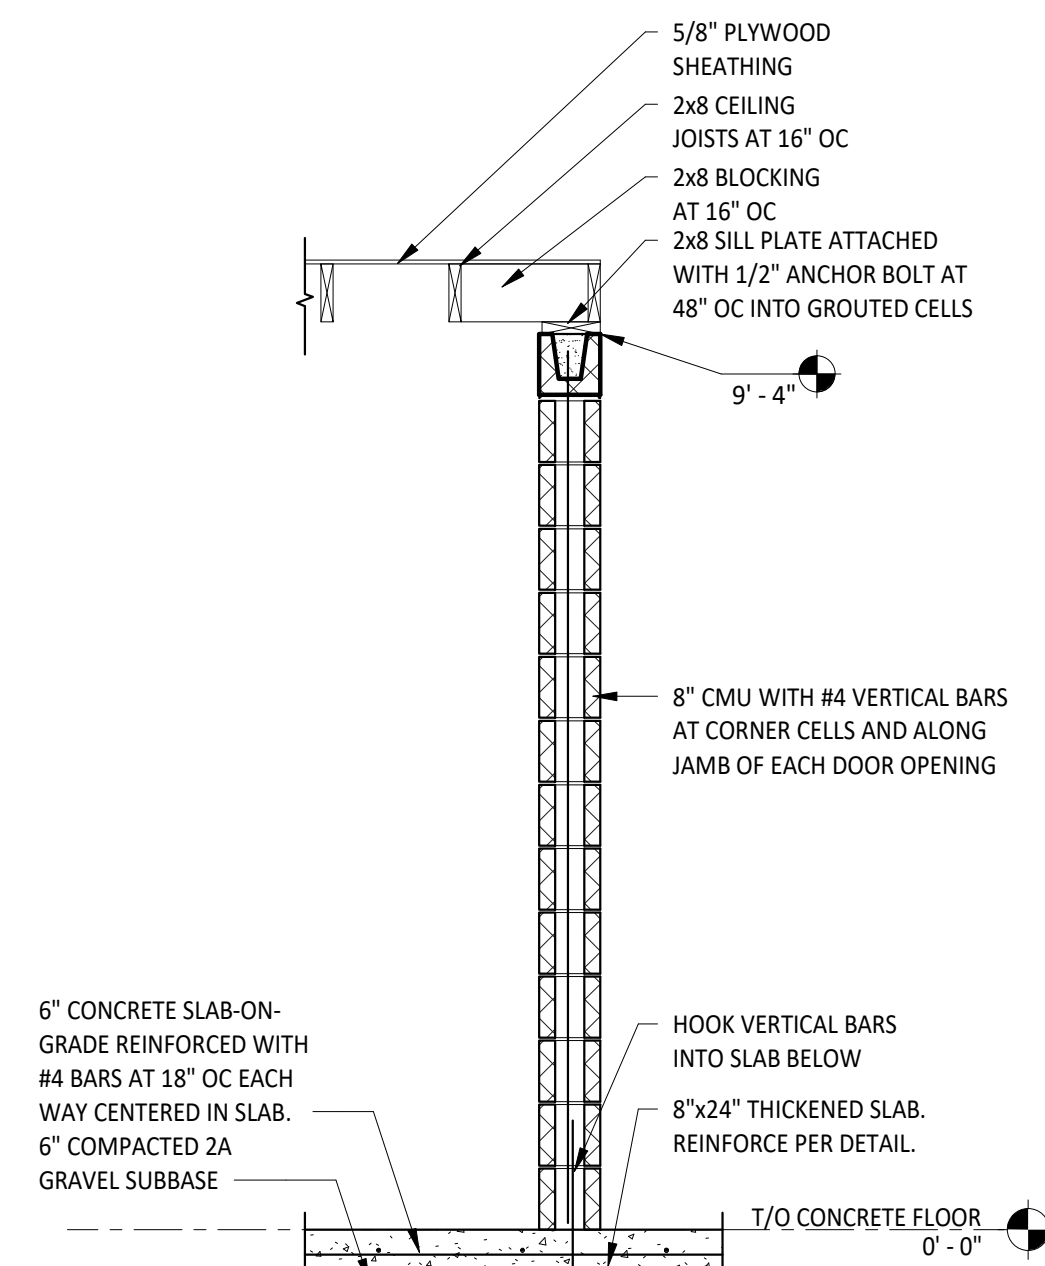

4 INT. WALL SECTION
SCALE: 1/2" = 1'-0"

Addendum #3

4.4.2023


1

BROOKE COUNTY EMS


DRAWN: PFB

PROJECT No.


SHEET No.

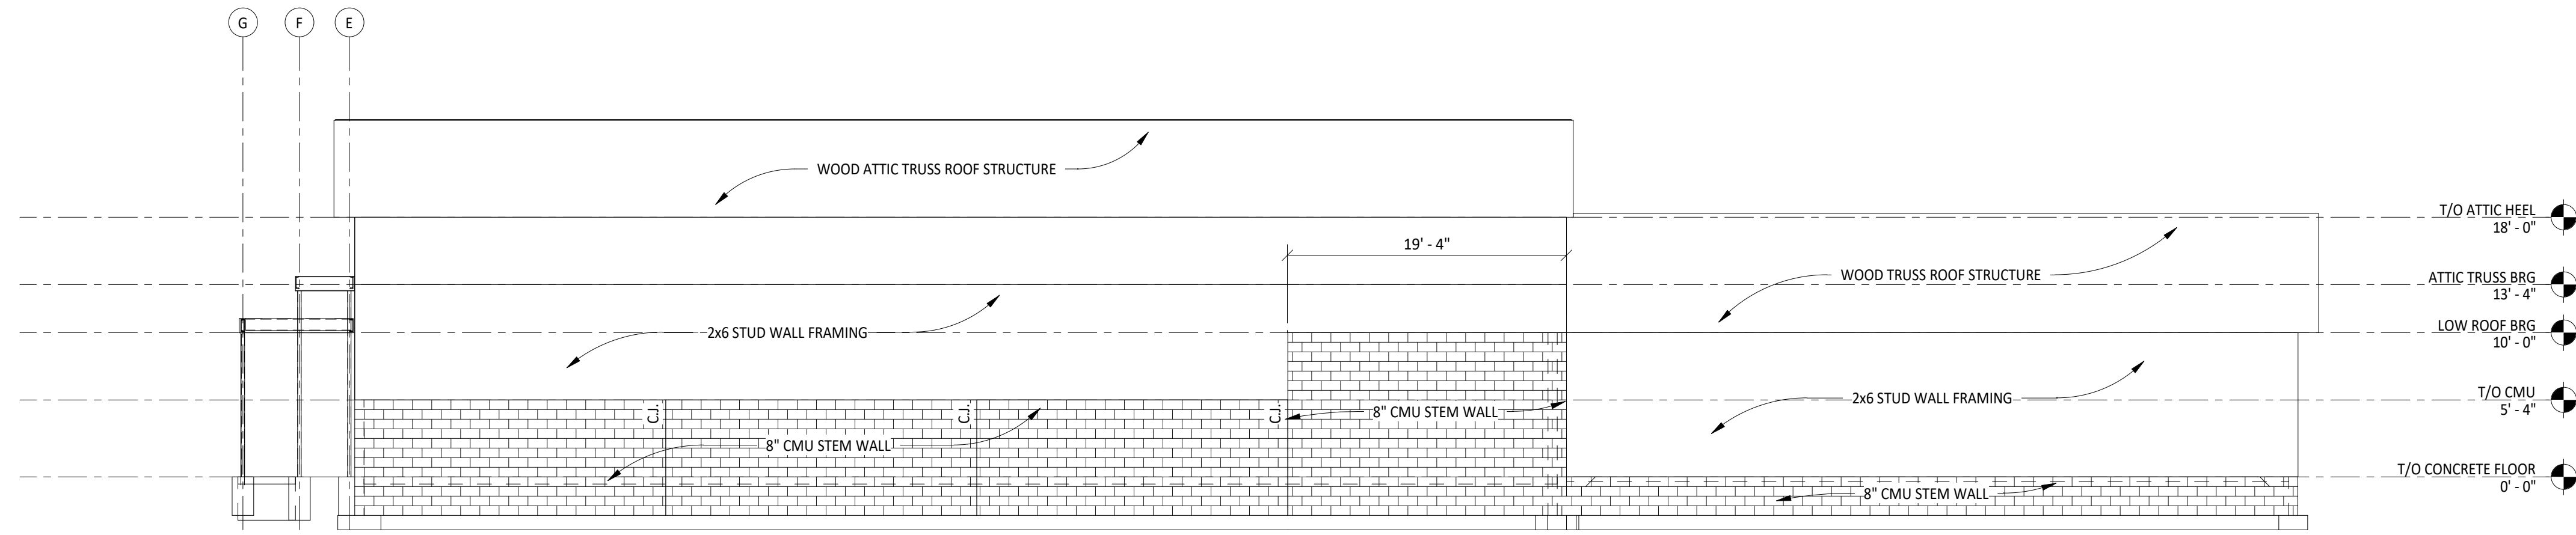


1 NORTH ELEVATION
S3.01 SCALE: 1/8" = 1'-0"

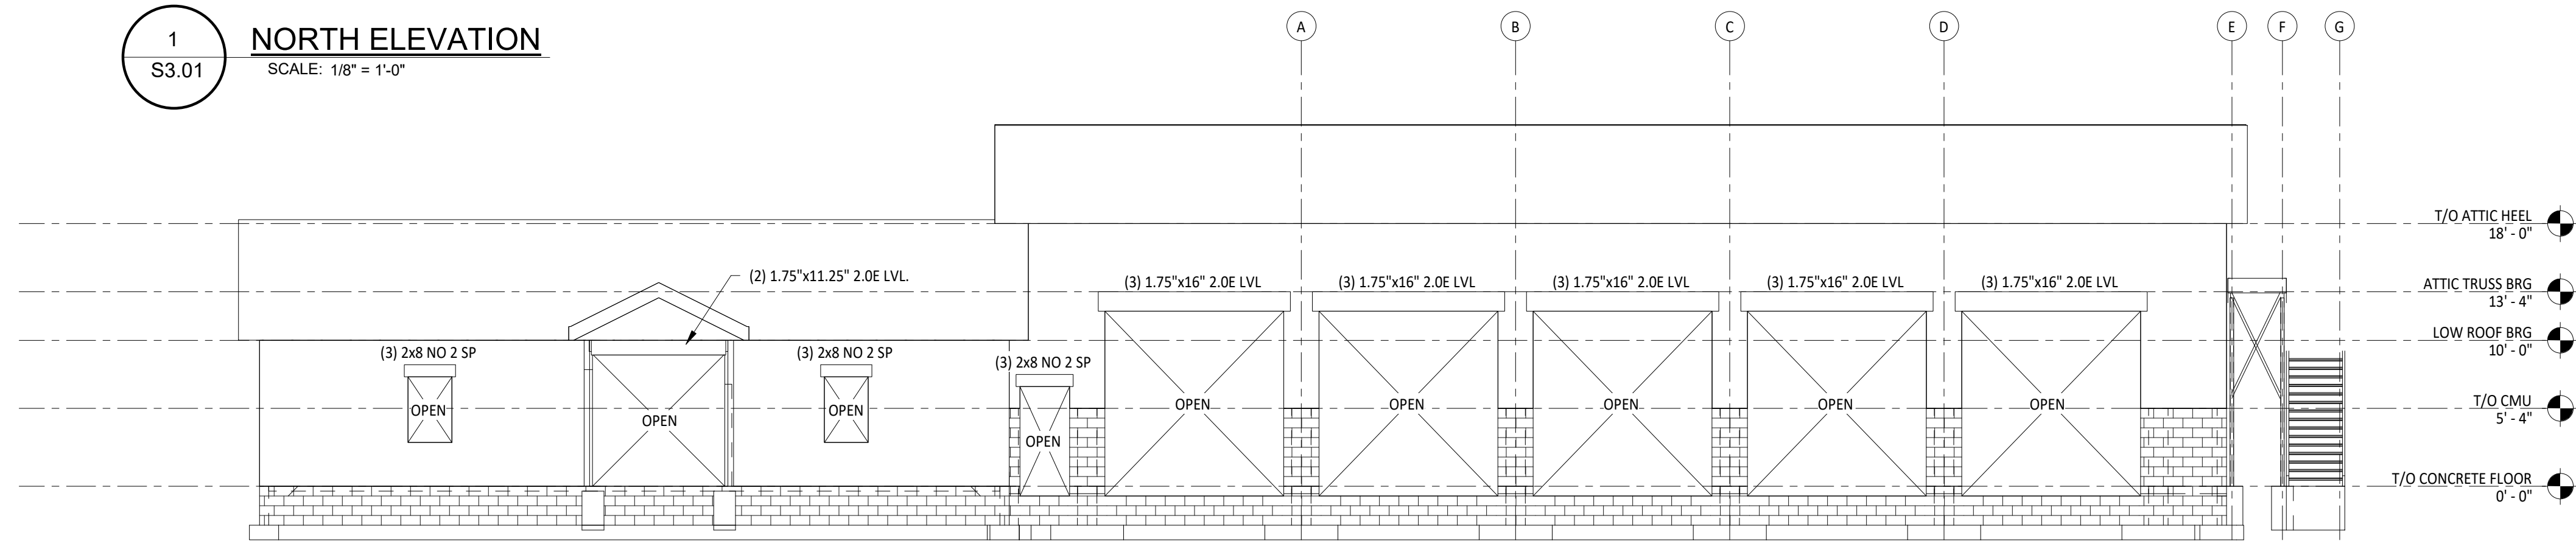

2 SOUTH ELEVATION
S3.01 SCALE: 1/8" = 1'-0"

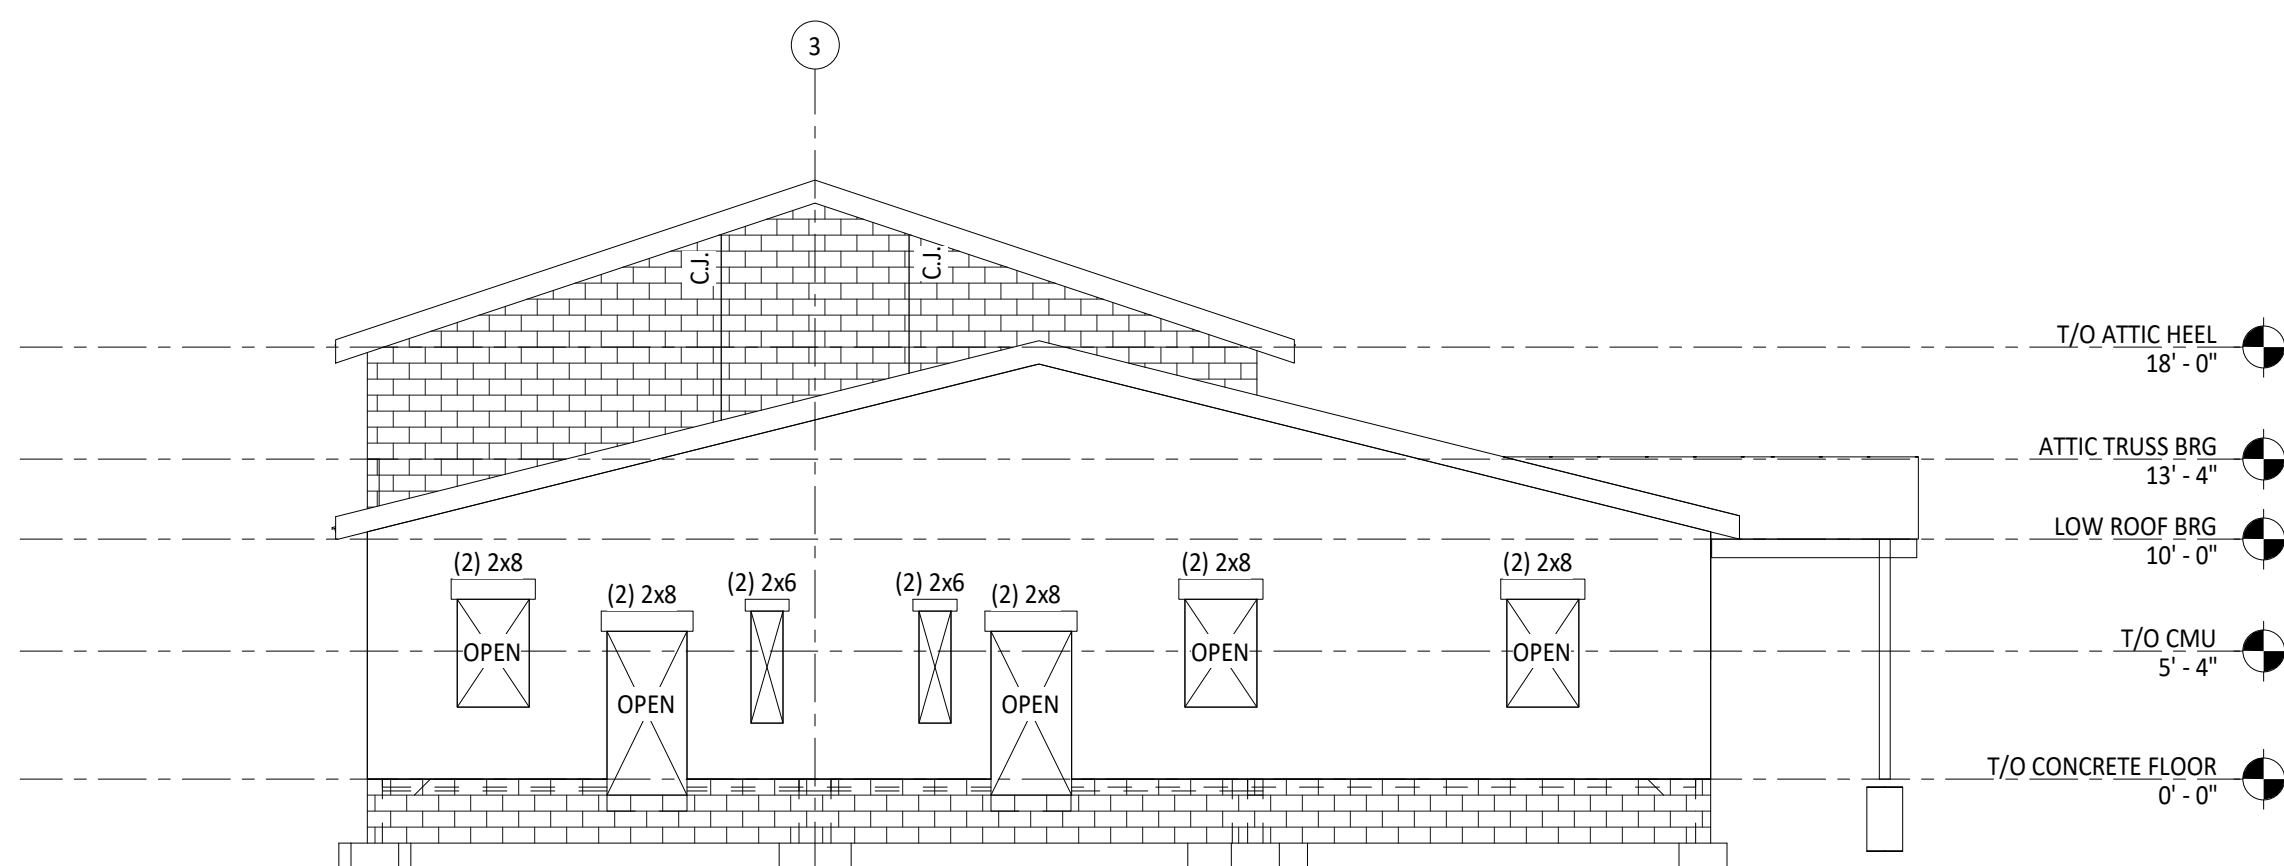

3 WEST ELEVATION
S3.01 SCALE: 1/8" = 1'-0"

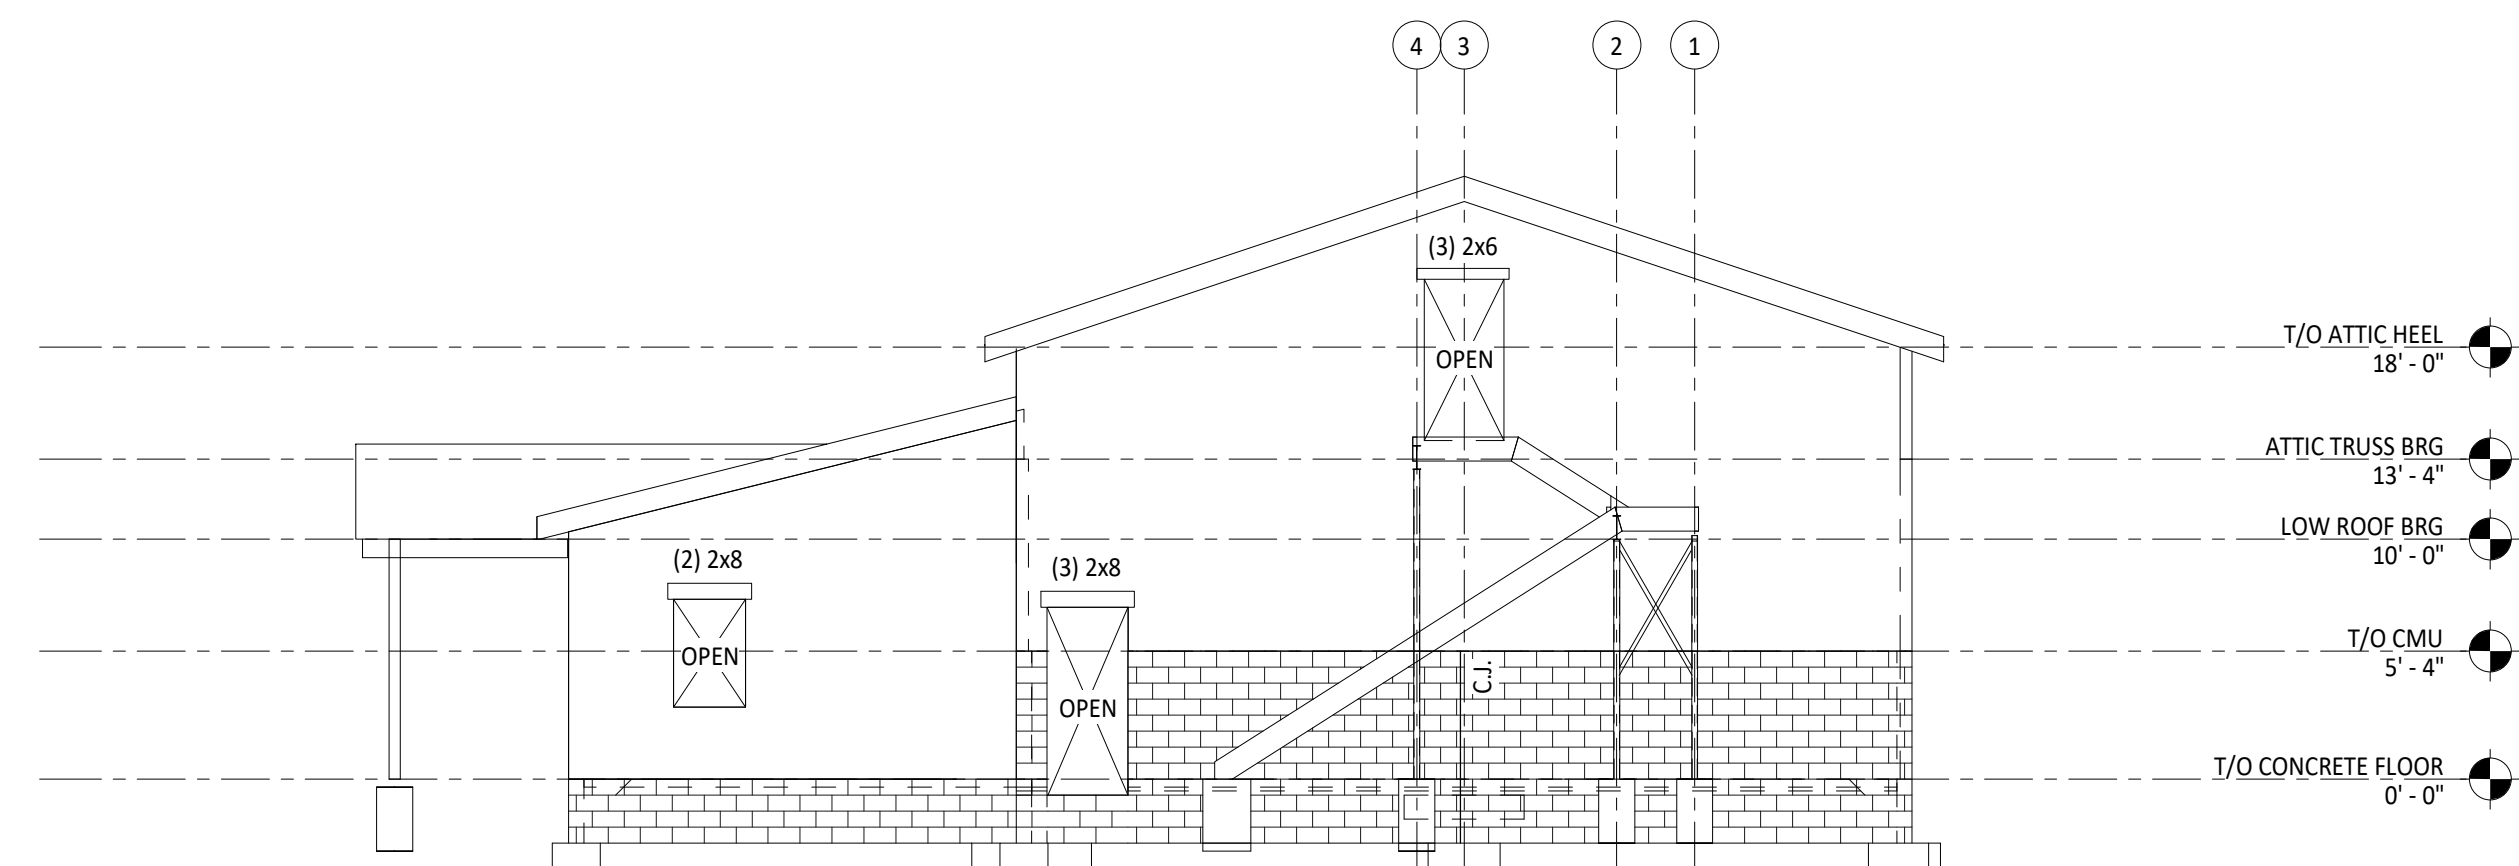

4 EAST ELEVATION
S3.01 SCALE: 1/8" = 1'-0"

| NO. | BY | DATE | DESCRIPTION |
|-----|----|----------|-------------|
| 1 | | 4.4.2023 | Addendum #3 |

BROOKE COUNTY EMS
BROOKE COUNTY COMMISSION
BROOKE COUNTY, WV
4.4.2023
Construction Drawings


DRAWN: PJB DATE: 4/4/2023
CHECKED: PJB DATE: 4/4/2023
APPROVED: MWH DATE: 4/4/2023

PROJECT No. T60-11009.00


ELEVATIONS

SHEET No.


S3.01

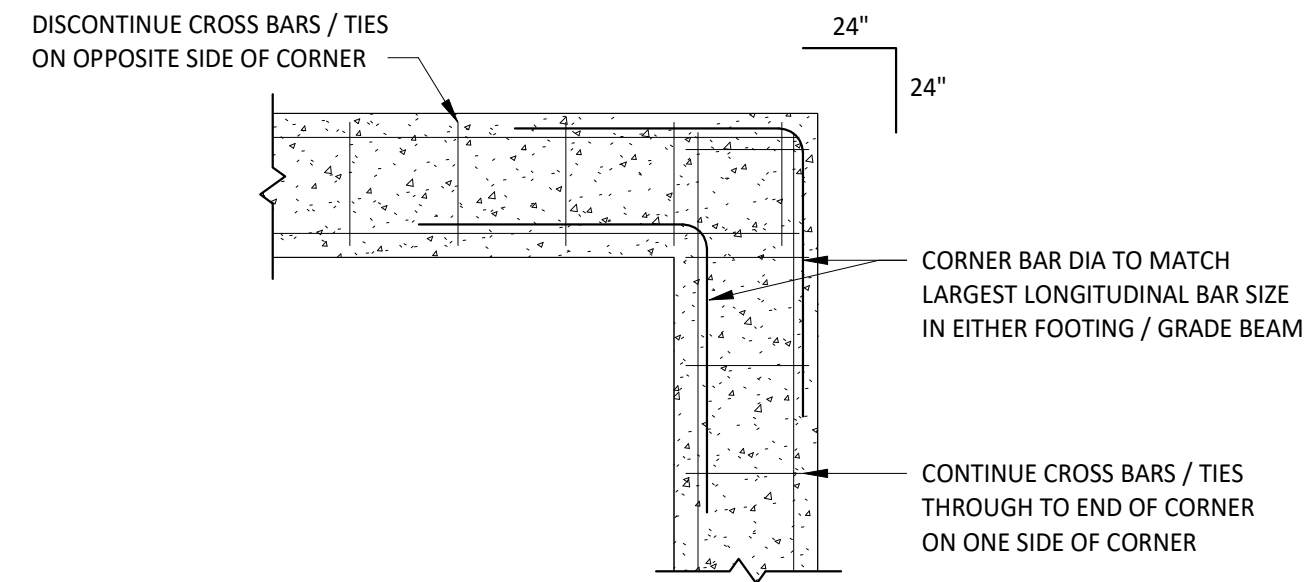


1
S5.00
DETAIL AT GRADE BEAM / FOOTING CORNER
SCALE: 3/4" = 1'-0"

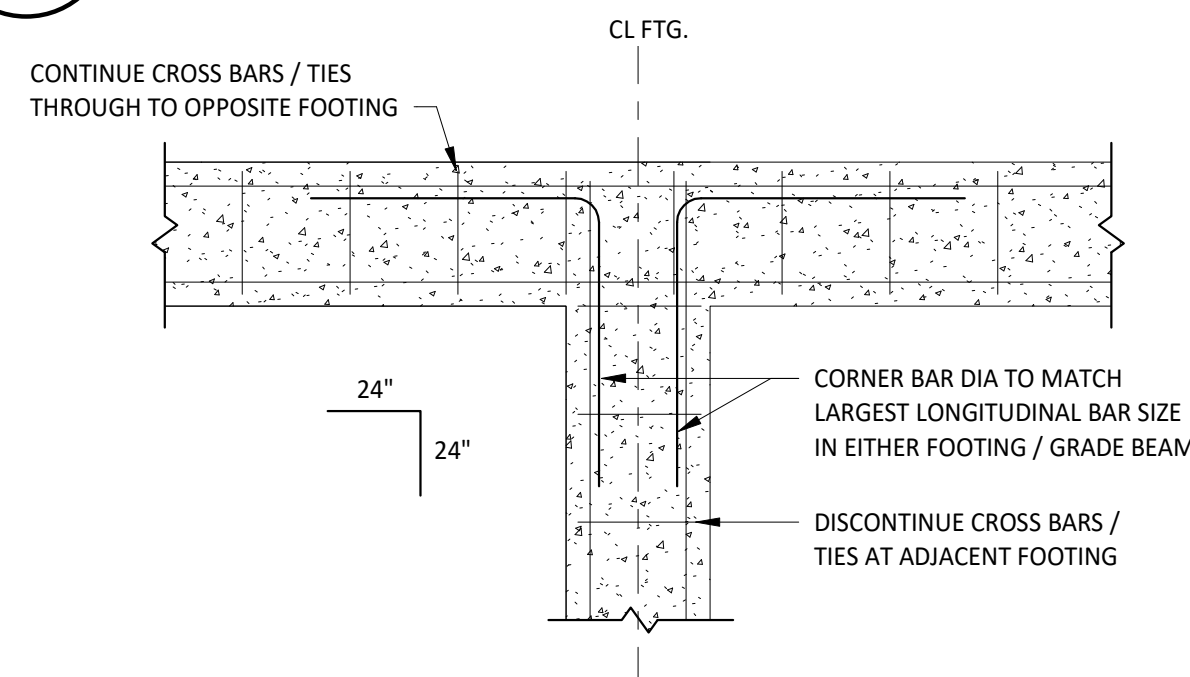


2
S5.00
DETAIL AT GRADE BEAM / FOOTING INTERSECTION
SCALE: 3/4" = 1'-0"

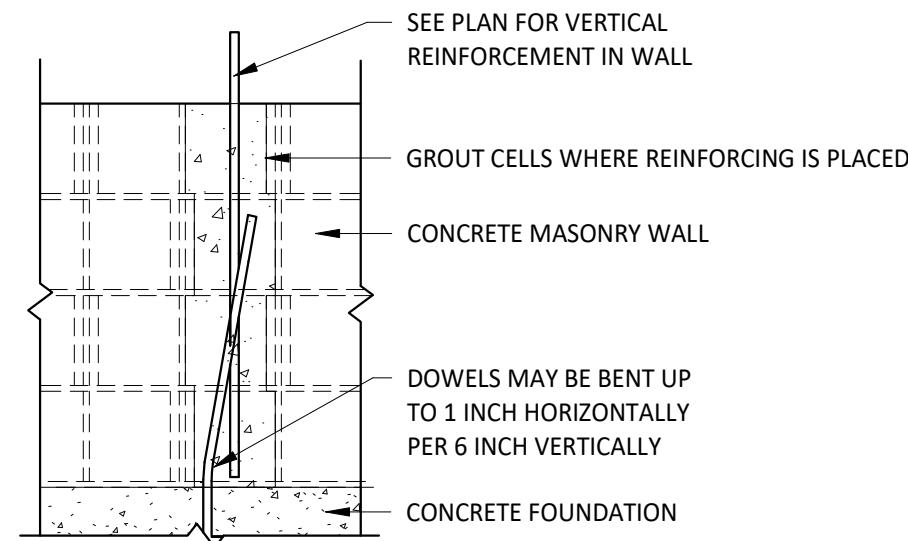


3
S5.00
MASONRY WALL AT FTG. DETAIL
SCALE: 3/4" = 1'-0"

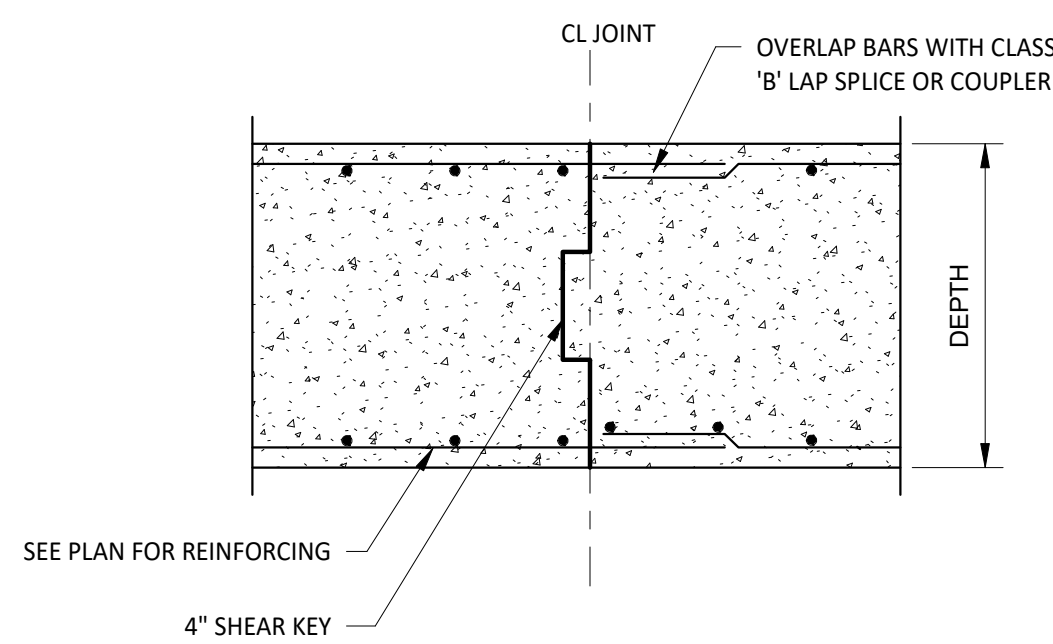


4
S5.00
DETAIL AT FOOTING CONSTRUCTION JOINT
SCALE: 3/4" = 1'-0"

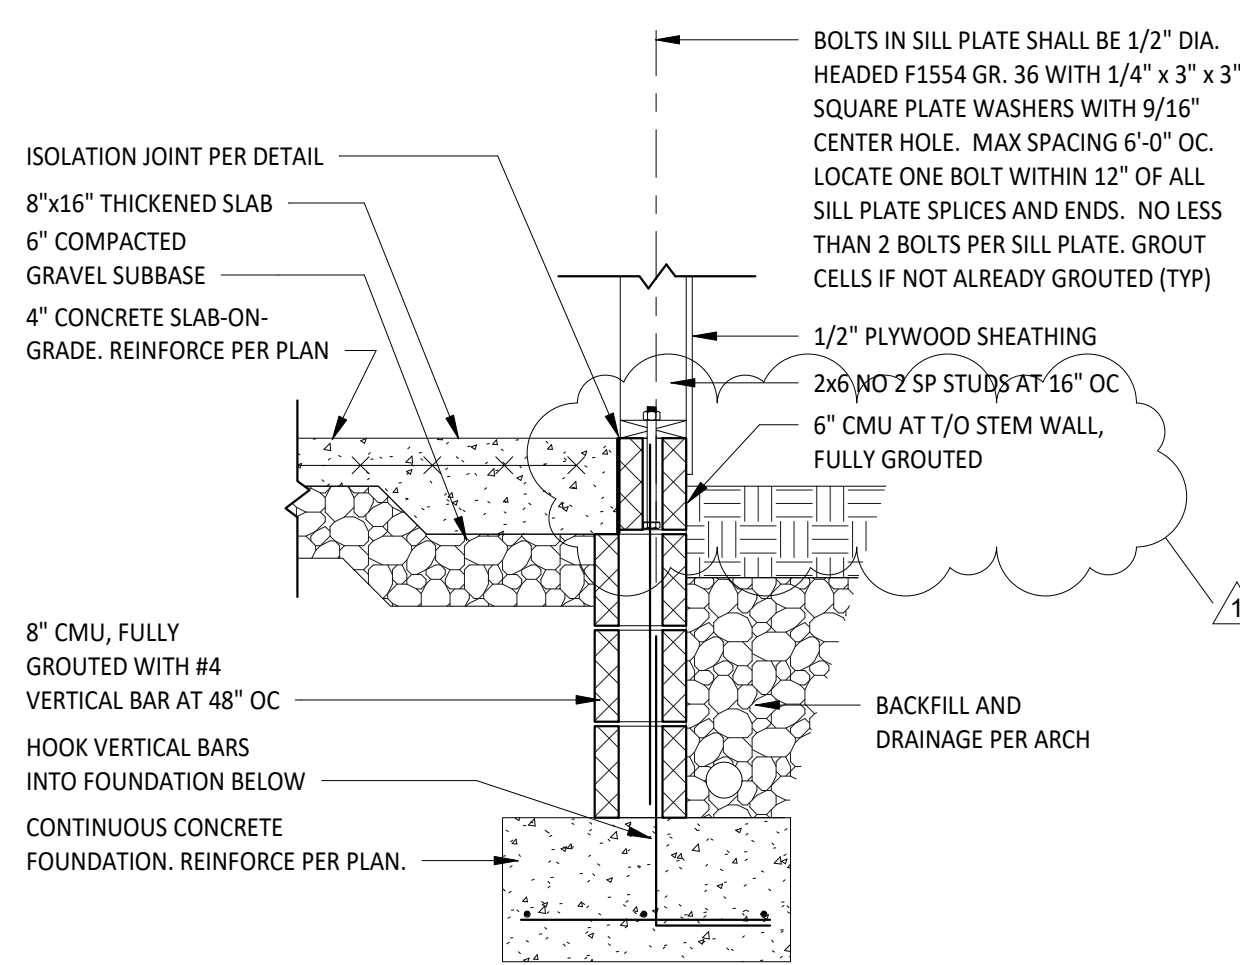


5
S5.00
DETAIL AT FOUNDATION
SCALE: 3/4" = 1'-0"

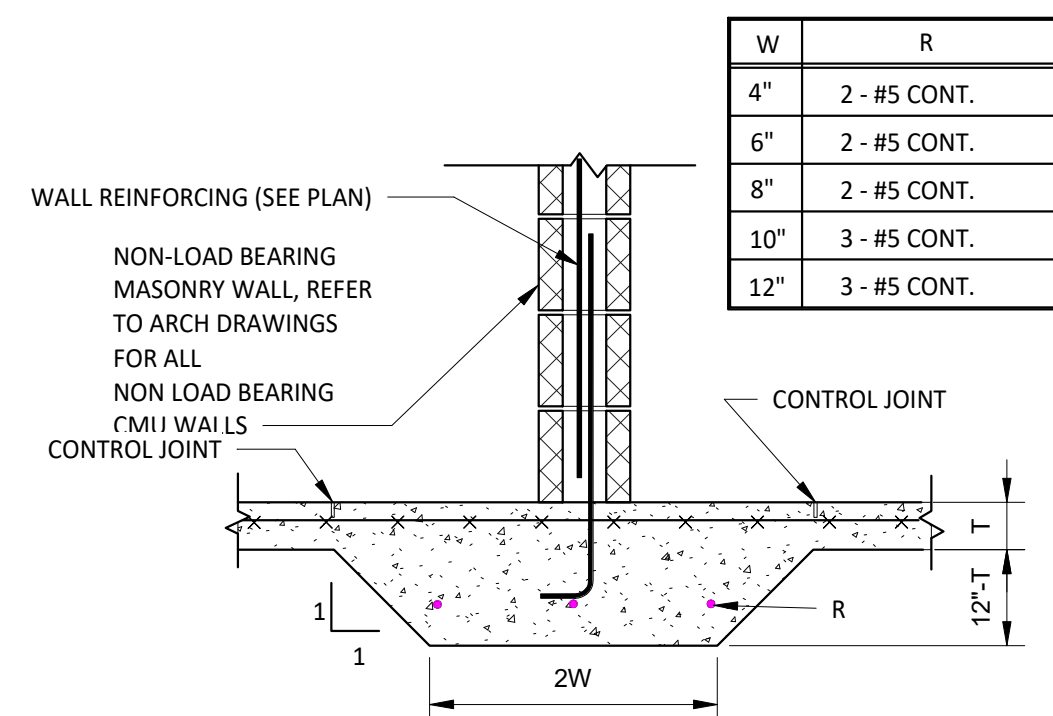



6
S5.00
THICKENED SLAB UNDER CMU PARTITIONS
SCALE: 3/4" = 1'-0"

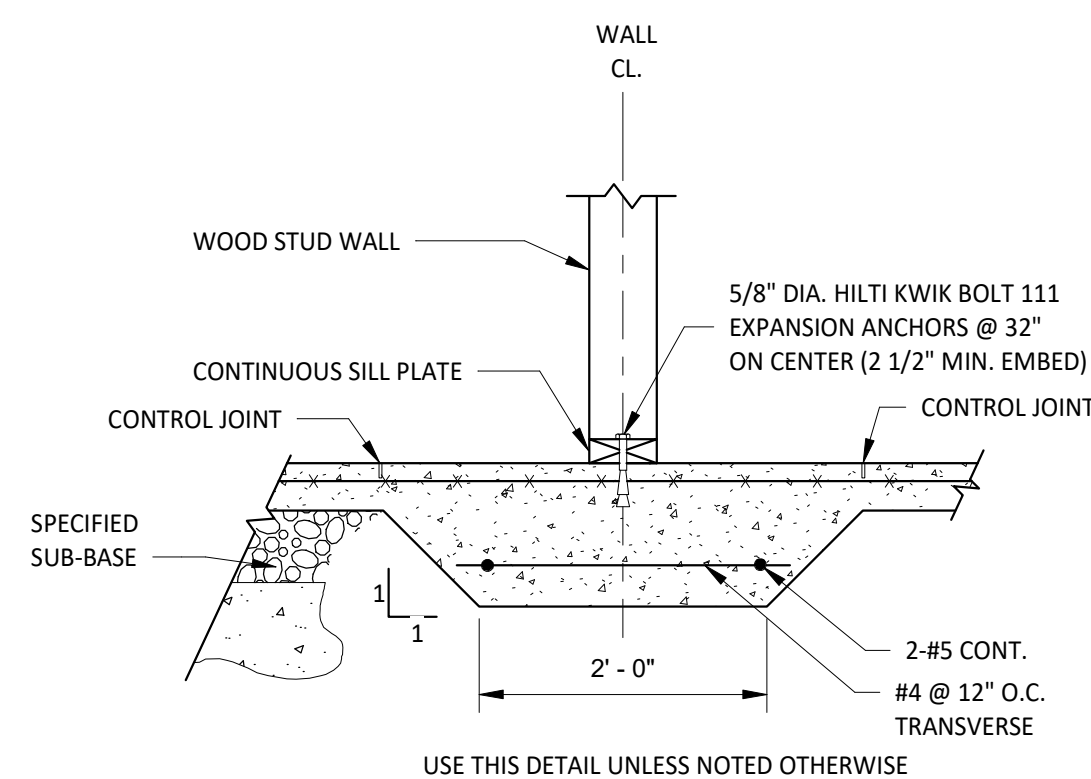


7
S5.00
THICKENED SLAB AT L.B. STUD WALL
SCALE: 3/4" = 1'-0"

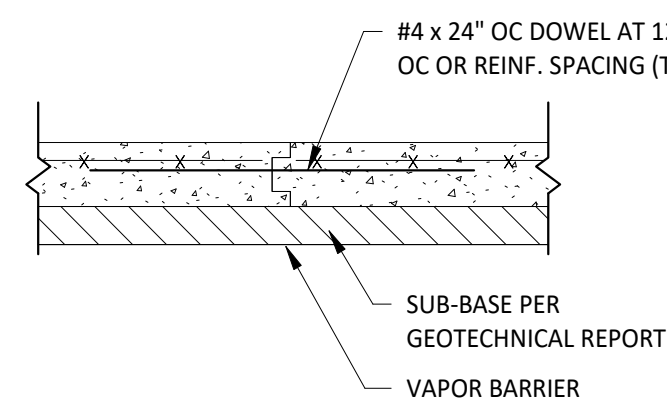


8
S5.00
SLAB CONSTRUCTION JOINT DETAIL
SCALE: 3/4" = 1'-0"

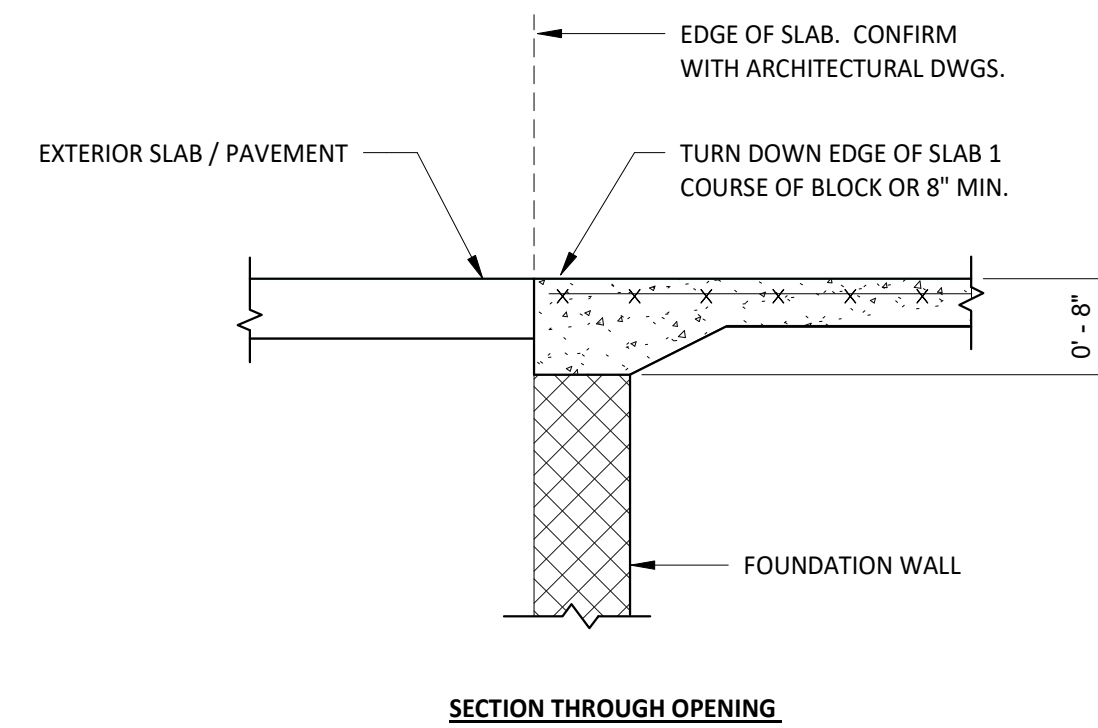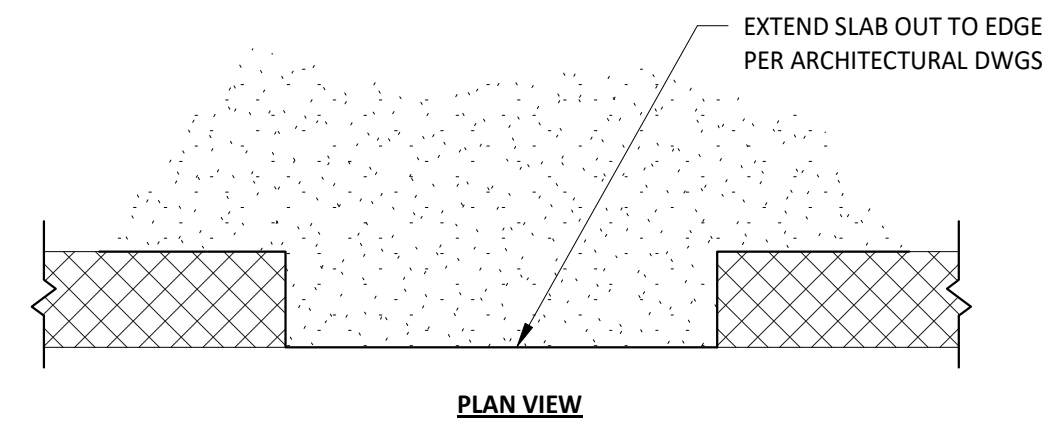


9
S5.00
SLAB DETAIL AT ENTRANCES & OPENINGS
SCALE: 3/4" = 1'-0"

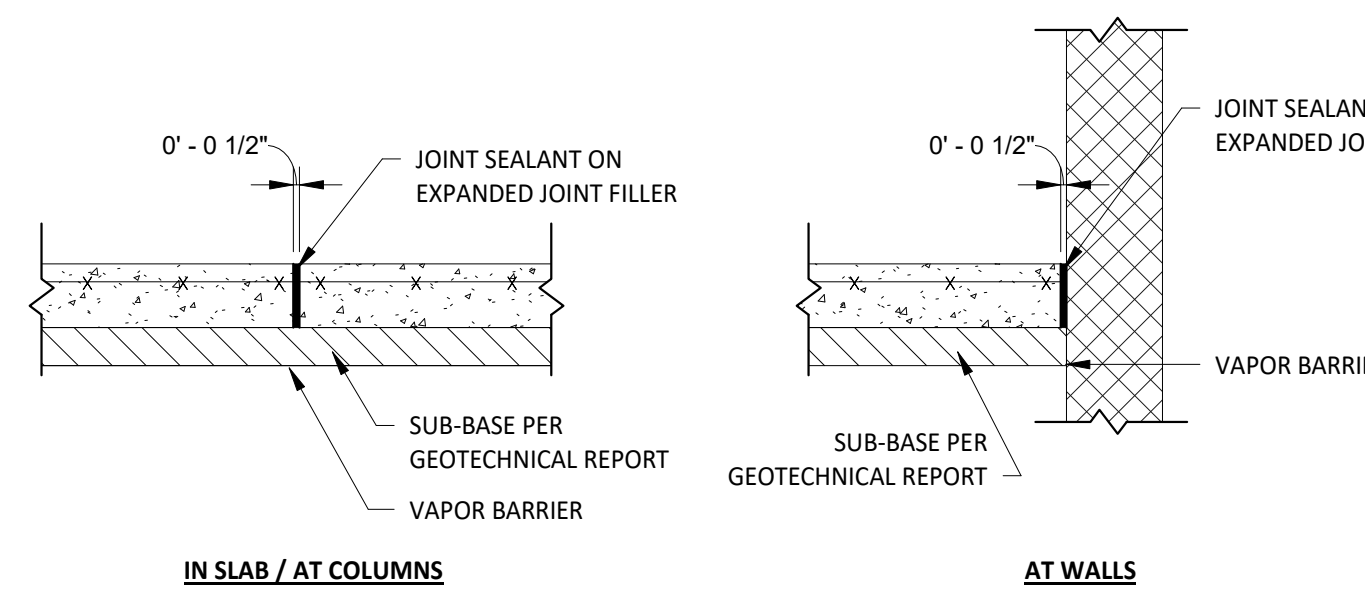


10
S5.00
SLAB ISOLATION JOINT DETAIL
SCALE: 3/4" = 1'-0"

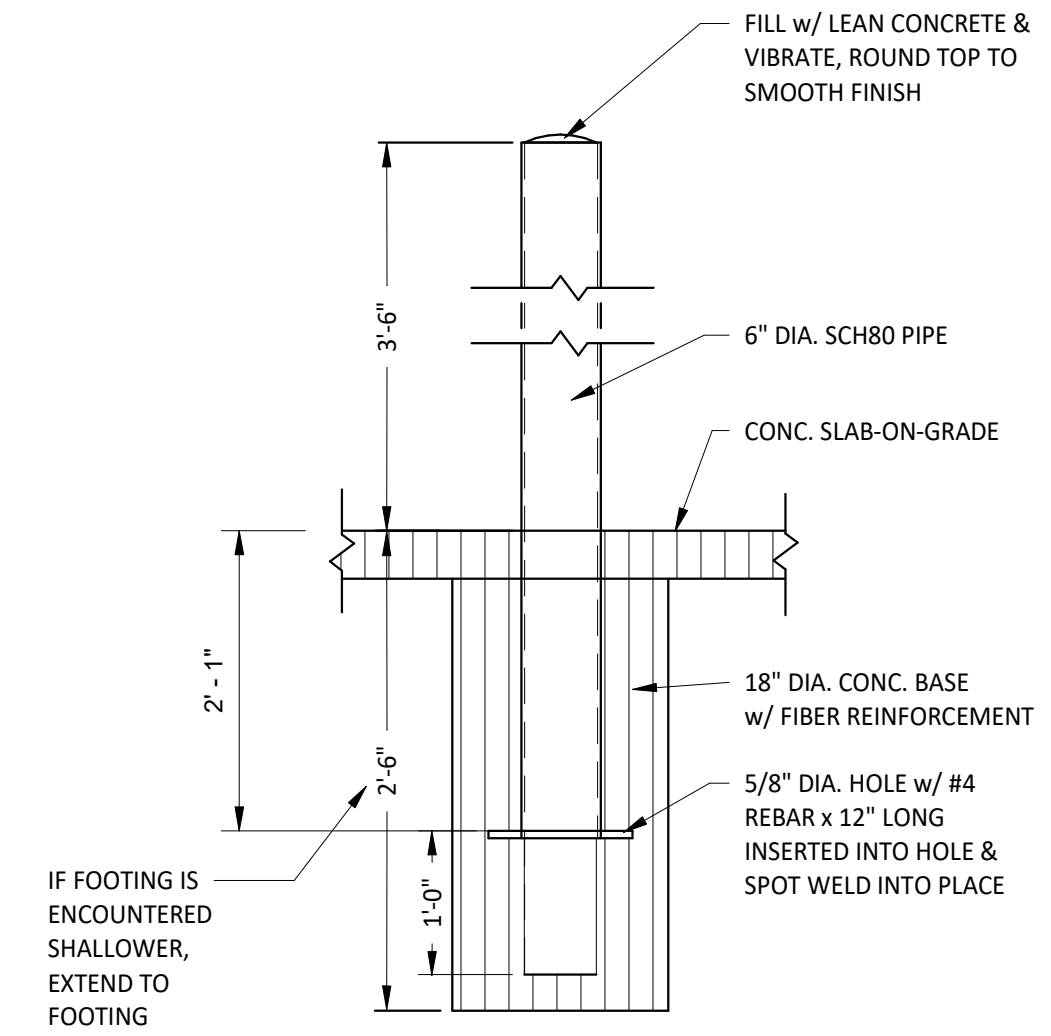

11
S5.00
BOLLARD DETAIL @ GROUND LEVEL
SCALE: 3/4" = 1'-0"

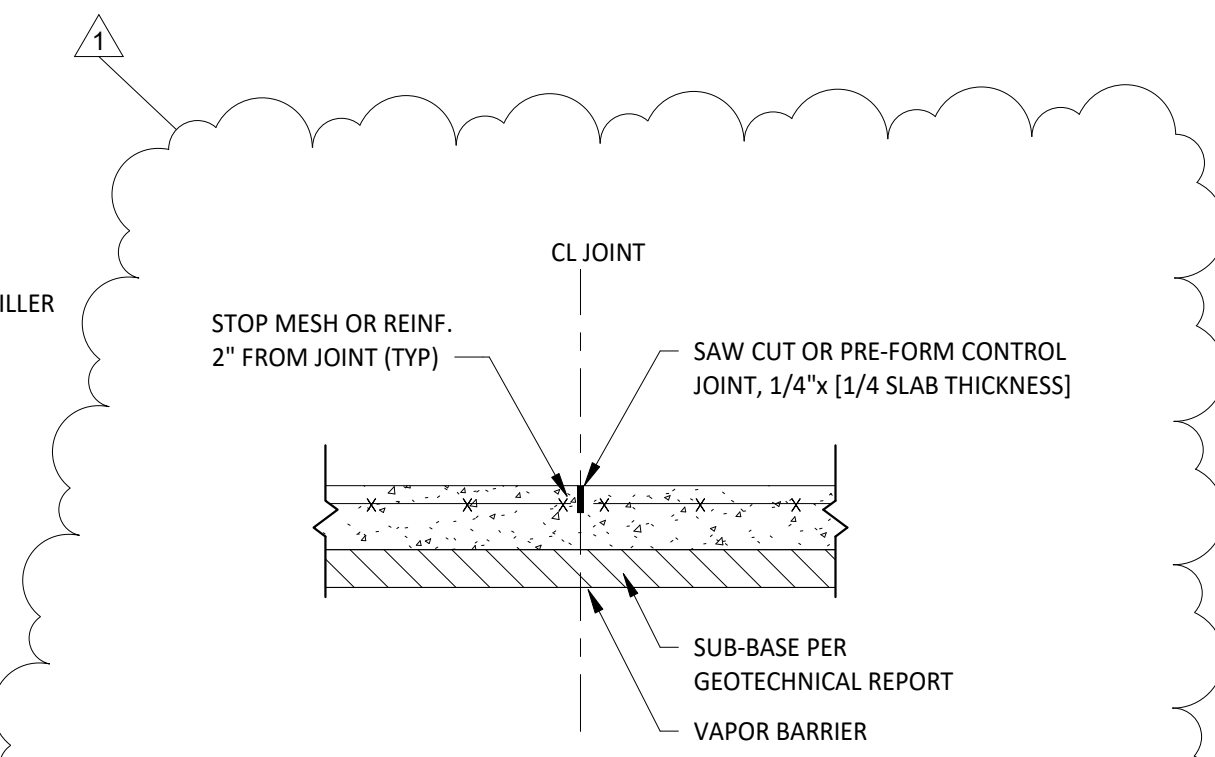


13
S5.00
SLAB CONTROL JOINT DETAIL
SCALE: 3/4" = 1'-0"

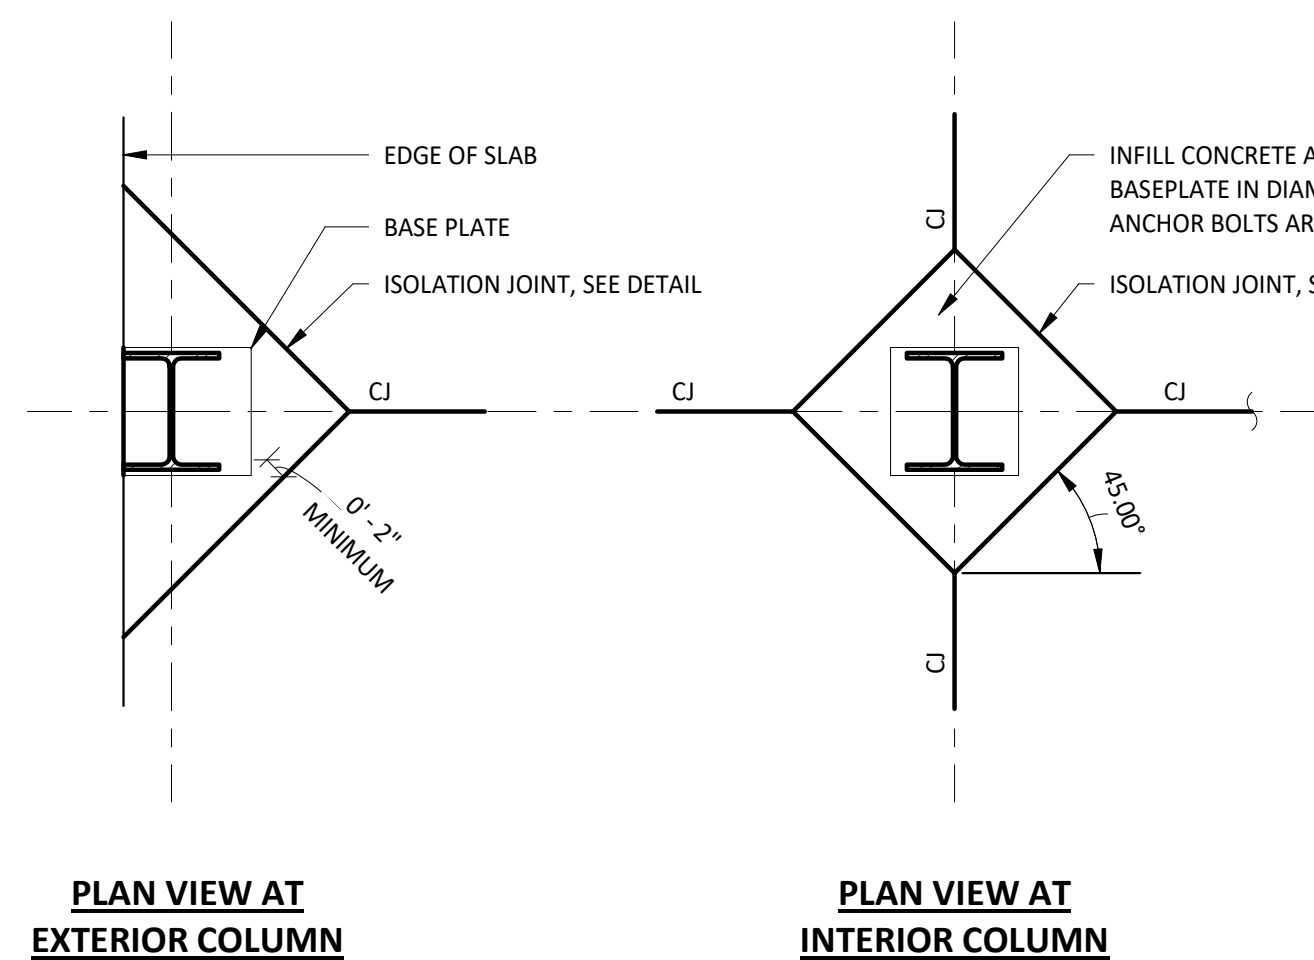


12
S5.00
ISOLATION JOINT DETAIL AT STEEL COLUMNS
SCALE: 3/4" = 1'-0"


| NO. | BY | DATE | DESCRIPTION |
|-----|----|------|-------------|
| 1 | | | |

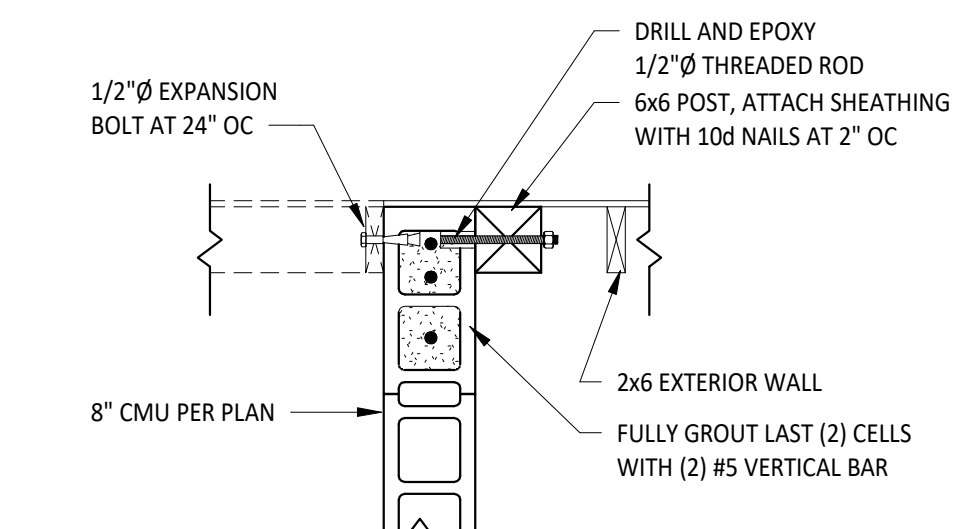


1 CMU/SHEAR WALL TRANSITION
S5.01 SCALE: 3/4" = 1'-0"

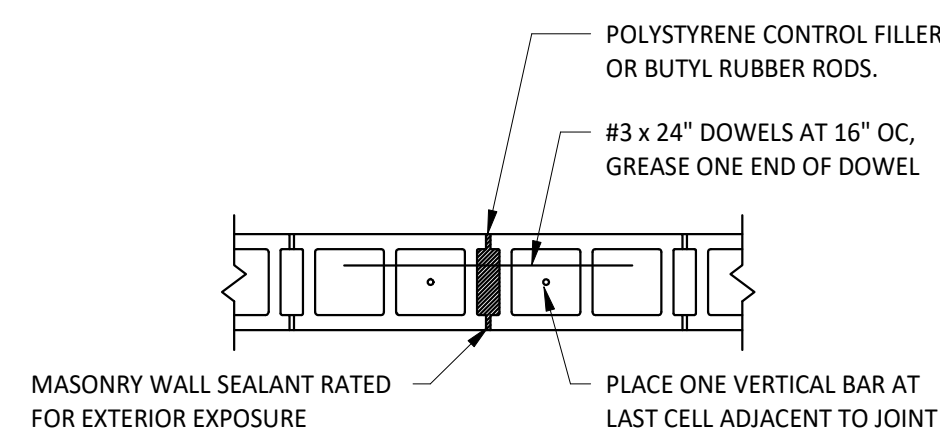


4 TYPICAL MASONRY WALL CONTROL JOINT DETAIL
S5.01 SCALE: 3/4" = 1'-0"

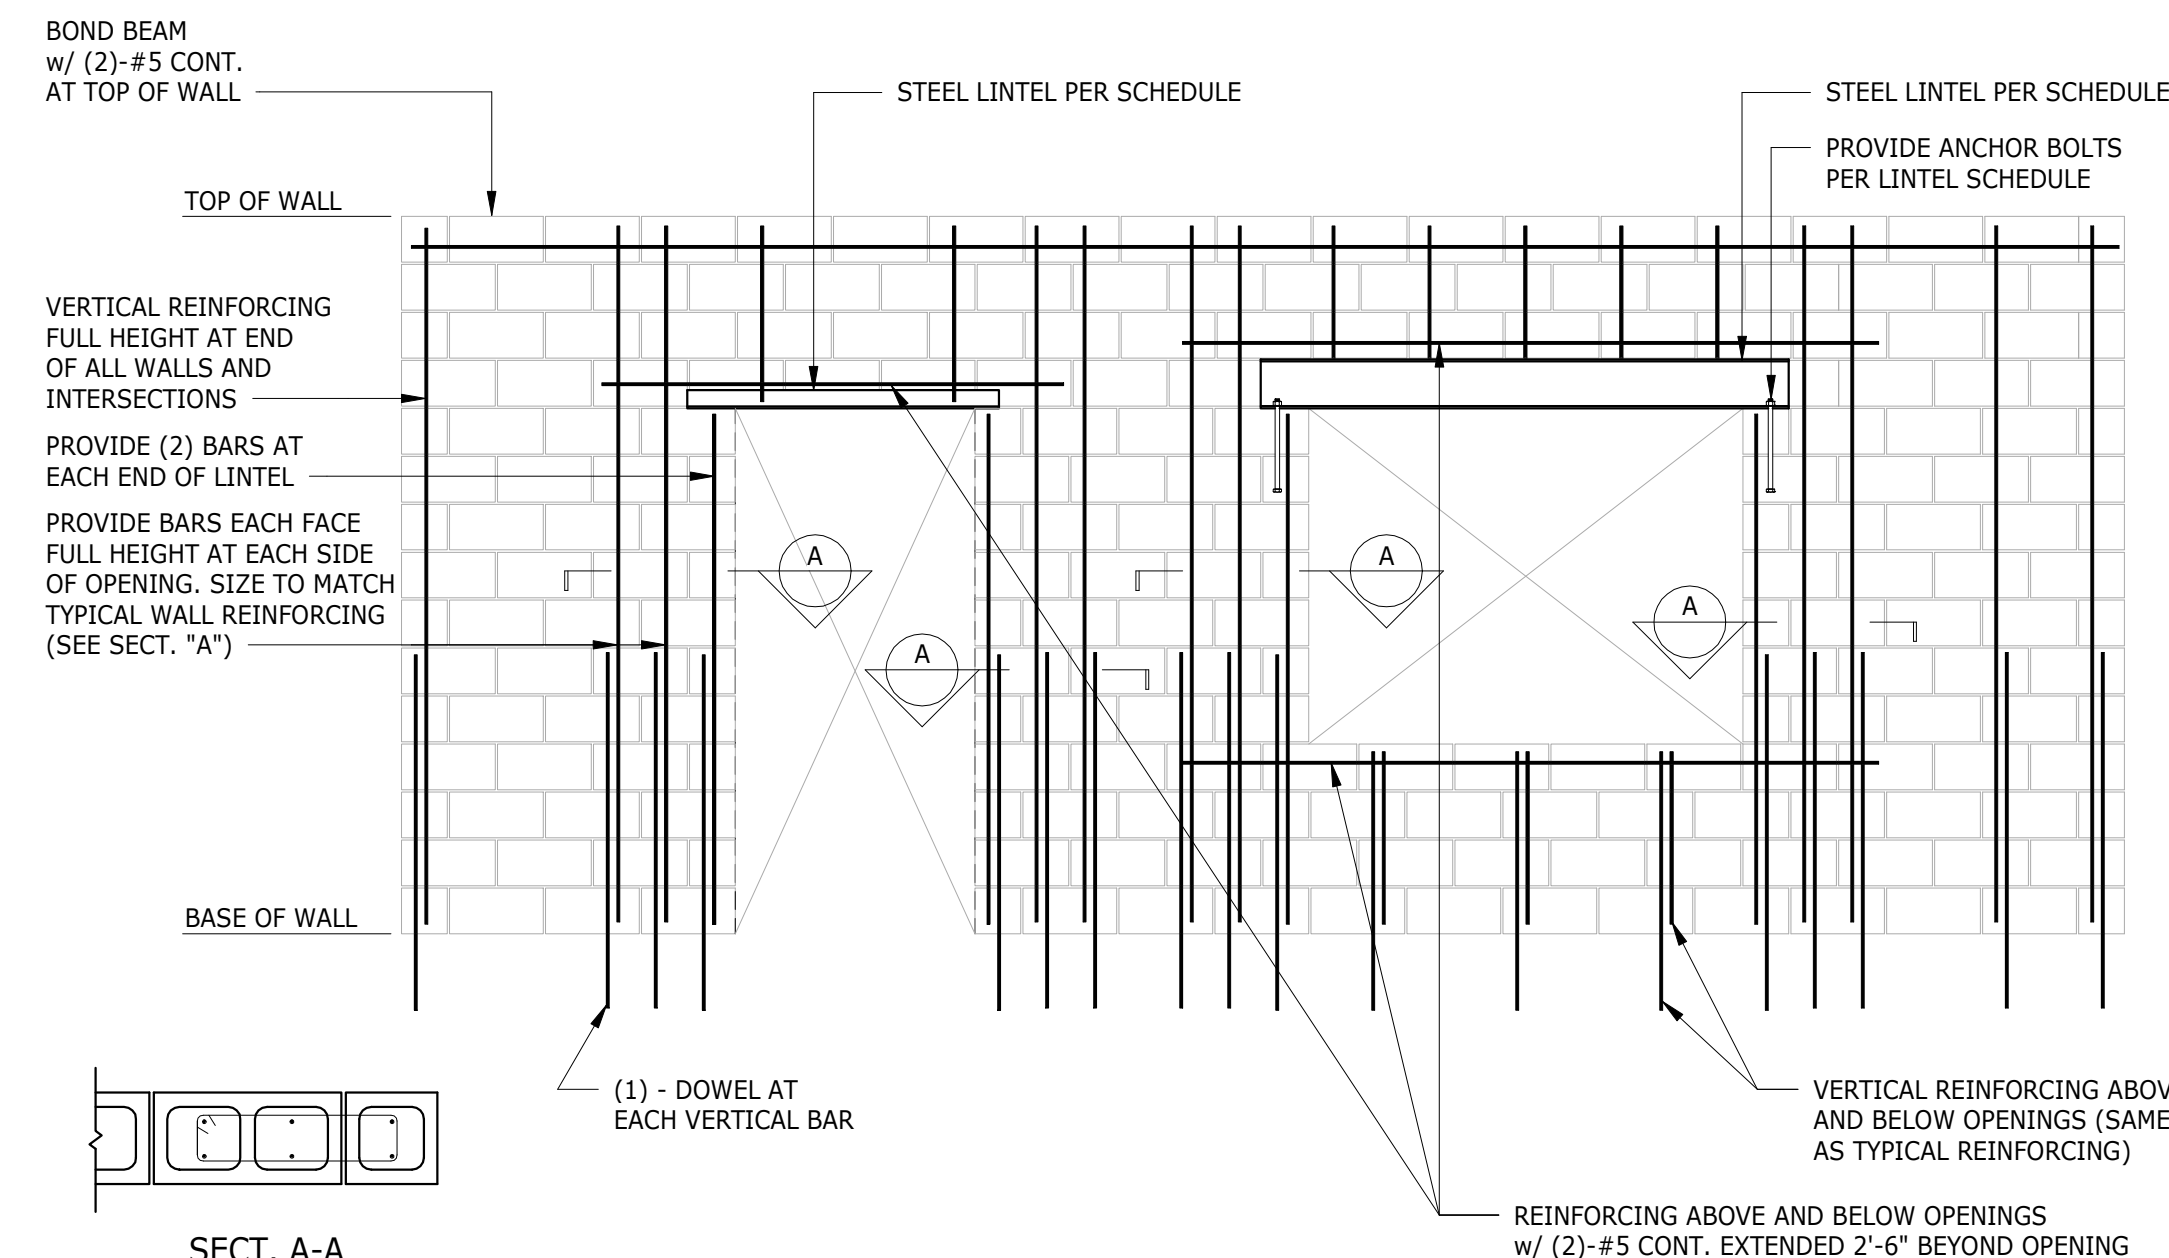


- NOTES:**
- SEE GENERAL NOTES AND WALL SECTIONS FOR WALL REINFORCING.
 - LOCATE REINFORCING AS SHOWN ON TYPICAL WALL REINFORCING DETAIL.
 - SEE GENERAL NOTES FOR HORIZONTAL JOINT REINFORCING AND SPLICES.
 - SEE ARCHITECTURAL DRAWINGS FOR SIZE AND LOCATION OF WALLS NOT SHOWN ON STRUCTURAL DRAWINGS.
 - GROUT CELLS SOLID FULL HEIGHT AT ALL VERTICAL REINFORCING.

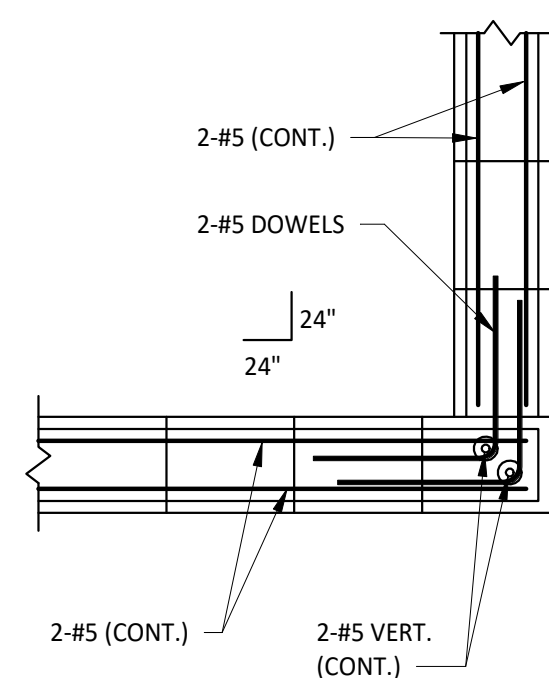


2 TYPICAL BOND BEAM AT CORNER DETAIL
S5.01 SCALE: 3/4" = 1'-0"

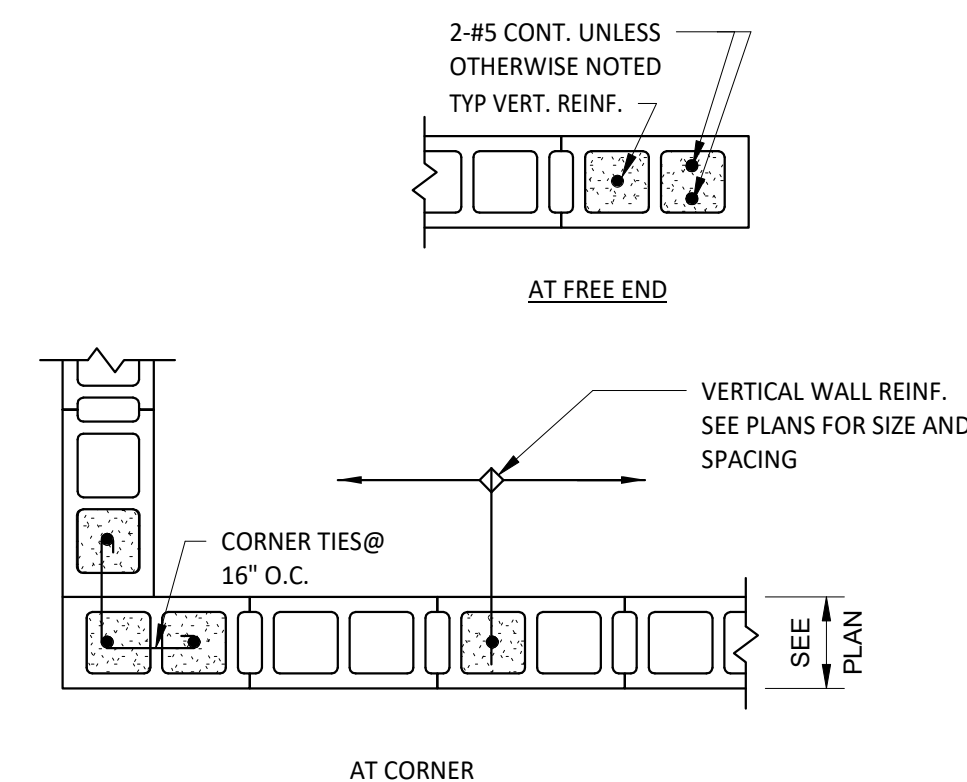

5 TYPICAL REINFORCED C.M.U. WALL DETAILS
S5.01 SCALE: 3/4" = 1'-0"

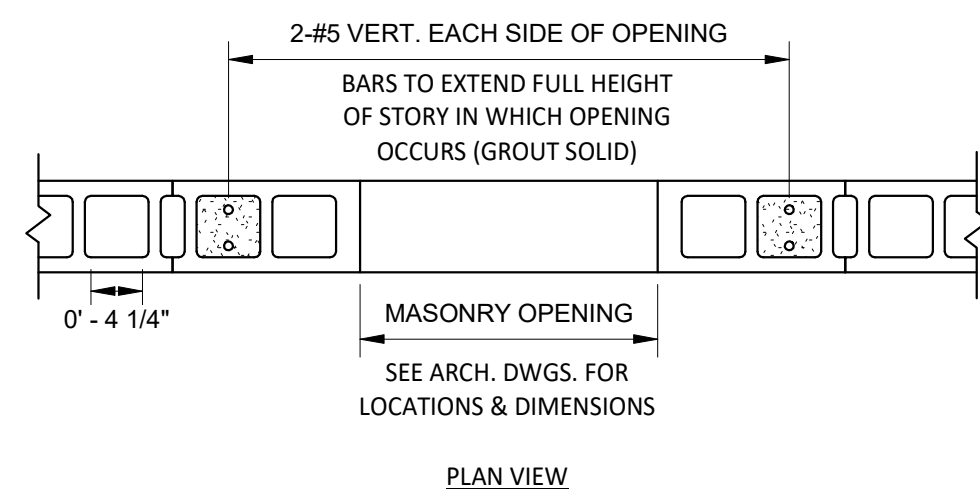


3 TYP JAMB REINF IN MSNRY WALL DETAIL
S5.01 SCALE: 3/4" = 1'-0"

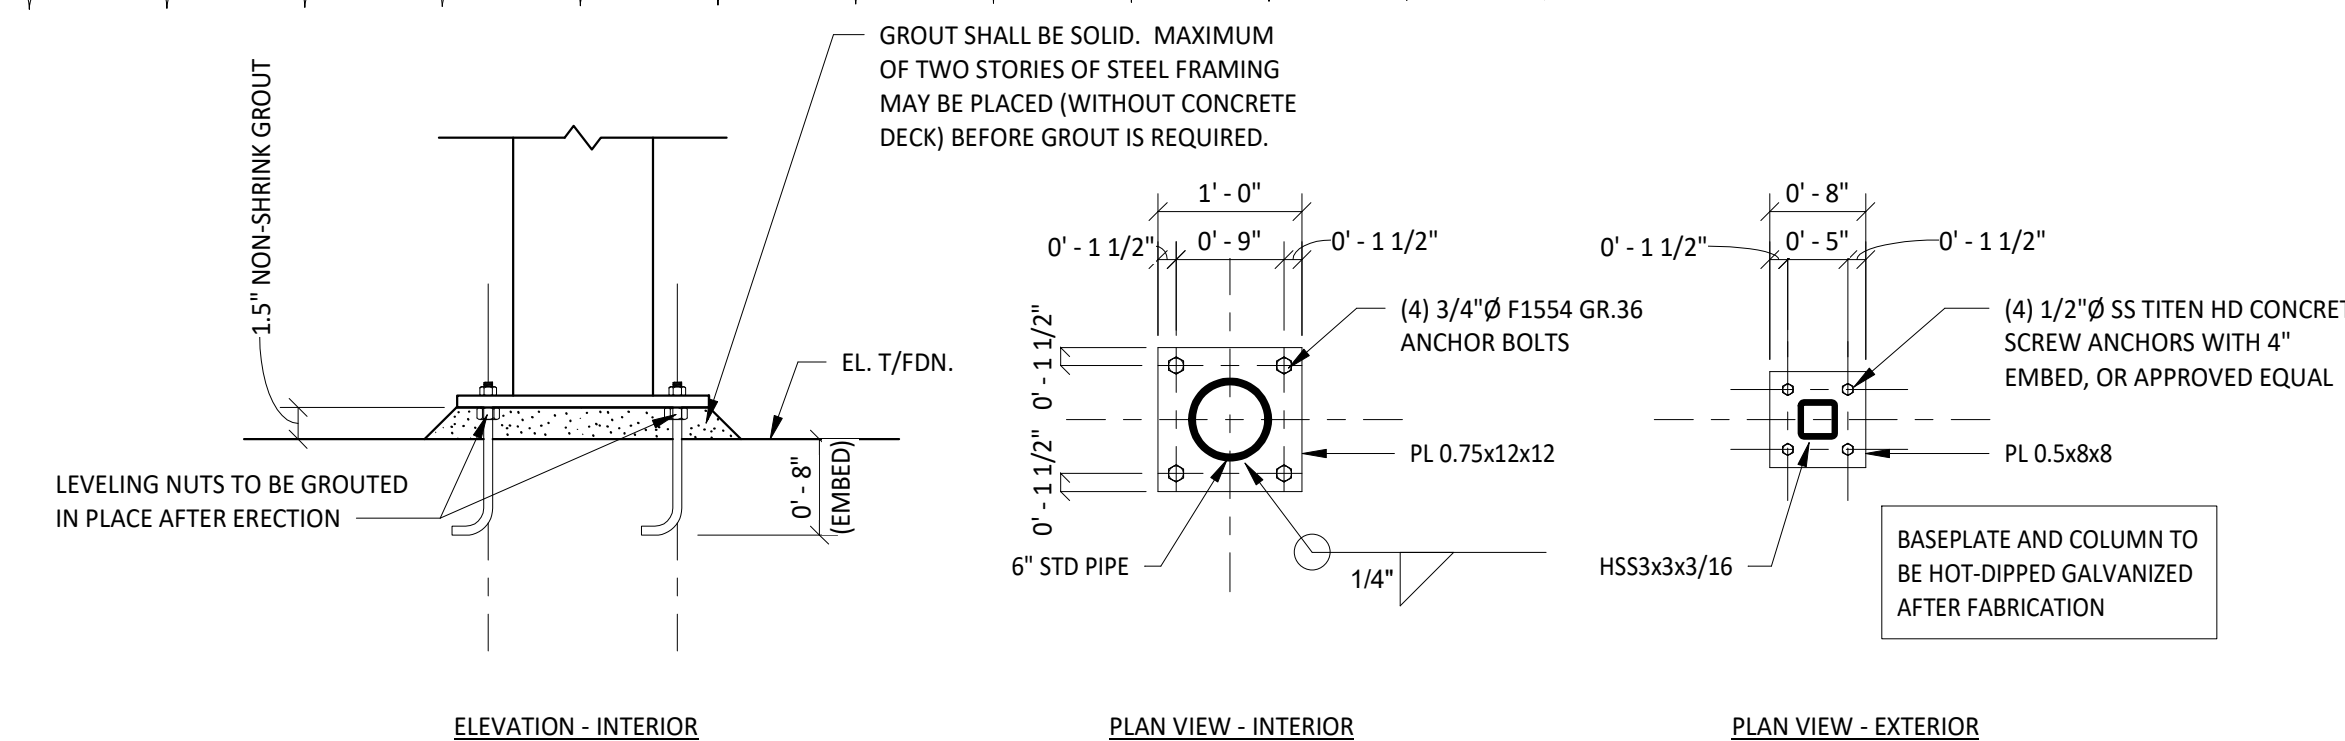


6 TYPICAL OPENINGS
S5.01 SCALE: 3/8" = 1'-0"

| REQUIRED DEVELOPMENT LENGTH OF REINFORCING BARS FOR MASONRY | | | |
|---|----------------------------|----------------------|--------------------|
| CLEAR SPACING (in) | COMPRESSIVE STRENGTH (psi) | REINFORCING BAR SIZE | DEVELOPMENT LENGTH |
| 8 | 1500 | #3 | 12" |
| | | #4 | 14" |
| | | #5 | 22" |
| 16 | 1500 | #3 | 12" |
| | | #4 | 12" |
| | | #5 | 14" |
| 24 | 1500 | #3 | 12" |
| | | #4 | 12" |
| | | #5 | 14" |
| 48 | 1500 | #3 | 12" |
| | | #4 | 12" |
| | | #5 | 14" |

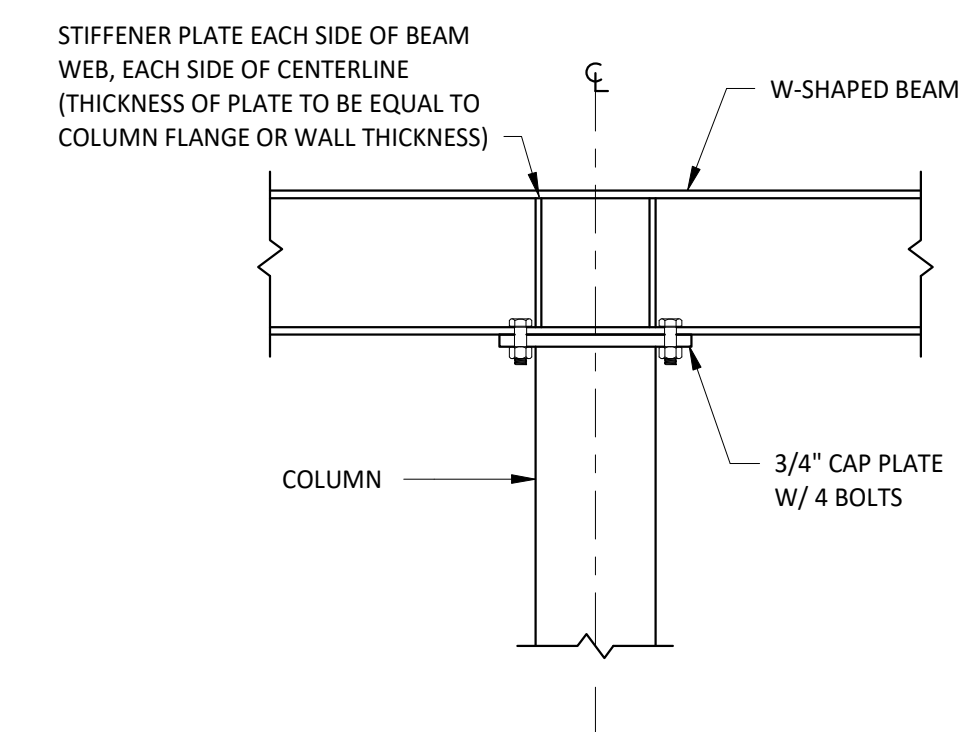

8 DETAIL AT BEAM BEARING AT COLUMN
S5.01 SCALE: 3/4" = 1'-0"

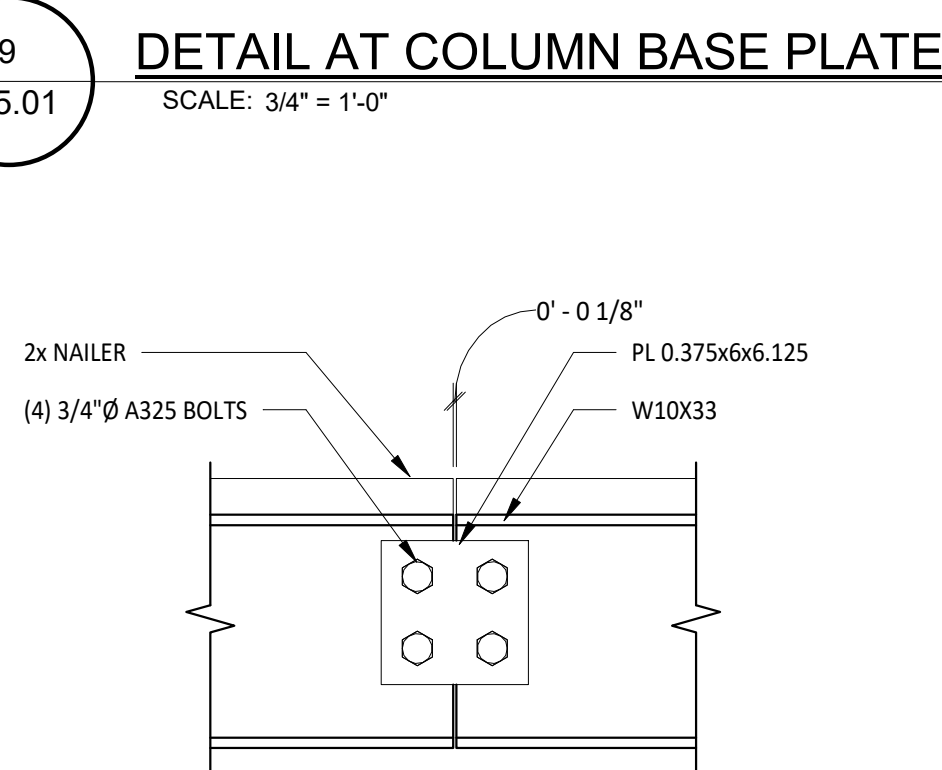

9 DETAIL AT COLUMN BASE PLATE
S5.01 SCALE: 3/4" = 1'-0"

10 DETAIL AT BEAM SPLICE
S5.01 SCALE: 1 1/2" = 1'-0"

| NO. | DATE | BY | DESCRIPTION |
|-----|----------|----|-------------|
| 1 | 4.4.2023 | | Addendum #3 |

BROOKE COUNTY EMS
BROOKE COUNTY COMMISSION
BROOKE COUNTY, WV
4.4.2023
Construction Drawings

DRAWN: PDB DATE: 4/4/2023
CHECKED: PDB DATE: 4/4/2023
APPROVED: MWH DATE: 4/4/2023

PROJECT No. T60-11009.00

STRUCTURAL DETAILS

SHEET No.

S5.01

| NO. | BY | DATE | DESCRIPTION |
|-----|----|------|-------------|
| 1 | | | |

BROOKE COUNTY EMS
 BROOKE COUNTY COMMISSION
 BROOKE COUNTY, WV
 4-4-2023
 Construction Drawings


DRAWN: PFB DATE: 4/4/2023
 CHECKED: PFB DATE: 4/4/2023
 APPROVED: MWH DATE: 4/4/2023

PROJECT No. T60-11009.00


STRUCTURAL DETAILS

SHEET No.

S5.02

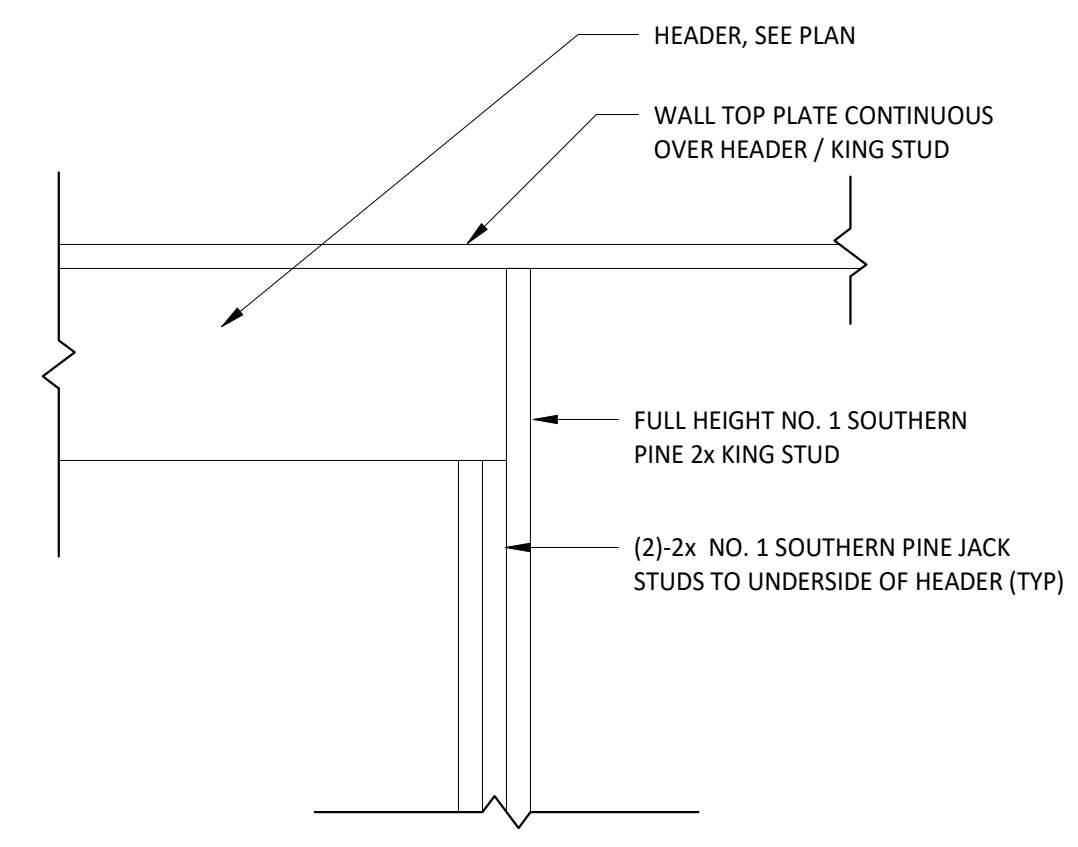


HEADER AT TOP OF WALL

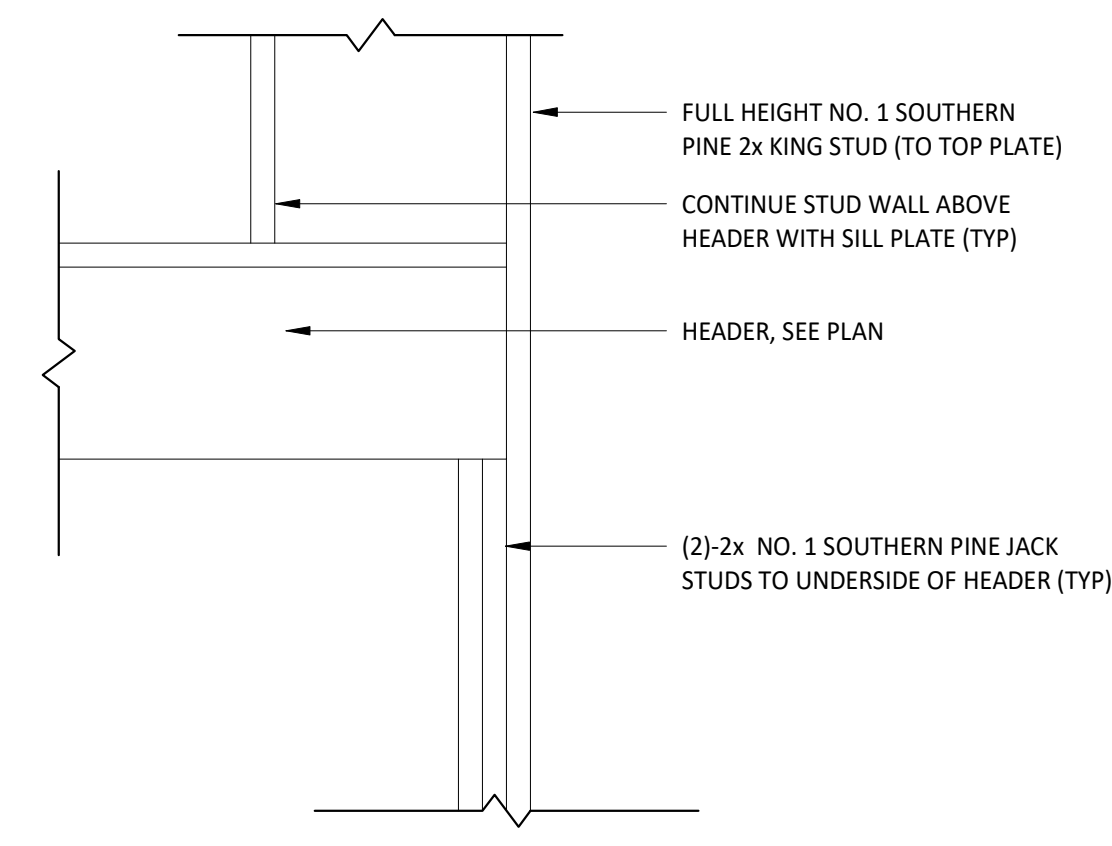


HEADER IN MIDDLE OF WALL


1 S5.02 **DETAIL AT JAMB SUPPORT FOR WOOD HEADERS**
 SCALE: 1" = 1'-0"

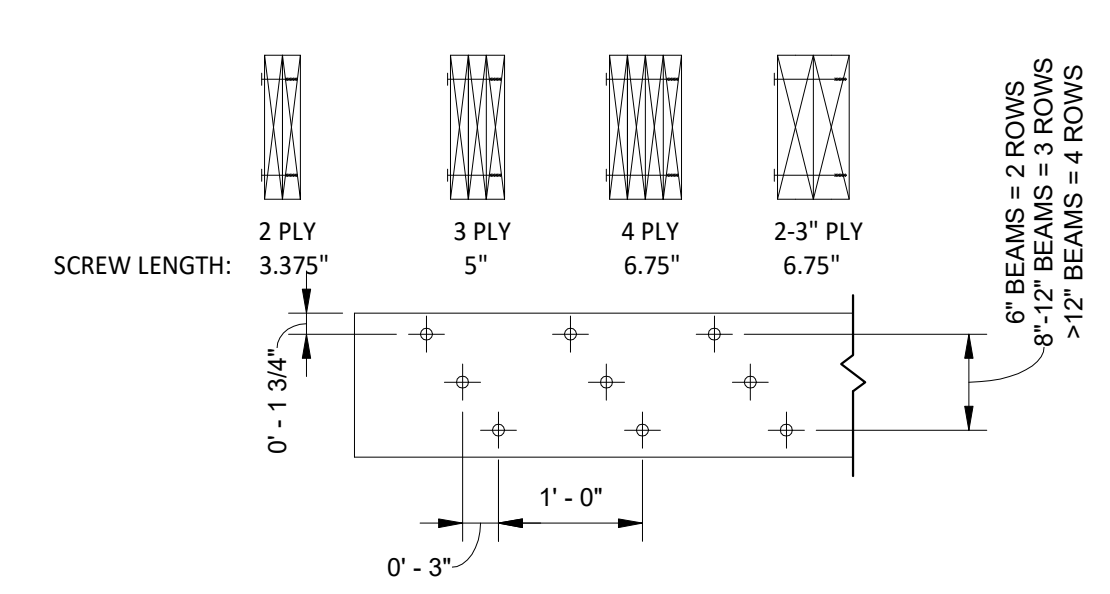


2 S5.02 **DETAIL AT MULTI-PLY WOOD BEAM**
 SCALE: 3/4" = 1'-0"

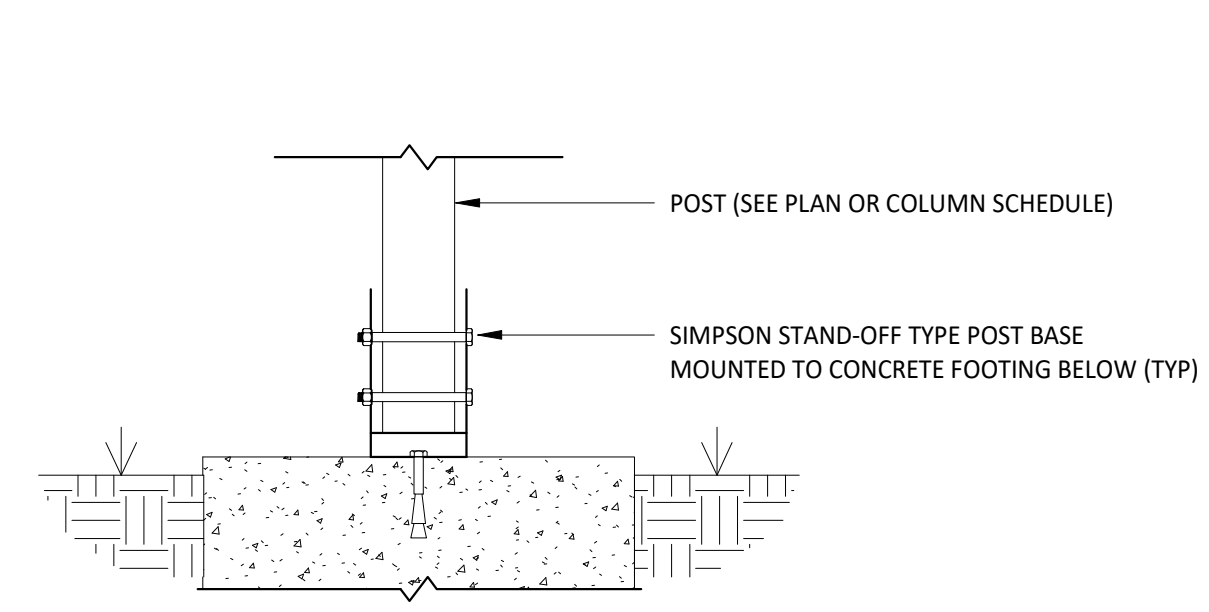


5 S5.02 **DETAIL FOR WOOD POST BASES**
 SCALE: 3/4" = 1'-0"

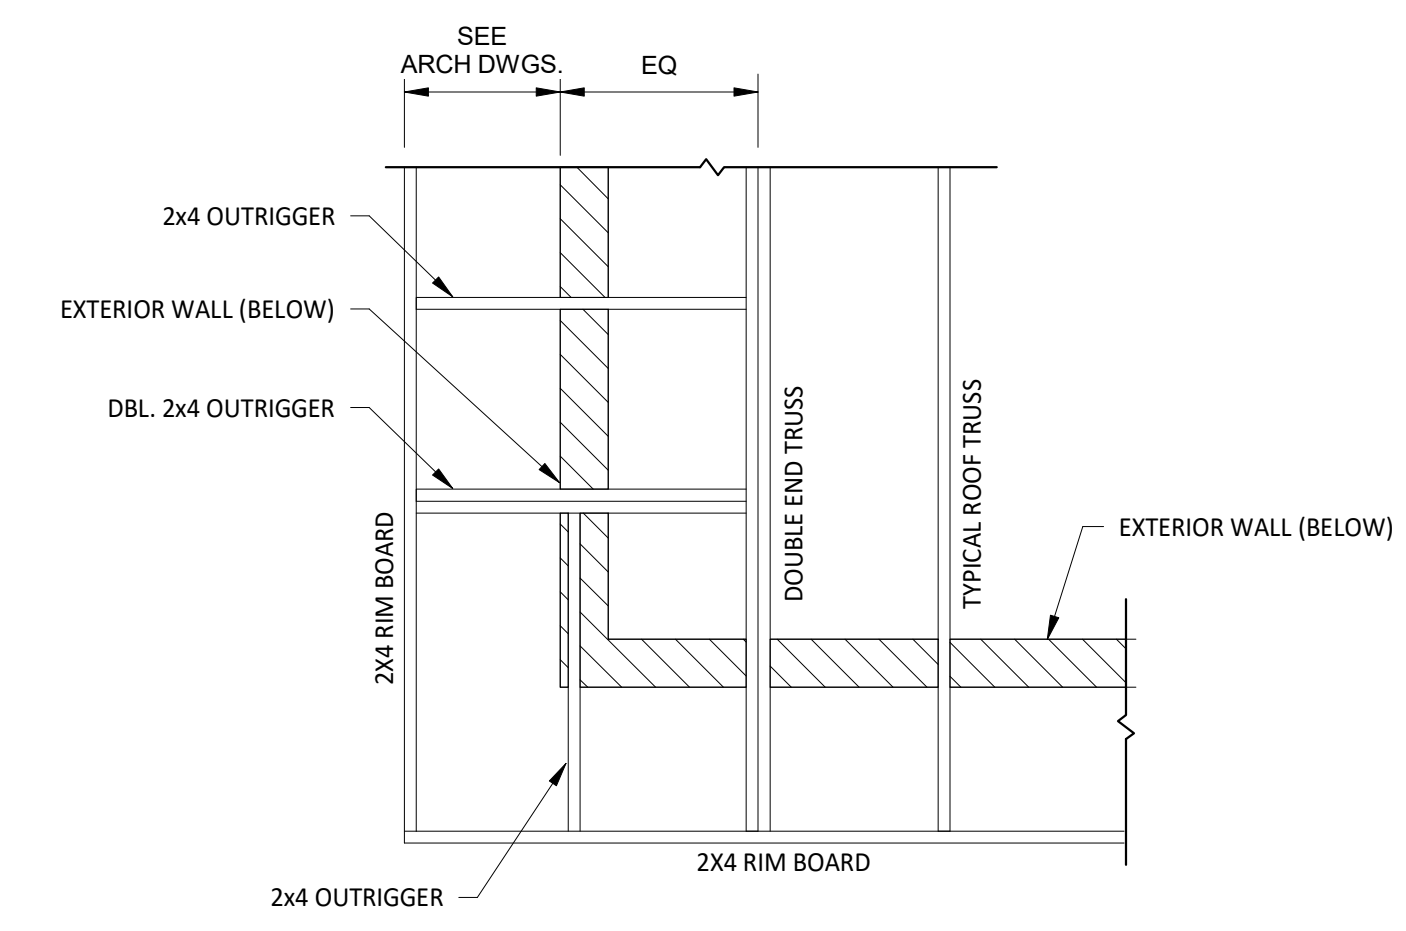

3 S5.02 **DETAIL AT ROOF OUTRIGGER**
 SCALE: 1/2" = 1'-0"

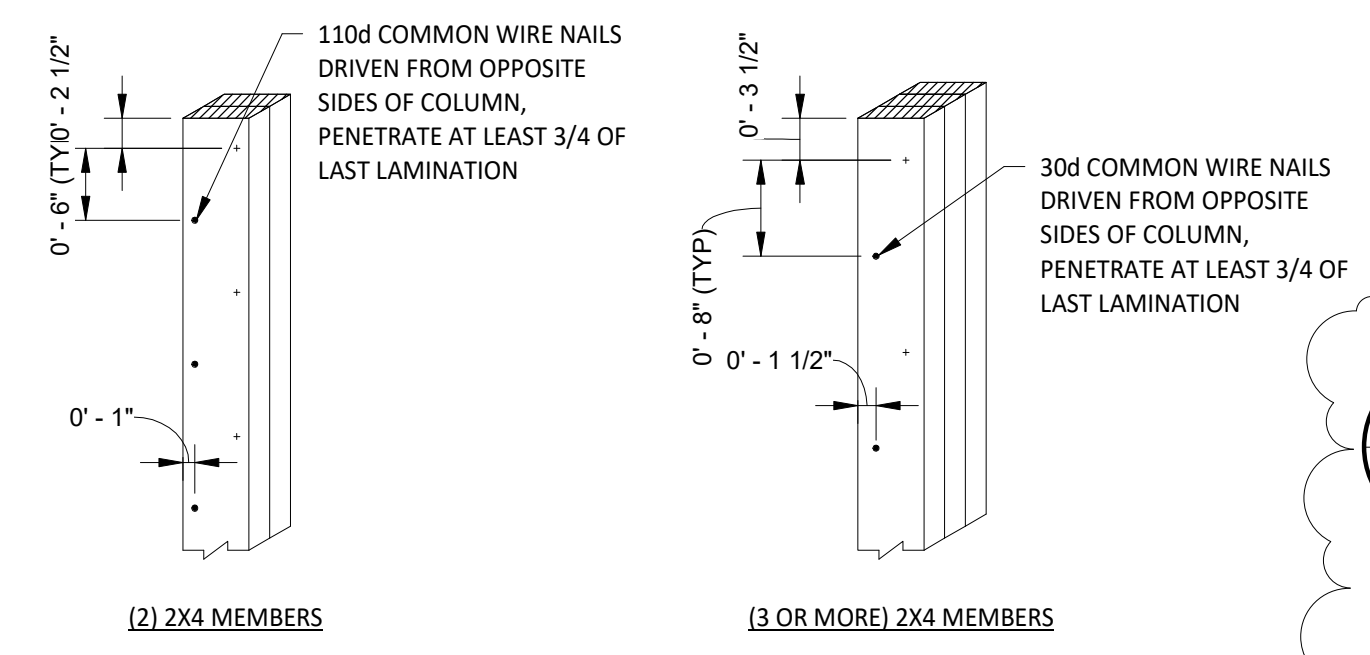


4 S5.02 **DETAIL FOR BUILT UP MULTI-PLY STUD PACKS**
 SCALE: 3/4" = 1'-0"

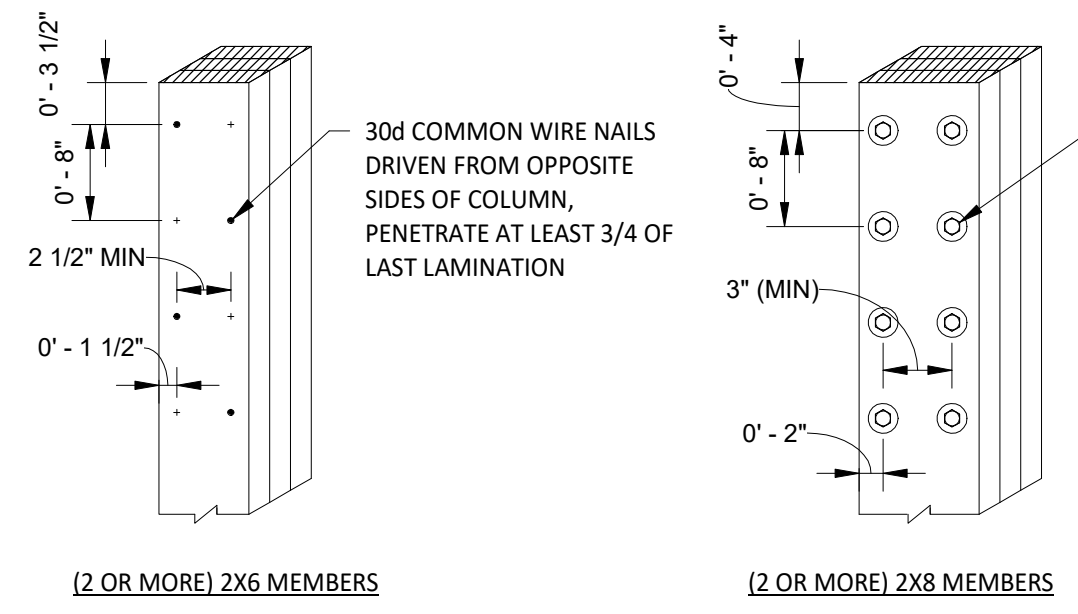


| NON-LOAD BEARING WALL WOOD LINTEL TABLE | | |
|---|-----------------|-----------------------------|
| MAX. ROUGH OPENING | LINTEL | JACK / KING STUDS |
| UP TO 4'-0" | (3) 2x6 NO 1 SP | (1) JACK PLUS (1) KING STUD |
| 4'-1" TO 6'-0" | (3) 2x6 NO 1 SP | (1) JACK PLUS (1) KING STUD |
| 6'-1" TO 8'-0" | (3) 2x8 NO 1 SP | (2) JACK PLUS (1) KING STUD |
| 8'-1" TO 10'-0" | (3) 2x8 NO 1 SP | (2) JACK PLUS (1) KING STUD |
| OVER 10'-0" | SEE PLAN | SEE PLAN |


NOTES:
 - MULTI PLY 2x LINTELS TO HAVE 1/2" SPACER BETWEEN PLYES
 - USE HANGERS WITH CONCEALED FLANGES FOR HEADER AND MIN 6x6 POSTS AT SPANS GREATER THAN 10'-0"

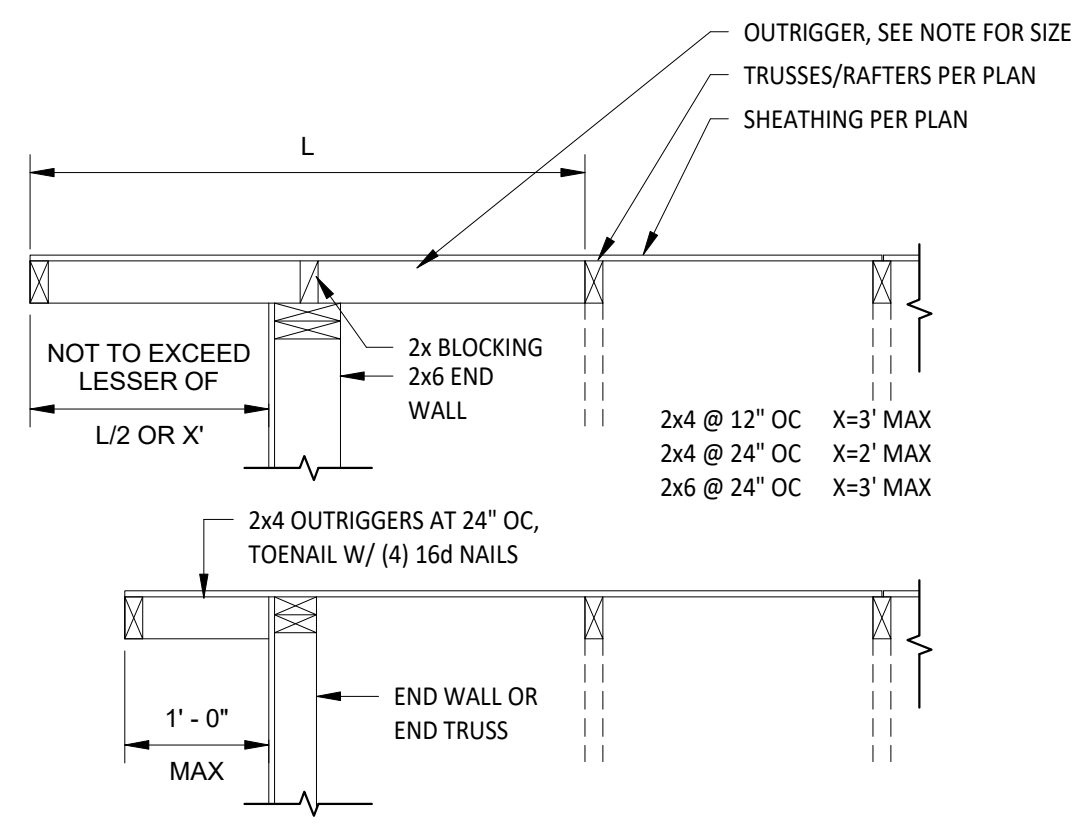


8 S5.02 **OUTRIGGER DETAIL**
 SCALE: 3/4" = 1'-0"

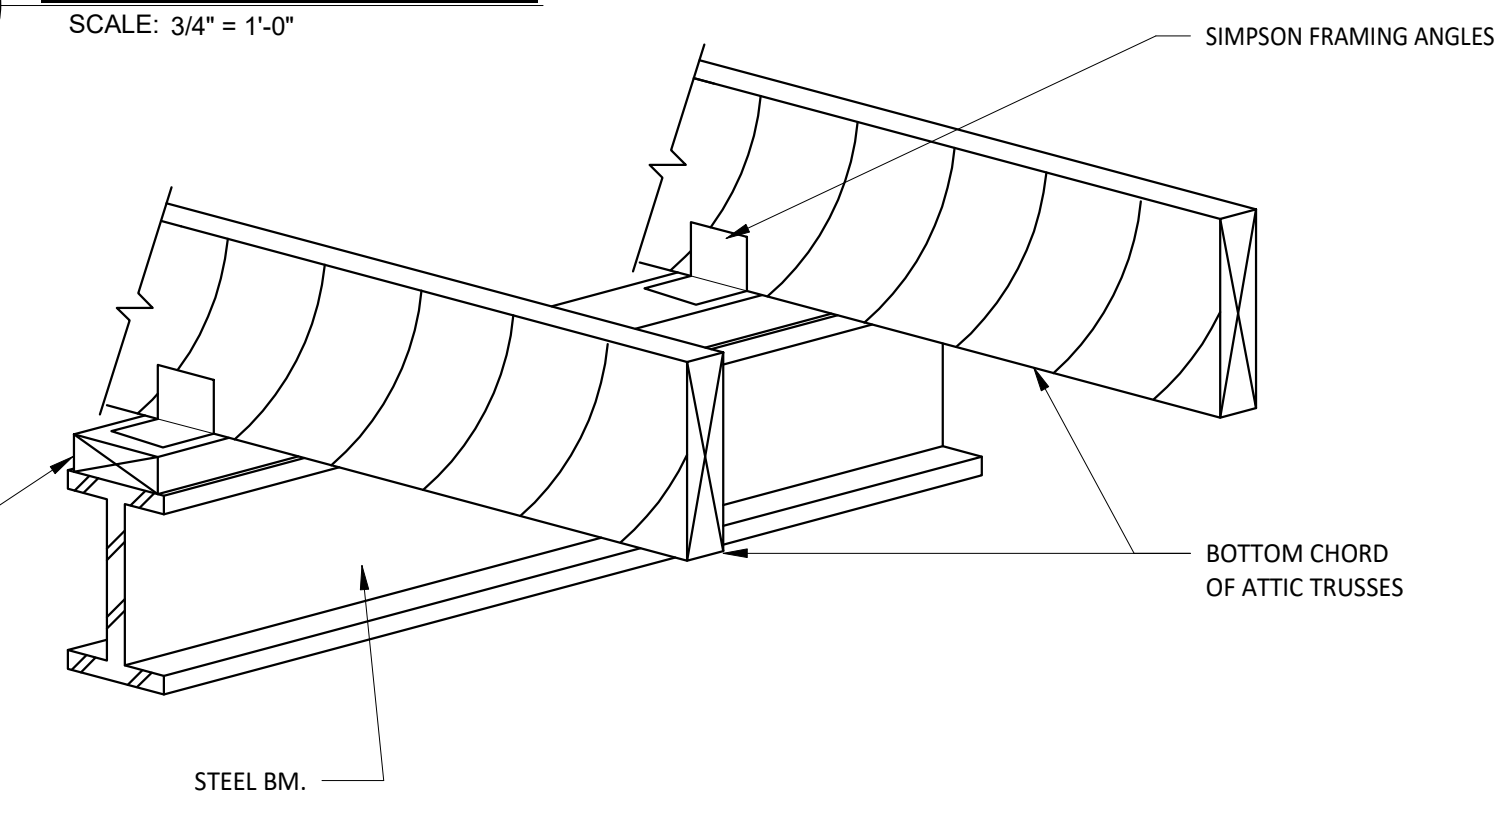


9 S5.02 **TYPICAL WOOD JOIST HANGER @ STEEL BEAM DETAIL**
 SCALE: 3/4" = 1'-0"

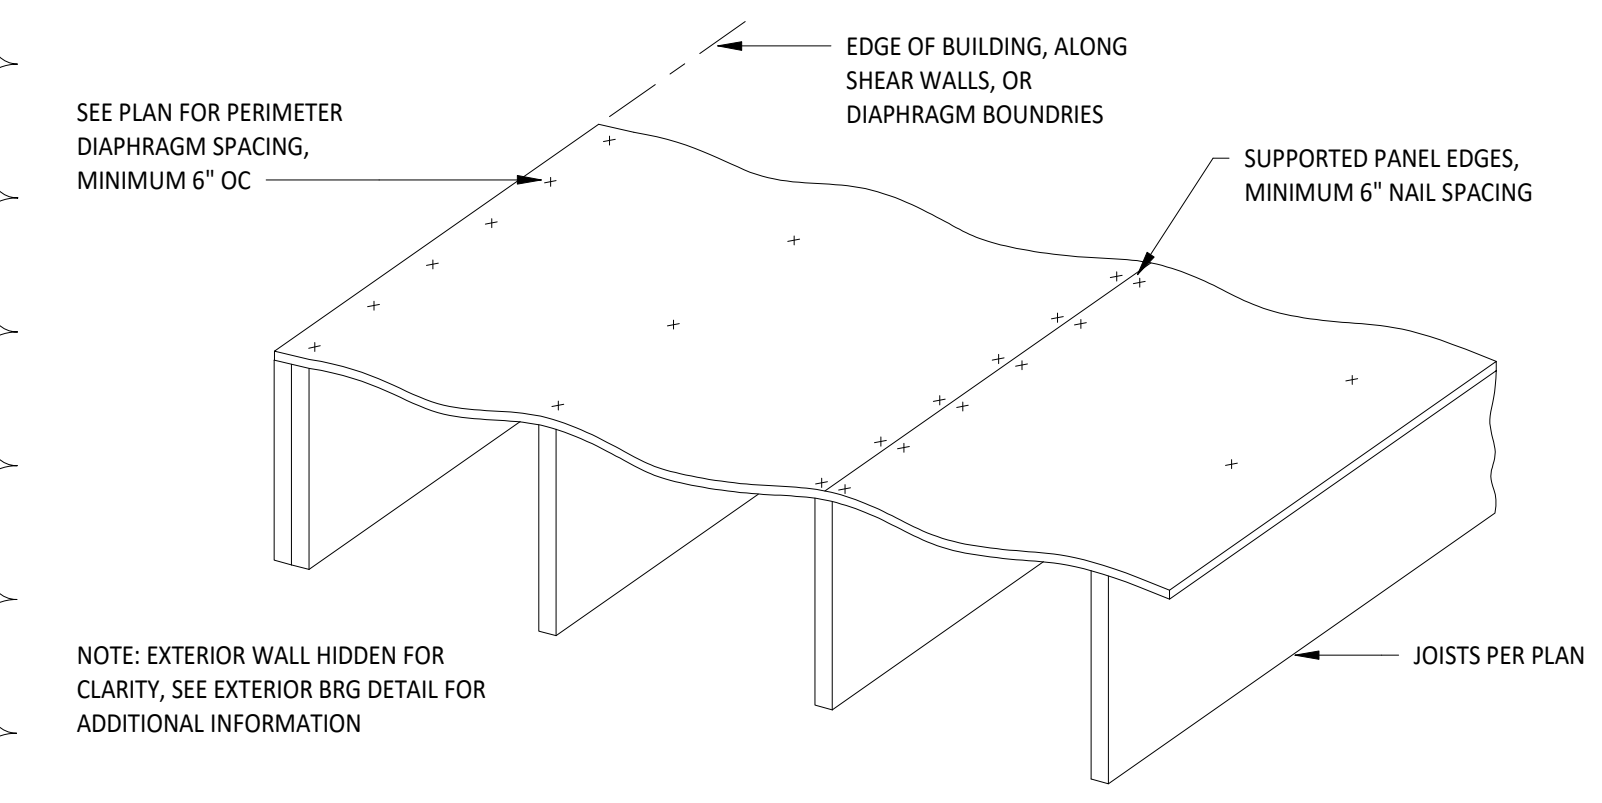


10 S5.02 **DIAPHRAGM NAILING DETAIL**
 SCALE: 3/4" = 1'-0"

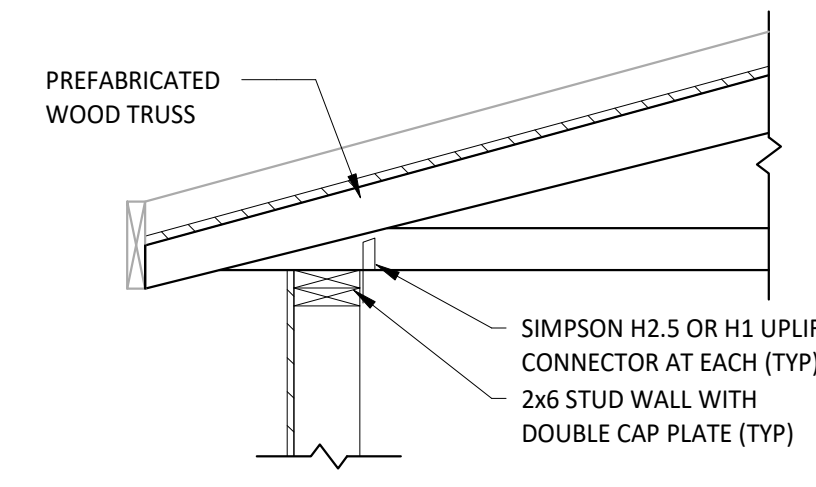

6 S5.02 **WOOD TRUSS BEARING DETAIL**
 SCALE: 3/4" = 1'-0"

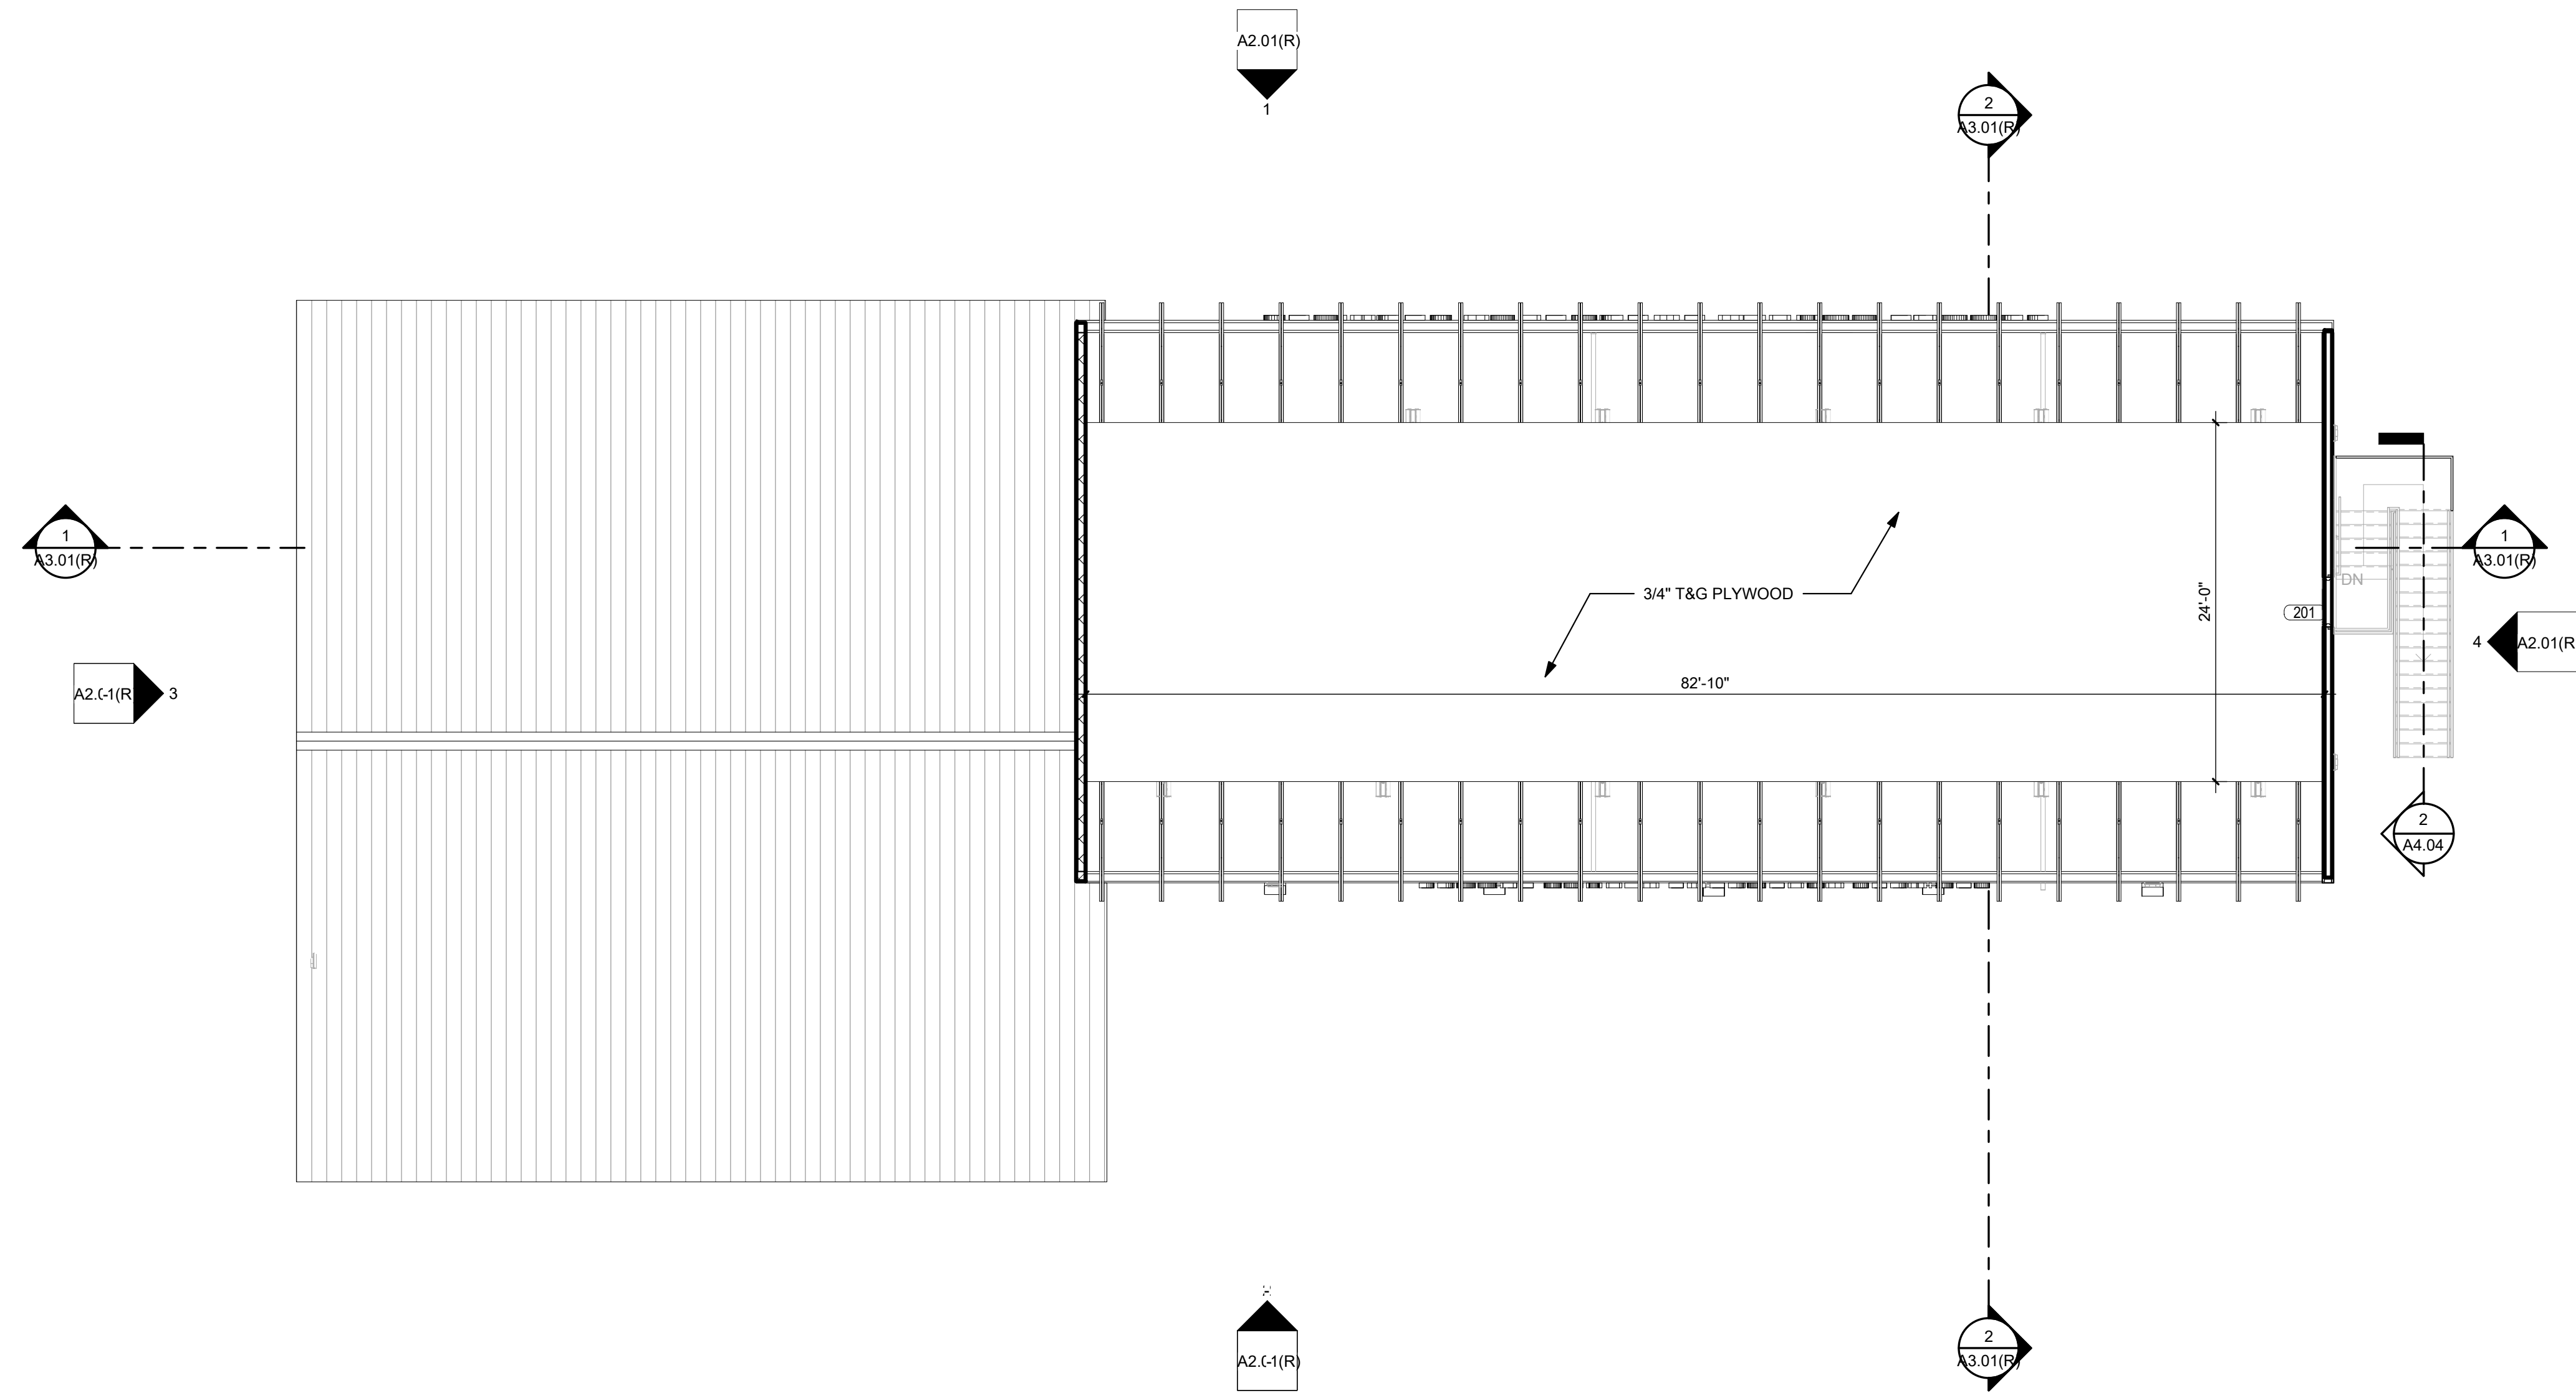

1 ATTIC PLAN
A1.04 1/8" = 1'-0"

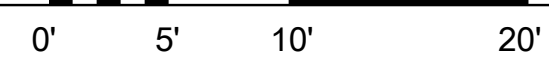

USER: Author

PLOT DATE/TIME: 4/4/2023 10:03:37 AM

LAYOUT TAB: ATTIC PLAN
CAD FILE: R:\0501765-1109-A2-Brooke EMS-Brooke County Commission-Drawing\Rev\02020324_Brooke EMS_CD_2022.rvt

| No. | BY | DATE | DESCRIPTION |
|-----|----|------|-------------|
| | | | |
| | | | |
| | | | |

BROOKE COUNTY EMS
BROOKE COUNTY COMMISSION
3031 PLEASANT AVE, WELLSBURG WV 26070
FEBRUARY 24, 2023
CONSTRUCTION DOCUMENTS


DRAWN: Author DATE: 03/29/23
CHECKED: Checker DATE: 03/29/23

PROJECT No. T60-11009.00

ATTIC PLAN


SHEET No.

A1.04

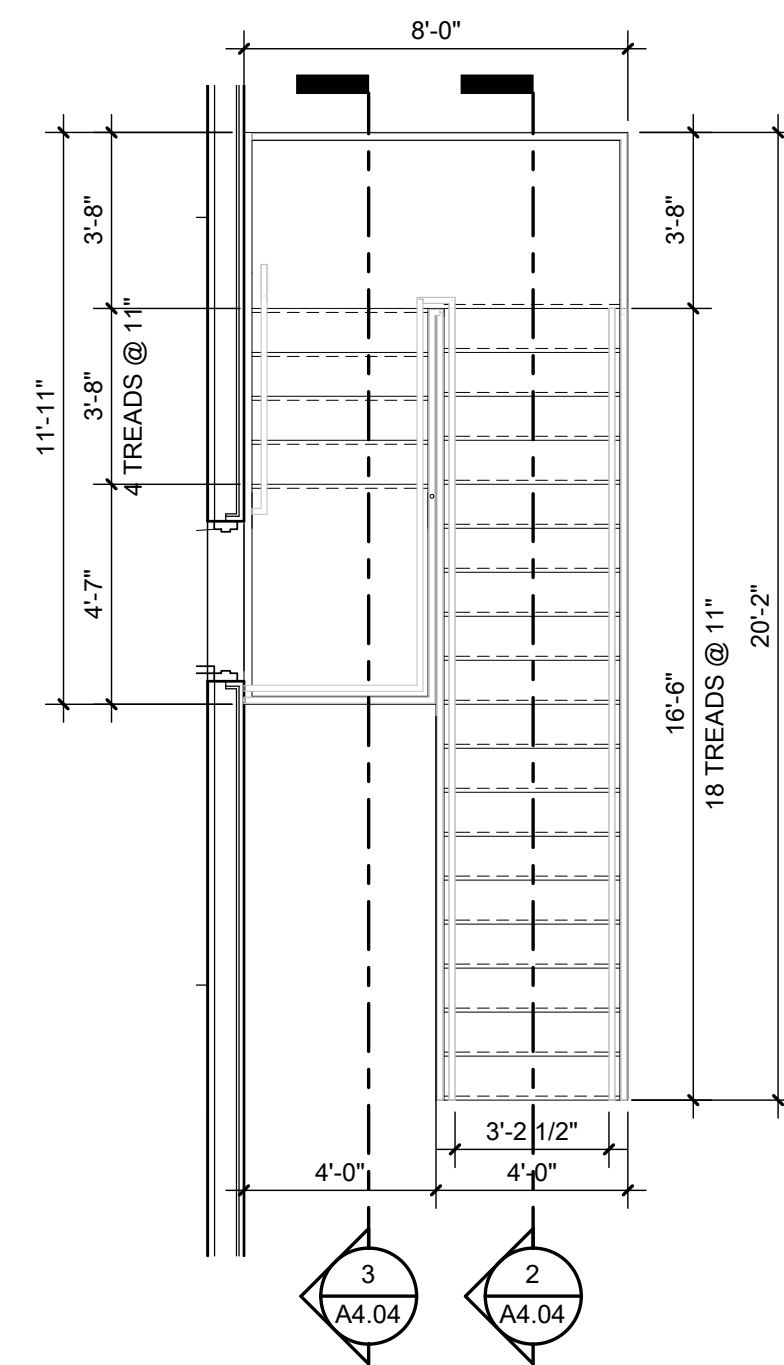


1 EXTERIOR STAIR PLAN

A4.04 1/4" = 1'-0" 0' 2'-6" 5' 10'

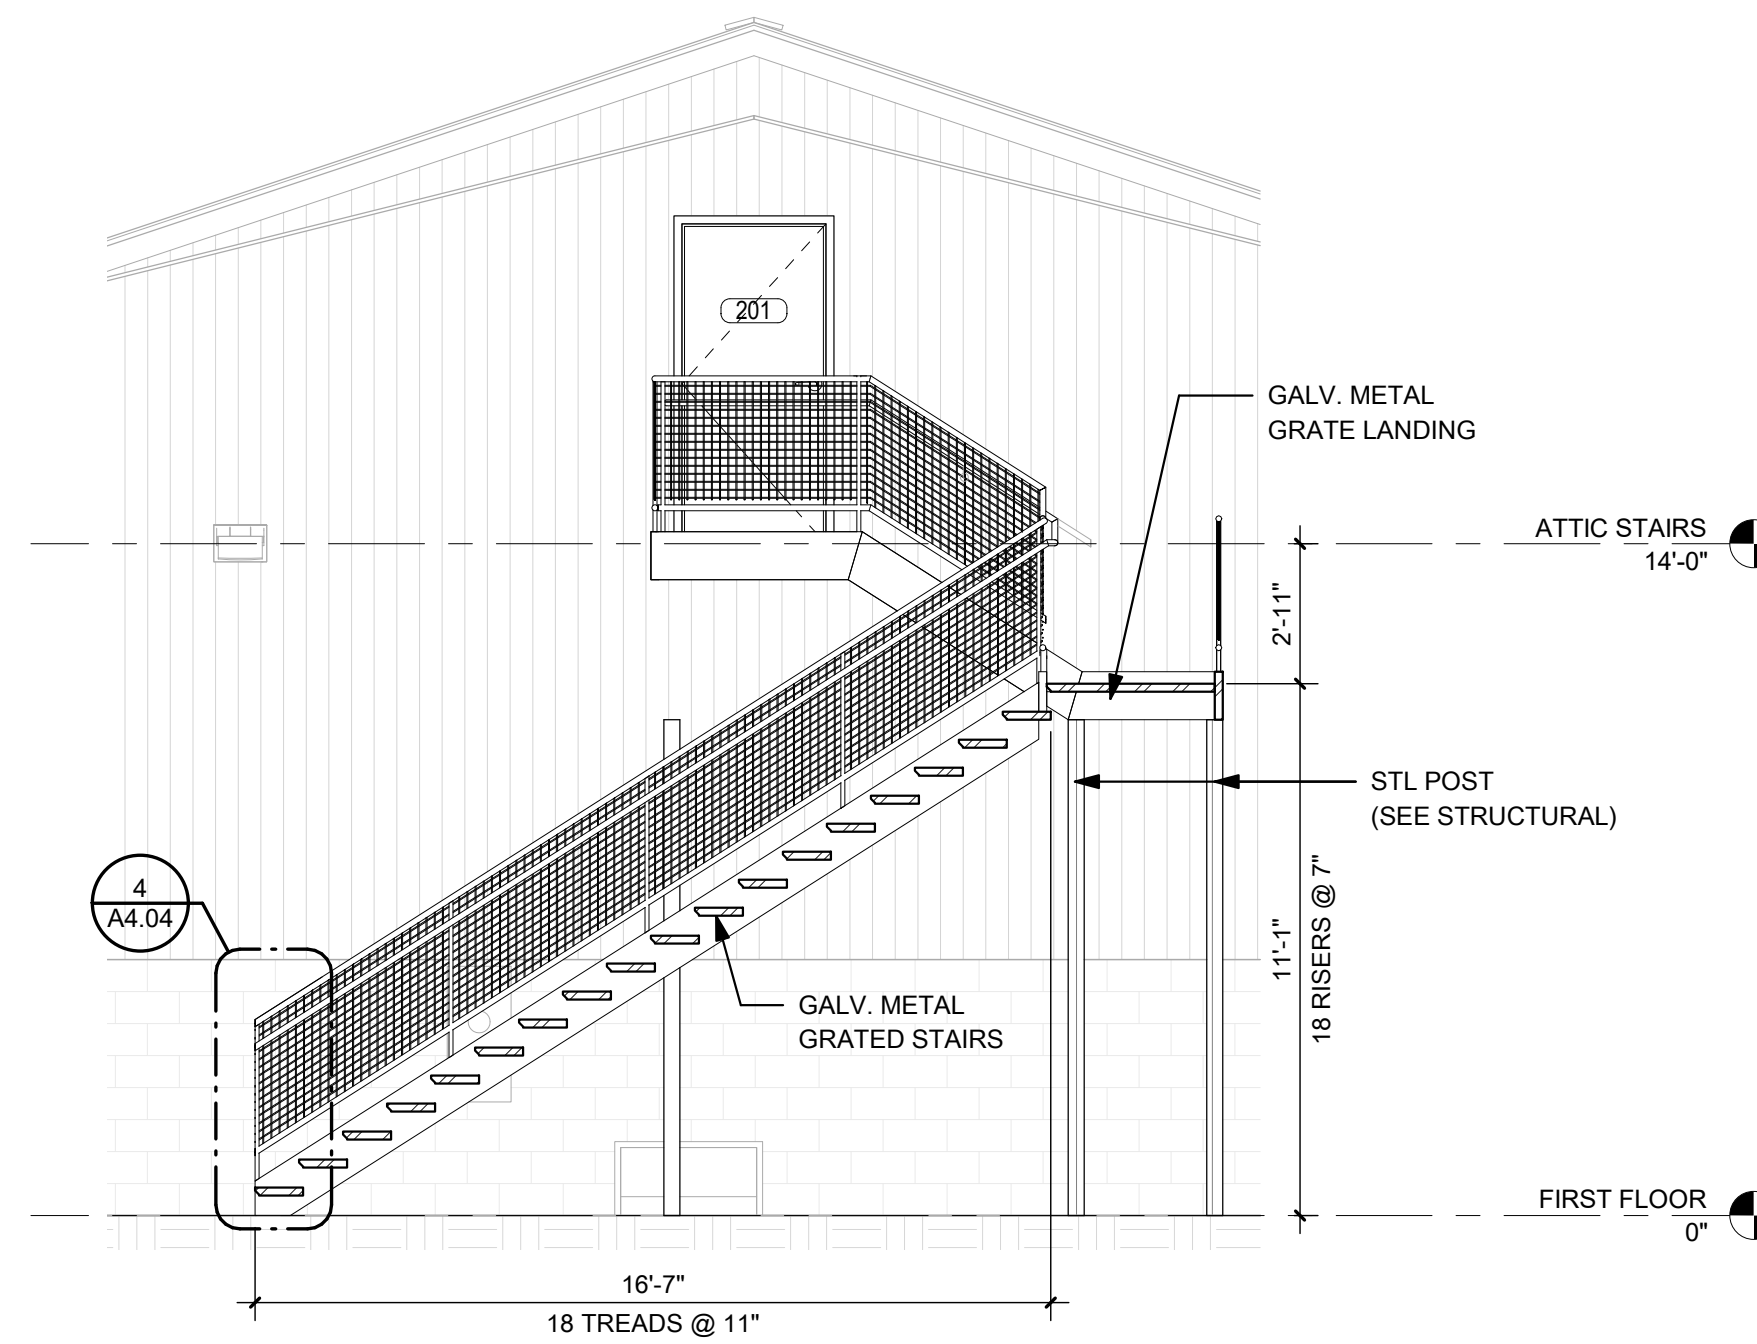


2 EXTERIOR STAIR SECTION

A4.04 1/4" = 1'-0" 0' 2'-6" 5' 10'

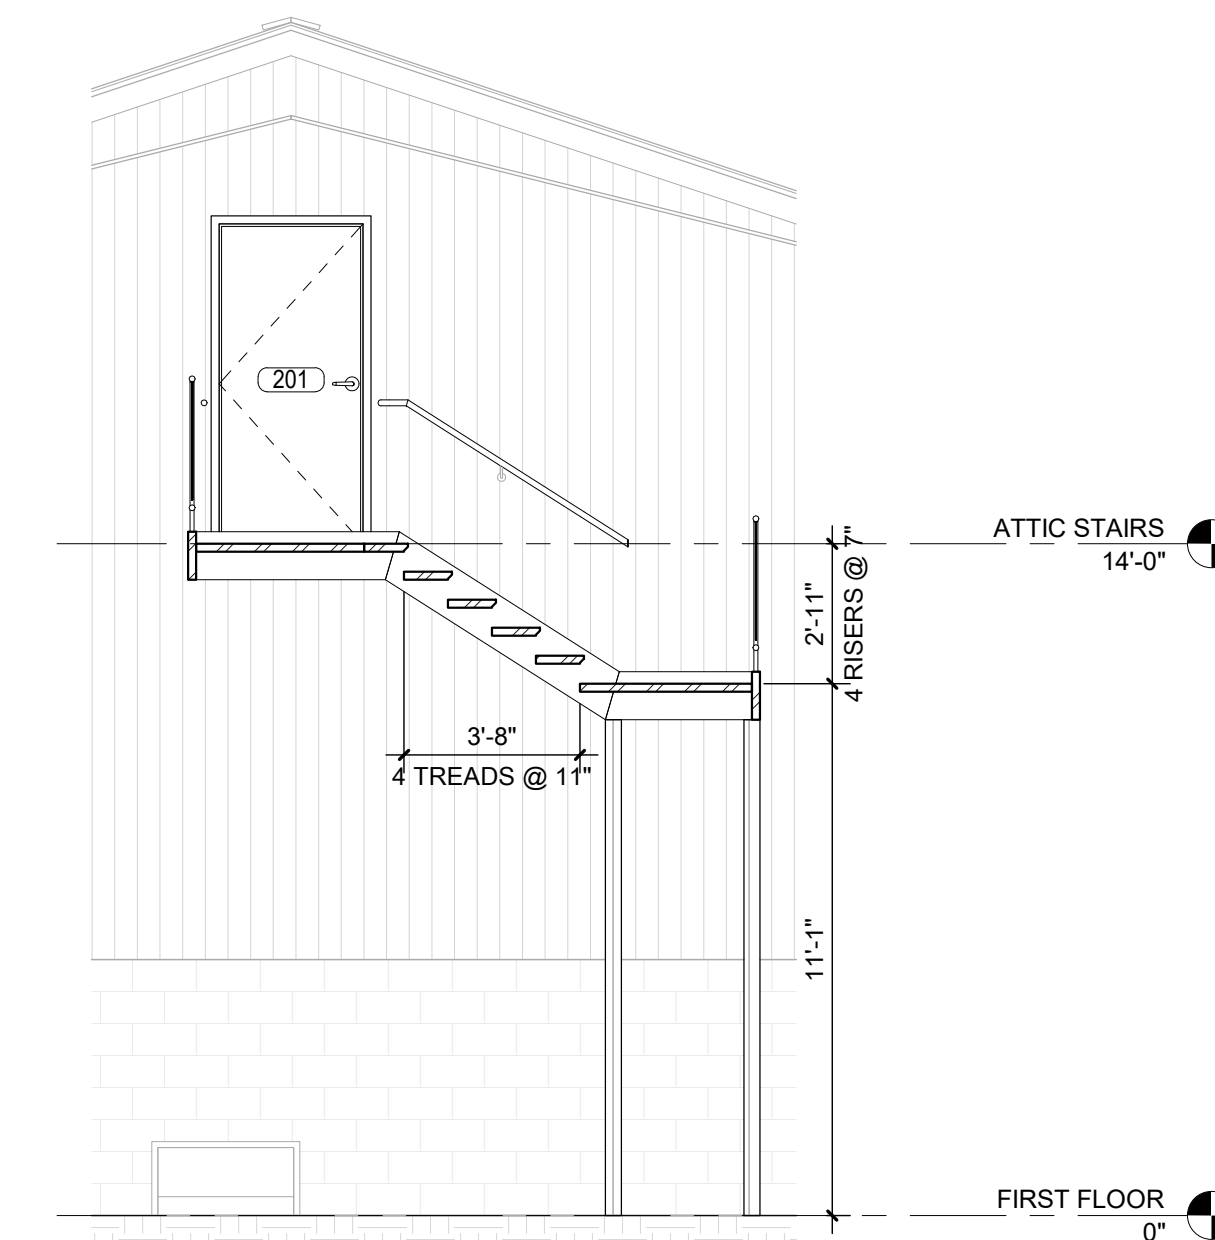


3 EXTERIOR STAIR SECTION 2

A4.04 1/4" = 1'-0" 0' 2'-6" 5' 10'

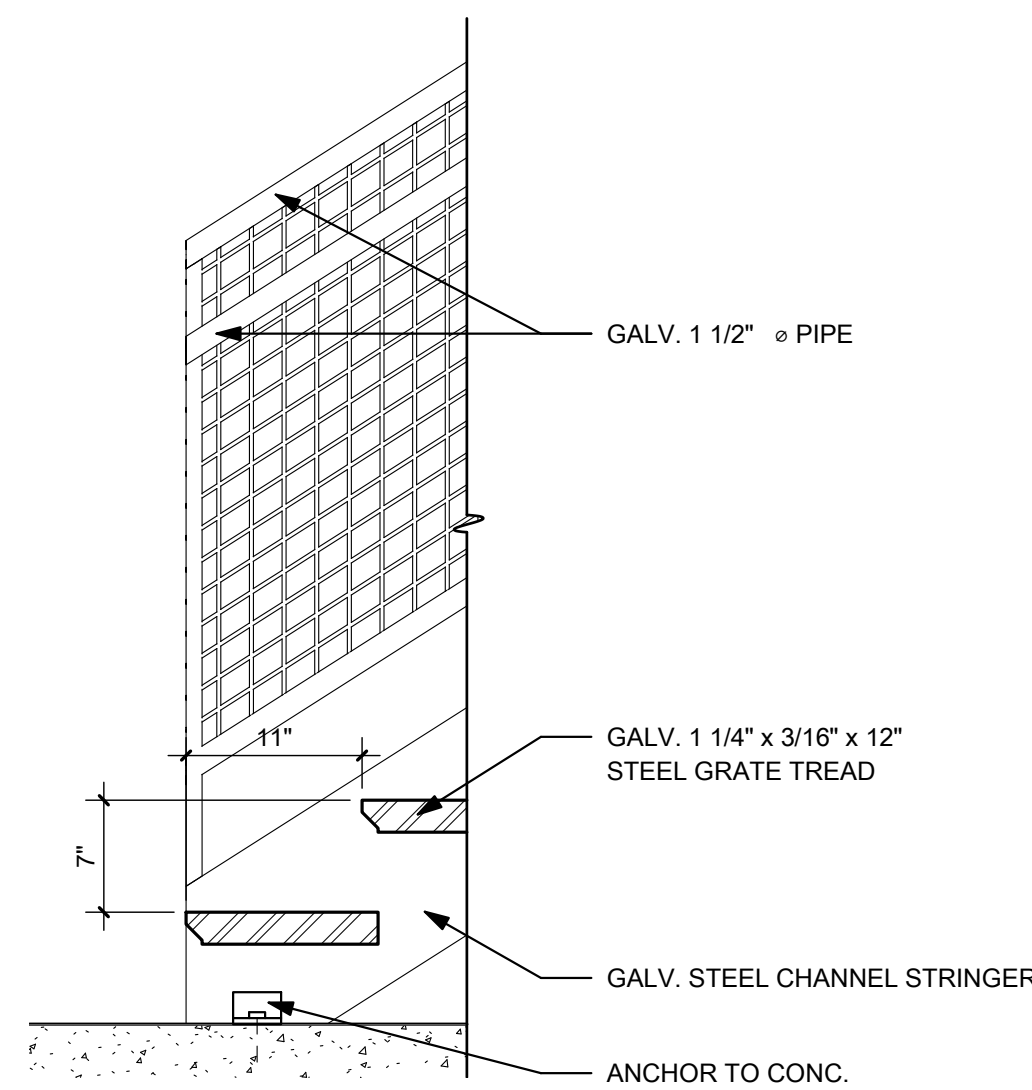


4 DETAIL - EXTERIOR STAIRS

A4.04 1" = 1'-0"

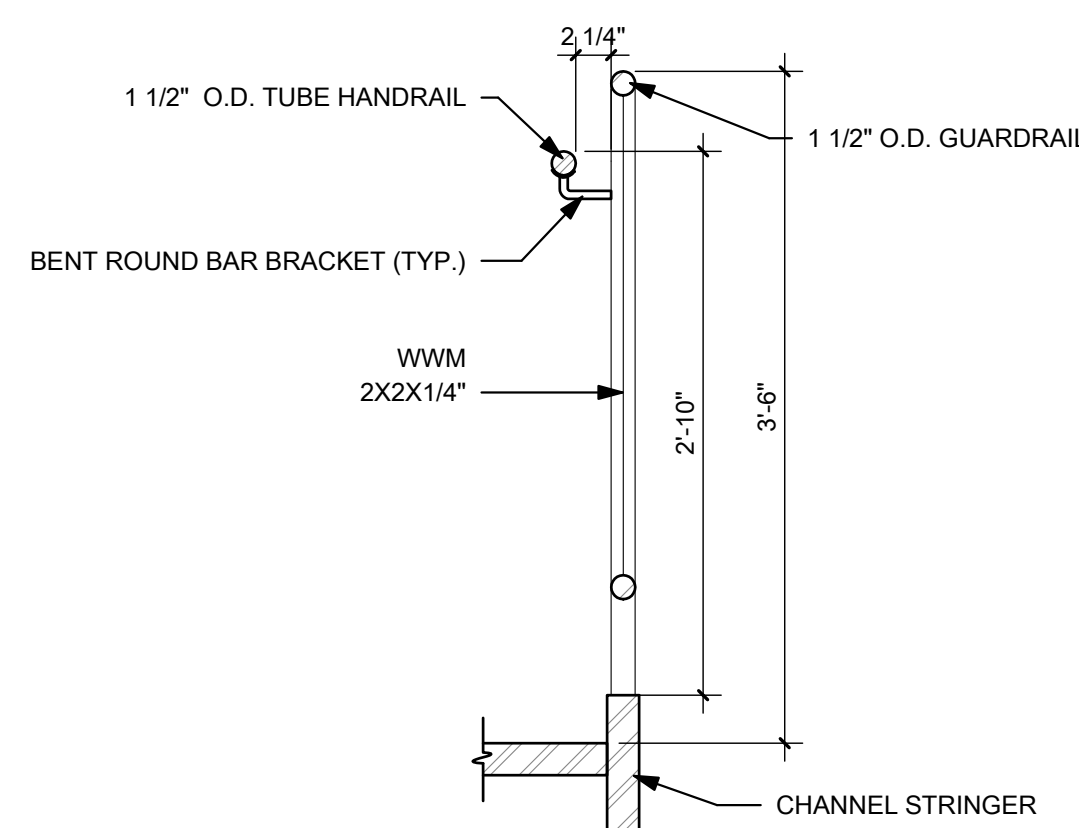

5 STAIRS/RAILING - STAIR RAILING

A4.04 1" = 1'-0"

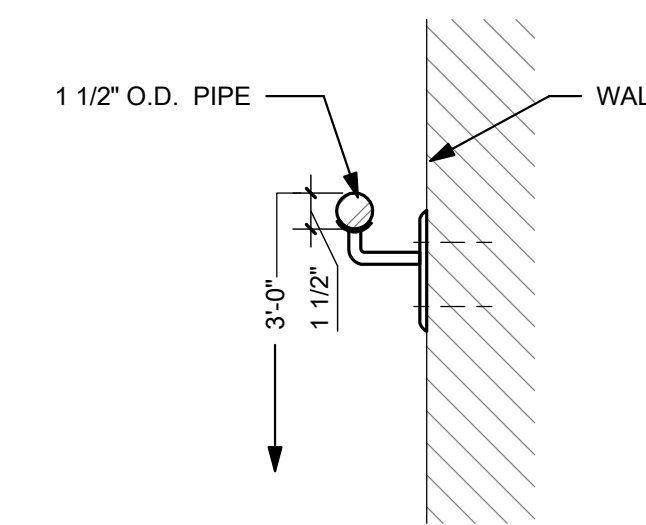

6 STAIRS/RAILING - STAIR RAILING MOUNT

A4.04 1 1/2" = 1'-0"

| NO. | BY | DATE | DESCRIPTION |
|-----|----|------|-------------|
| | | | |
| | | | |
| | | | |

BROOKE COUNTY EMS
BROOKE COUNTY COMMISSION
3031 PLEASANT AVE, WELLSBURG WV 26070
FEBRUARY 24, 2023
CONSTRUCTION DOCUMENTS

DRAWN: Author DATE: 03/27/23
CHECKED: Checker DATE: 03/27/23

PROJECT No. T60-11009.00

EXTERIOR STAIRS


SHEET No.

A4.04



Harper
Engineering

52 B Street
St Albans, WV 25177
p. 304.722.3602 f. 304.722.3603

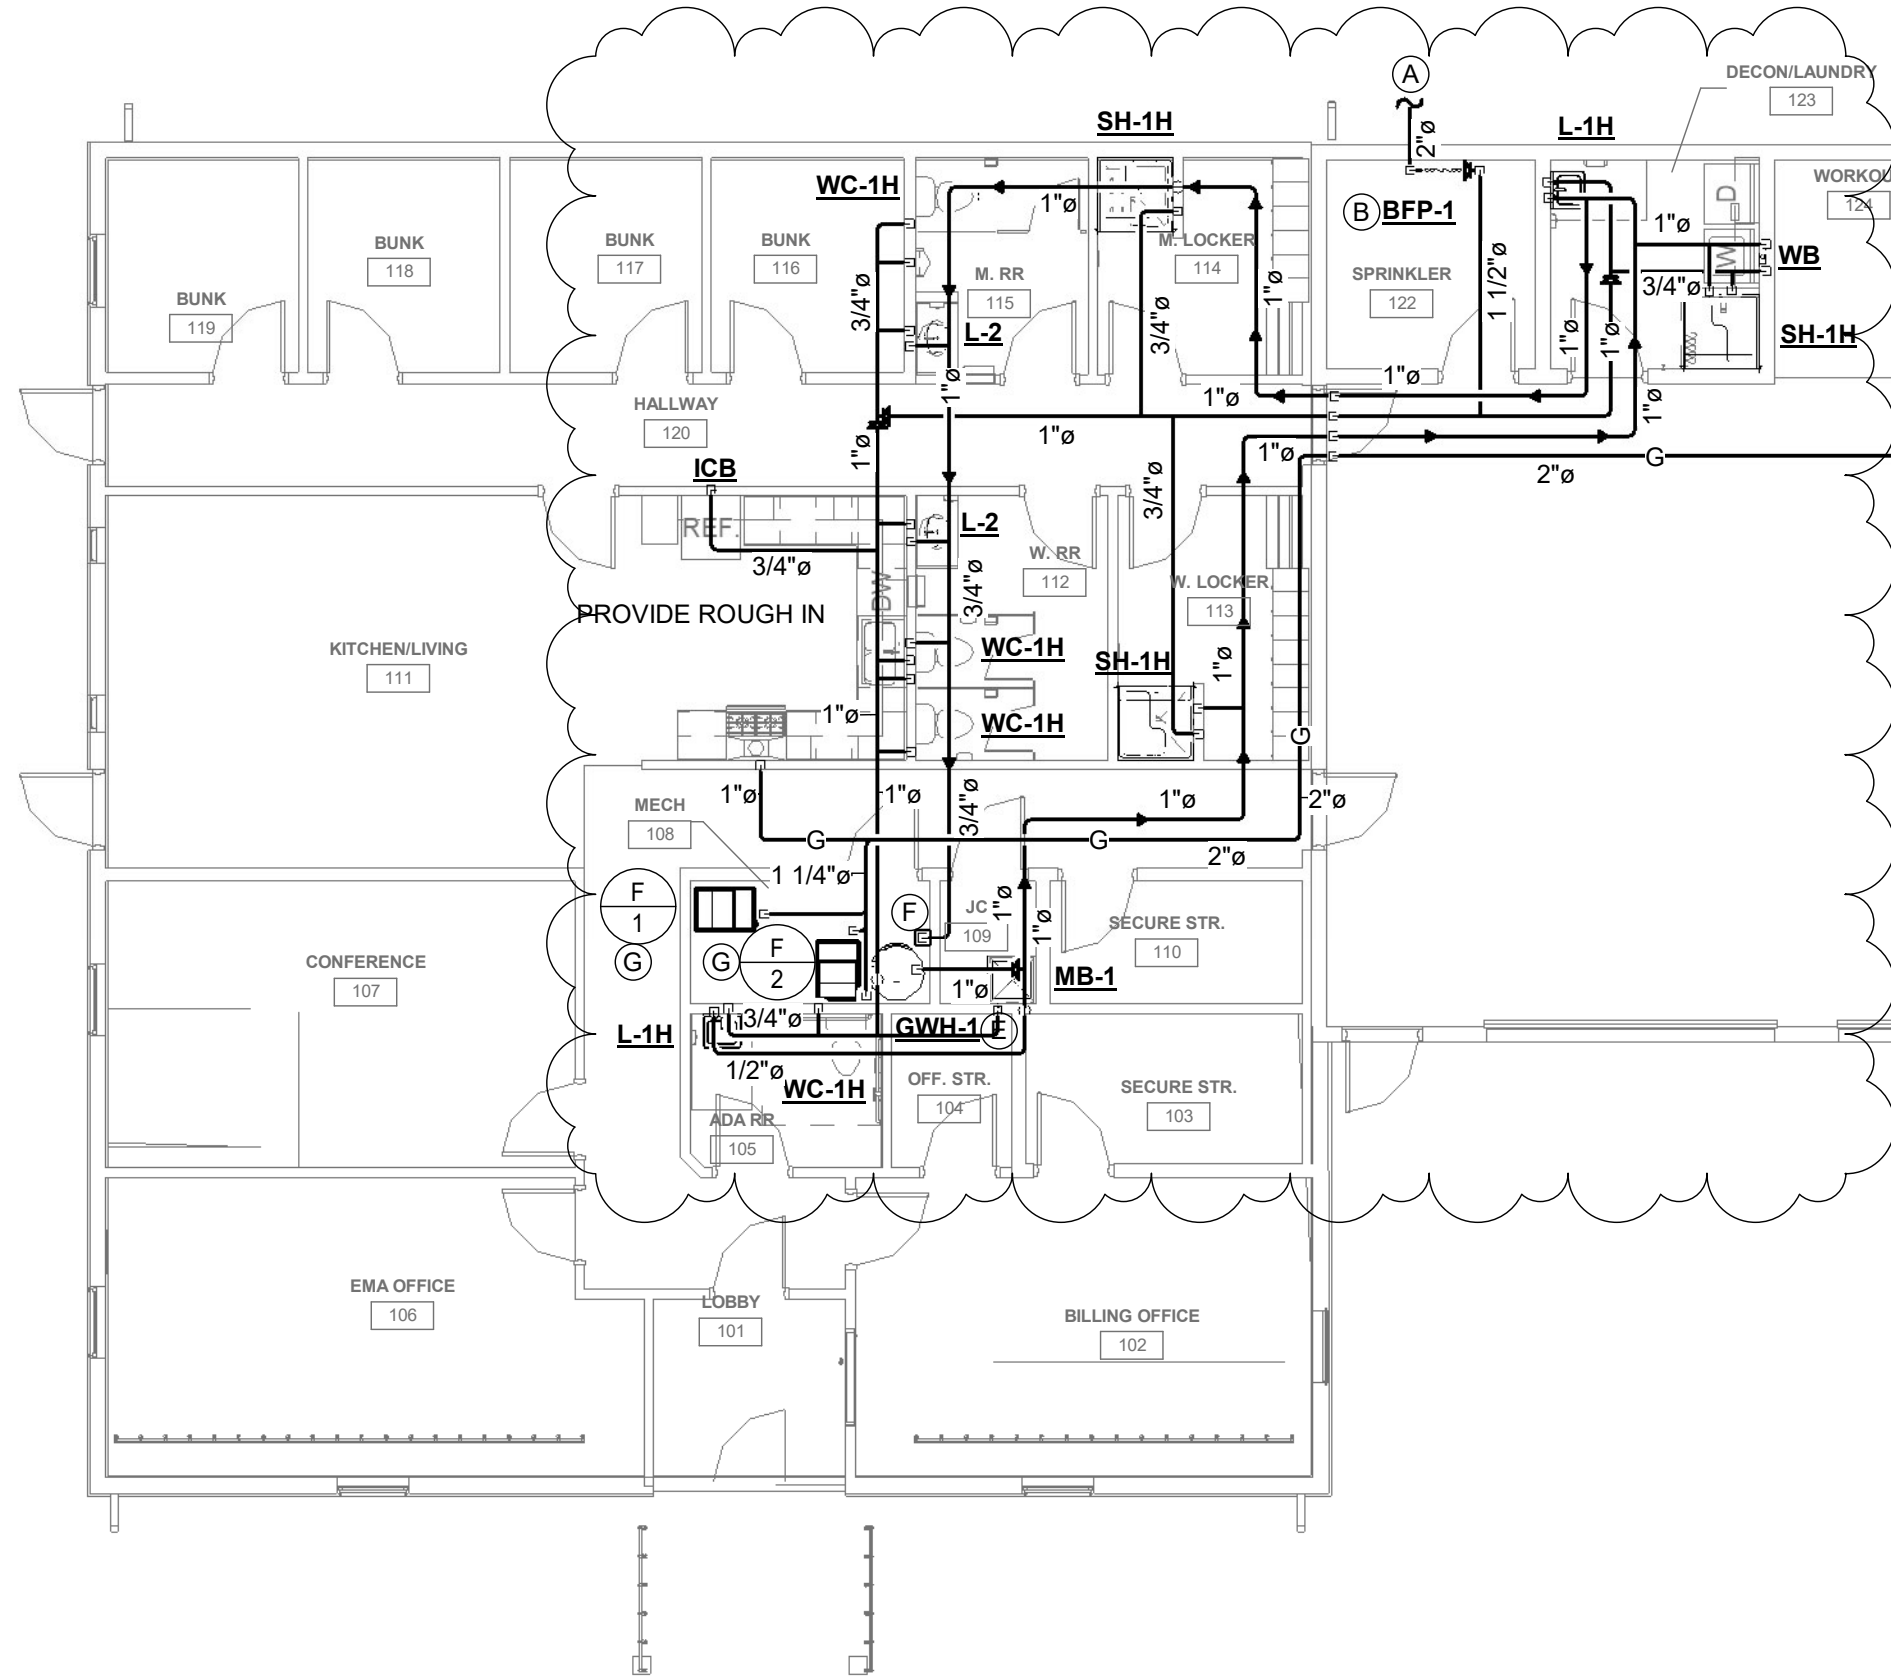

1 UPDATED FIRST FLOOR PIPING SIZE
 SK-P3 1/8" = 1'-0"

CONSTRUCTION DOCUMENTS
 BROOKE COUNTY EMS


3031 PLEASANT AVE, WELLSBURG, WV 26070

SK-P3



Harper
Engineering

52 B Street
St Albans, WV 25177
p. 304.722.3602 f. 304.722.3603

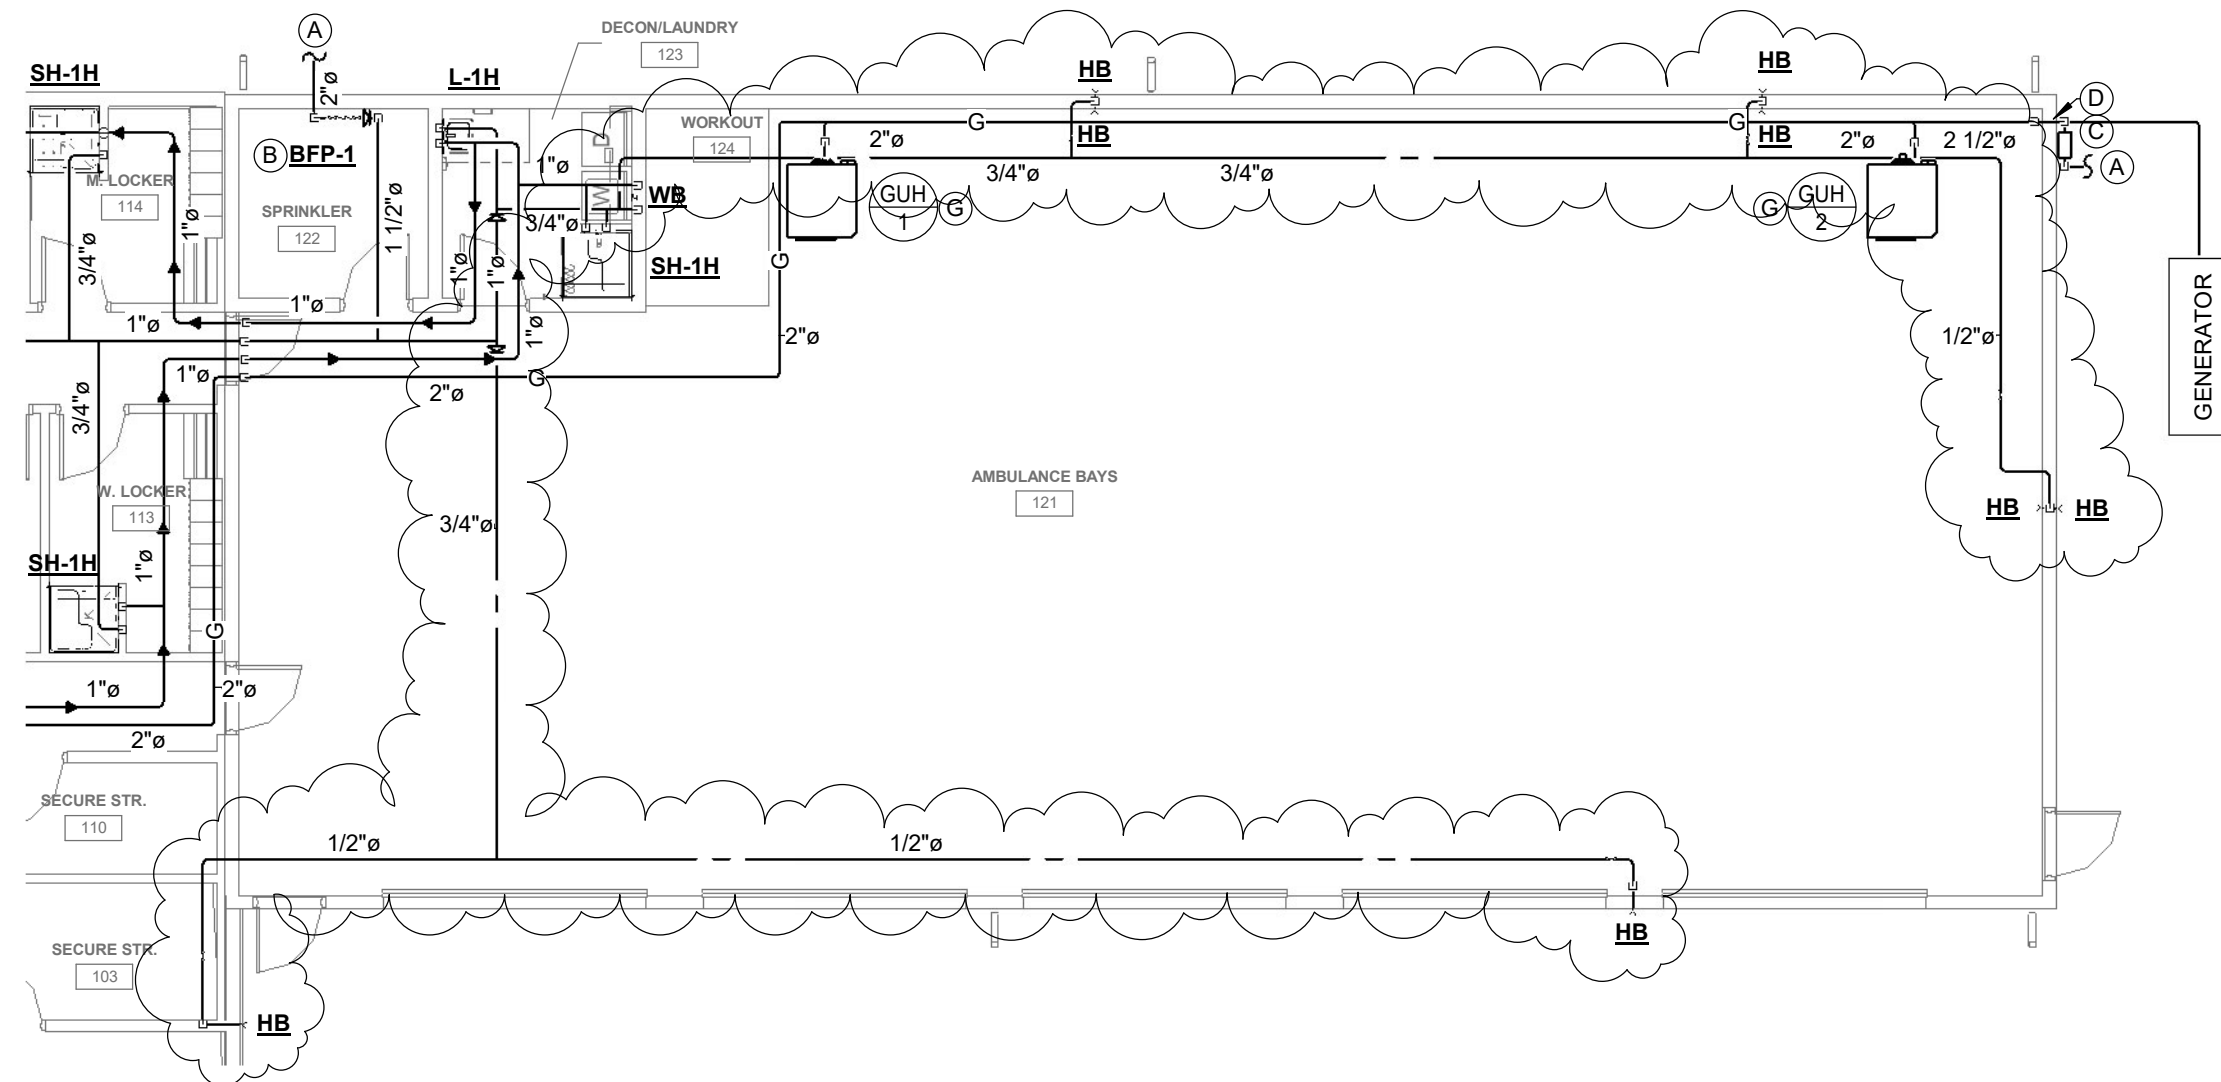

1 HOSE BIBB SKETCH
SK-P4 1/8" = 1'-0"

**CONSTRUCTION DOCUMENTS
BROOKE COUNTY EMS**

3031 PLEASANT AVE, WELLSBURG, WV 26070

SK-P4

Date: 04/01/23

SUBSTITUTION REQUEST (During the Bidding/Negotiating Stage)

| | | |
|--|--|--|
| Project: <u>Brooke County EMS Facility (23-074287)</u> | Substitution Request Number: <u>SubReq-26249</u> | |
| <u>Wellsburg, WV</u> | From: <u>Erik Muir, Scranton Products</u> | |
| To: <u>Philip Freeman, The Thrasher Group (Bridgeport)</u> | Date: <u>03/21/2023</u> | |
| <u>pfreeman@thethrashergroup.com, (304) 624-4108</u> | A/E Project Number: _____ | |
| Re: <u>Metal Lockers</u> | Contract For: <u>Brooke County Commission</u> | |

| | |
|---|------------------------------------|
| Specification Title: <u>Metal Lockers</u> | Description: <u>Locker Benches</u> |
| Section: <u>105113</u> Page: <u>3</u> | Article/Paragraph: <u>2.4</u> |

| | | | |
|---|--------------------------------------|----------------------------|--|
| Proposed Substitution: <u>Tufftec Bench</u> | | | |
| Manufacturer: <u>Scranton Products</u> | Address: <u>scrantonproducts.com</u> | Phone: <u>570-348-0997</u> | |
| Trade Name: <u>Scranton Tufftec Bench</u> | Model No.: <u>N/A</u> | | |

Attached data includes product description, specifications, drawings, photographs, and performance and test data adequate for evaluation of the request; applicable portions of the data are clearly identified.

Attached data also includes a description of changes to the Contract Documents that the proposed substitution will require for its proper installation.

The Undersigned certifies:

- Proposed substitution has been fully investigated and determined to be equal or superior in all respects to specified product.
- Same warranty will be furnished for proposed substitution as for specified product.
- Same maintenance service and source of replacement parts, as applicable, is available.
- Proposed substitution will have no adverse effect on other trades and will not affect or delay progress schedule.
- Proposed substitution does not affect dimensions and functional clearances.

| | |
|--|--|
| Submitted by: <u>Erik Muir</u> | |
| Signed by: <u>Erik Muir</u> | |
| Firm: <u>Scranton Products</u> | |
| Address: <u>801 E. Corey Street</u> | |
| <u>Scranton, Pennsylvania 18504</u> | |
| Telephone: <u>(570) 348-0997, erik.muir@azekco.com</u> | |

A/E' s REVIEW AND ACTION

- Substitution approved - Make submittals in accordance with Specification Substitution Procedures.
- Substitution approved as noted - Make submittals in accordance with Specification Substitution Procedures.
- Substitution rejected - Use specified materials.
- Substitution Request received too late - Use specified materials.

Signed by: _____ **Date:** _____

Supporting Data Attached: Drawings Product Data Samples Tests Reports _____